


Plat of Road No 418

I hereby certify that the foregoing is a correct plat of Road Survey No 418. for Umatilla County Oregon.

Jno. O. Arnold. Surveyor.

Township 1 S Range 32 E Wm

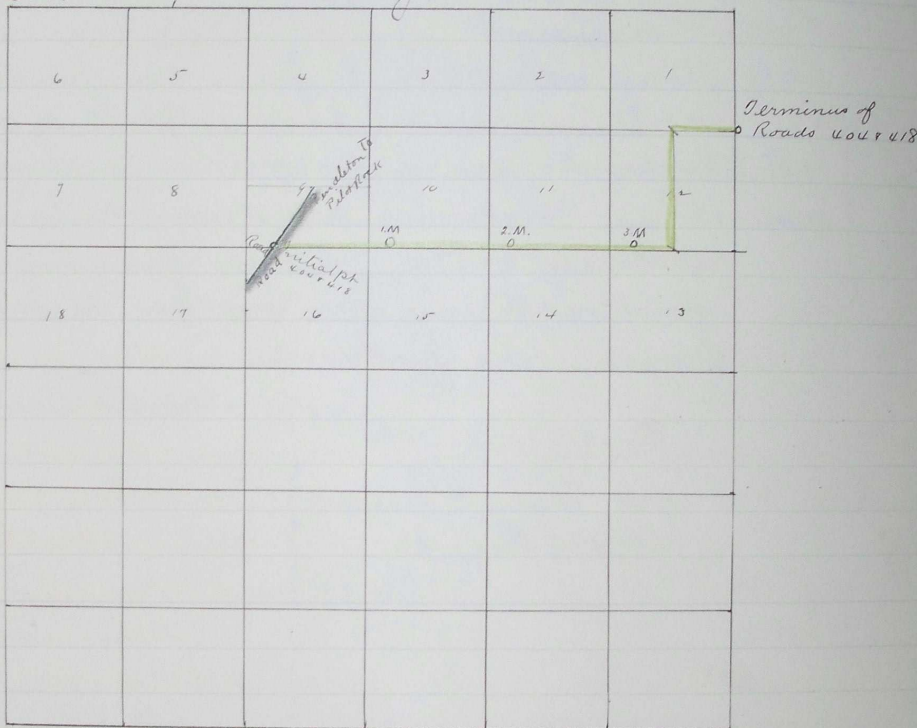

Filed May 3rd 1893
Wm Pierce
Clerk

1480