


Plat of Road Survey No 428

I hereby certify that the following is a correct plat of Road Survey No 428 for Umatilla County, Oregon.

Jno. C. Arnold, Surveyor.

Sp 4 MR 39 Town

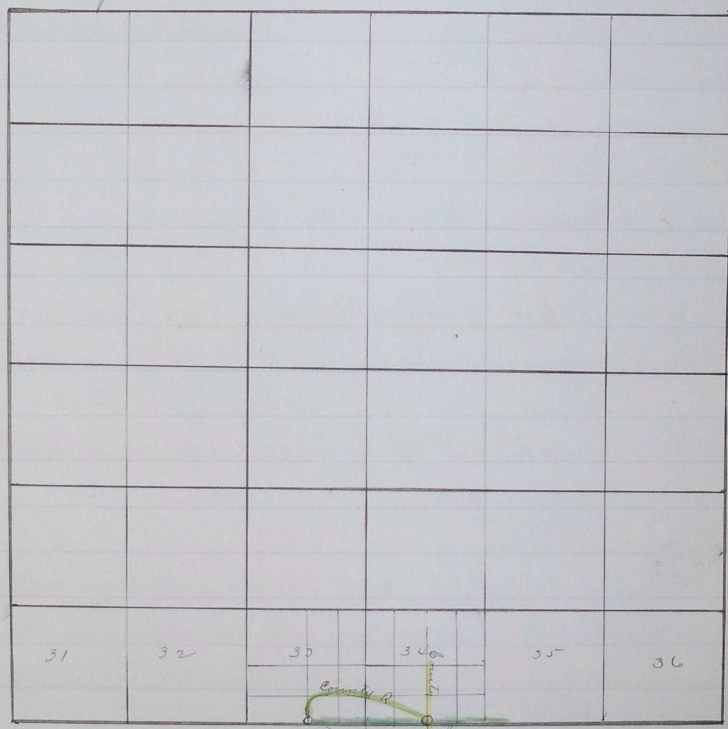

Filed July 12 "1893.
Wm Pierce ltk.

U 6 19