


Plat of County Road No 441, Umatilla Co Oregon

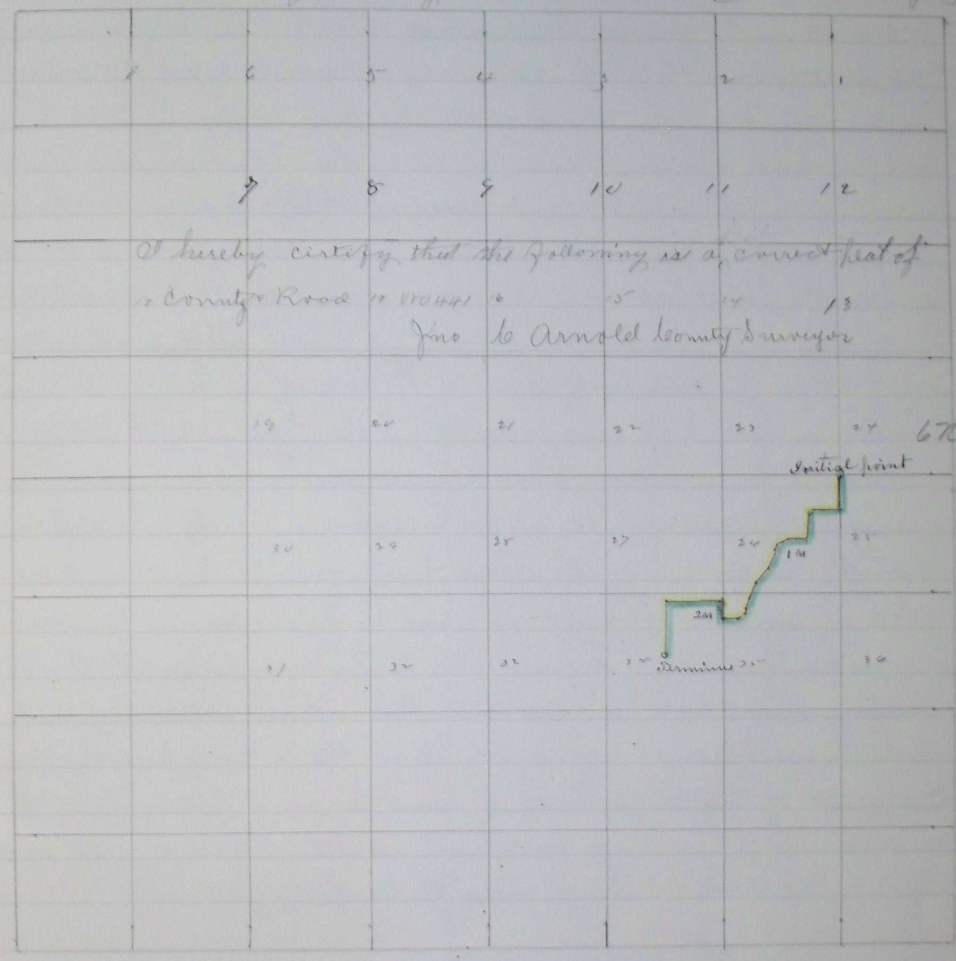

I hereby certify that the following is a correct plat of
County Road No 441
file to Arnold County Surveyor

67-34

Initial point

Remains

Filed June 30-1894
W M Pierce ^{clerk}
By C M Pierce
deputy

July 7 1894 J 184