


Township No 3 North Range 36 East WM

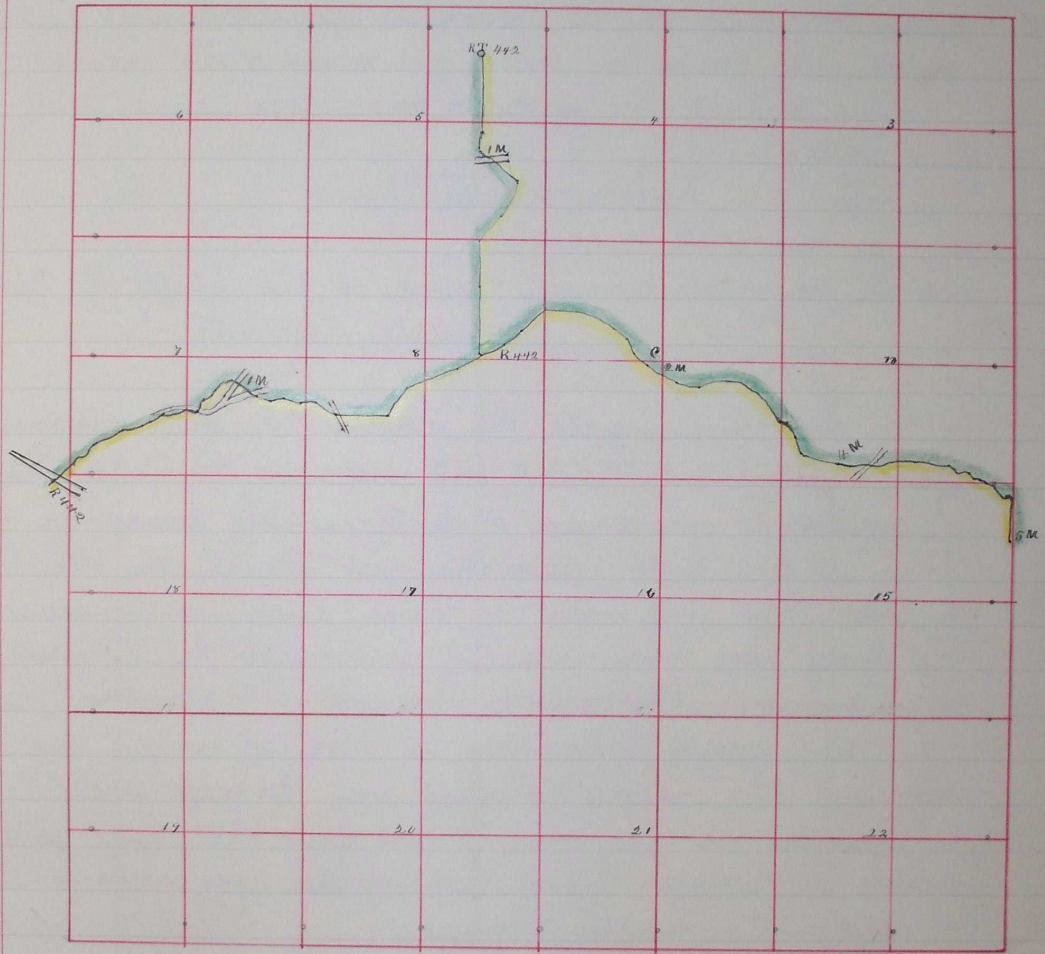

in 4 inches  
 d are cor =  
 yon

Sept 10 1894 J 205