

Set to the left marked Marked P J N° 425

I hereby certify that the above field notes are correct to the best of my belief

John W. Kimbrell,  
County Surveyor

ROAD No

455

Gr

To the

Ne

case

order

voyor

1895,

imp

man

dut

spe

mos

dec

Field

No 9

of St

of L

dite

100

4054


6081

219

20

are

De

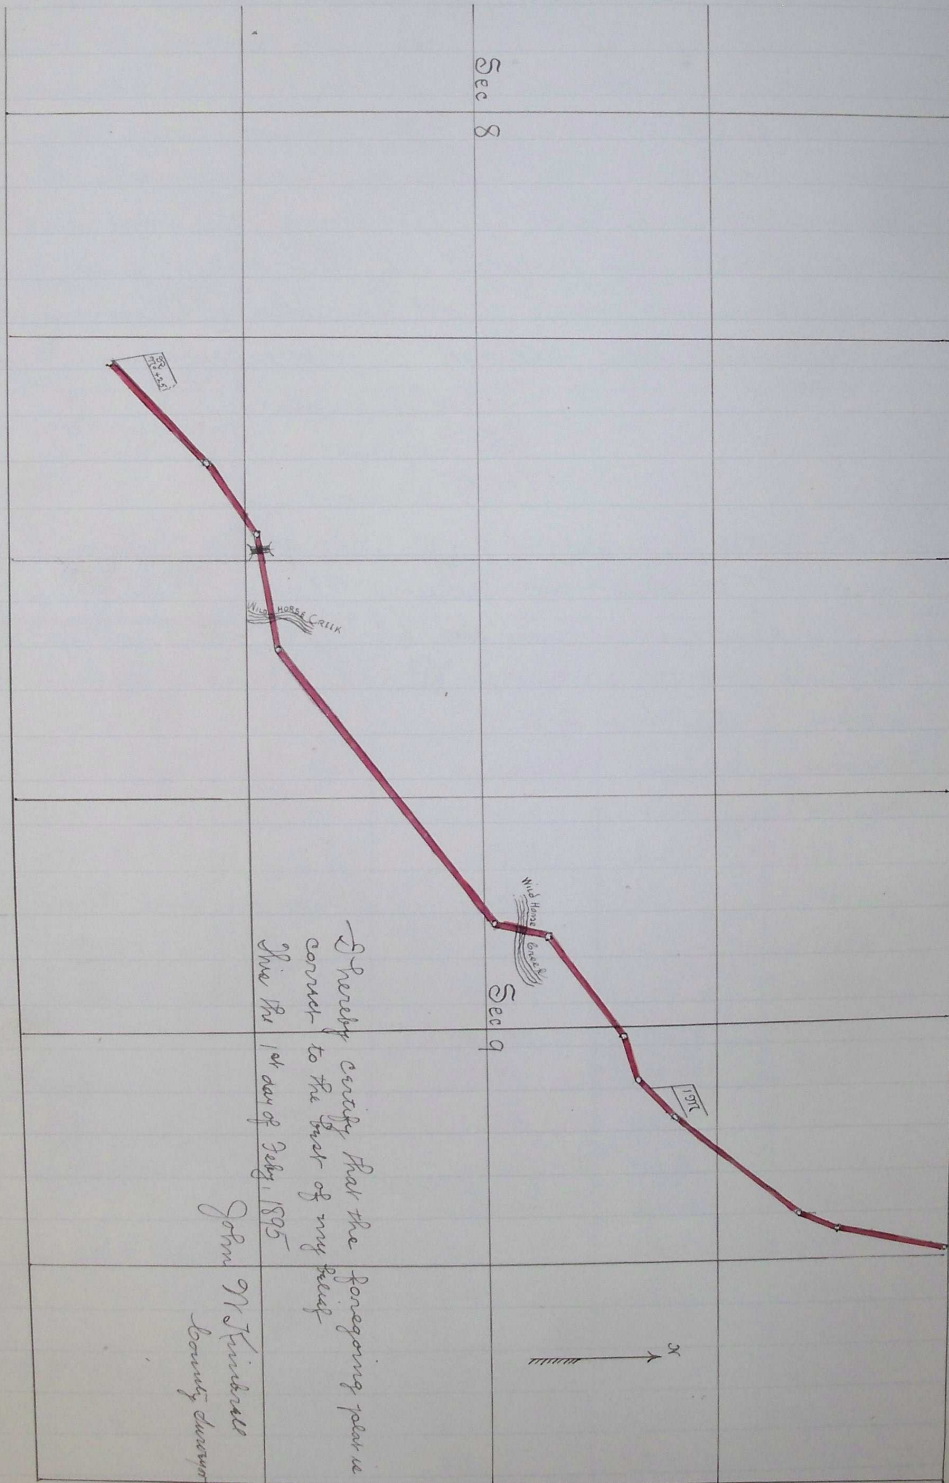


John W. Kimbrell  
County Surveyor