


Plan of Road No 482

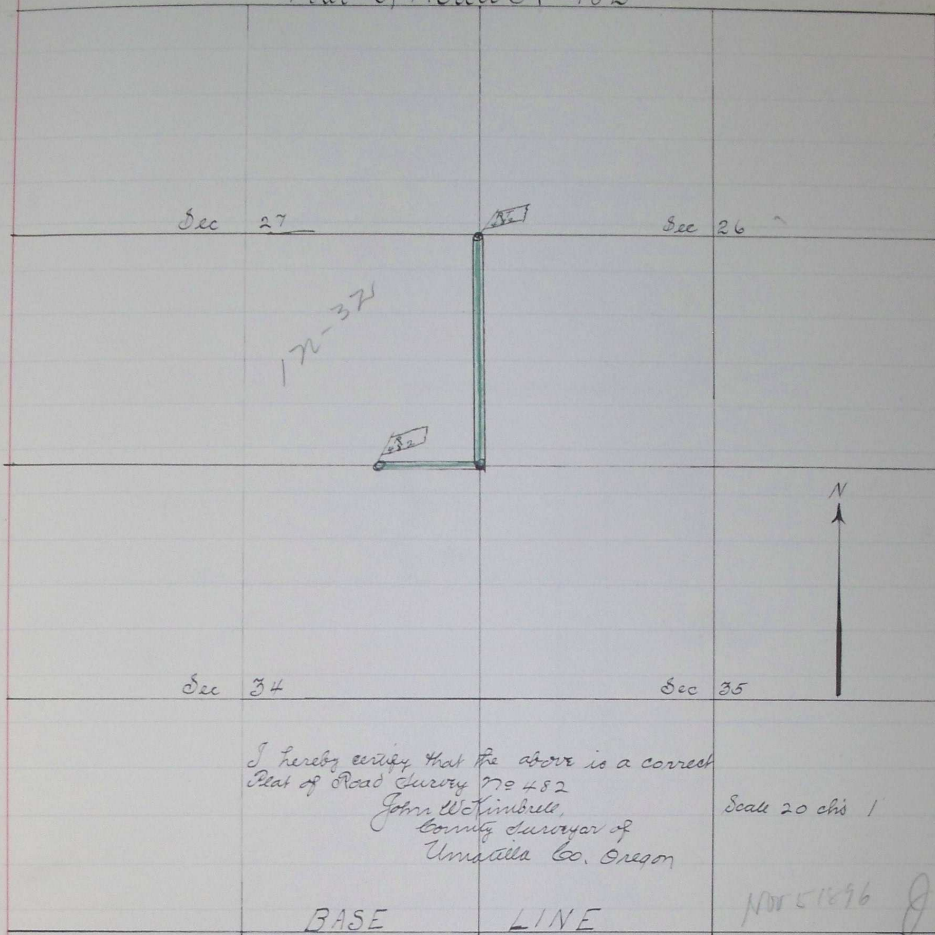

ROAD No

481

In the matter of Viewing Surveying and laying out County Road No 481

To the Honorable County Court of the State of Oregon for Umatilla County:

We the undersigned the Viewers heretofore appointed to view and locate Road No 481, submit the following report: Pursuant to an order of the Honorable Court we met John W. Kimbrell, surveyor at the house of H. F. Taylor on the 21st of Nov. 1896, and were by him each duly sworn to faithfully and impartially discharge the duties of our appointments.

We called to our aid Jack Diegert and Mat Erb, Chaimen, G. L. Christanson, marker, who were by the surveyor each duly sworn. We viewed, surveyed and located said road No 481, as specified in our order and find the route practicable and would most respectfully recommend the same be established as a public highway of Umatilla County, Oregon.

Robert Audspeth	} Viewers Road Survey No 481
Roll Oydrien	
John E. Herndon	