S 50° 3' E	4.35	80.00	Set stone 23×9×8 inches 30' to right of point
S 50° 3' E	47.59		∠ 84 Marked "12 M" built mound of stone
S 27° 20' E	6.95	54.54	∠ 85
S 46° 28' E	25.46	80.00	∠ Set stone 21×12×8 inches 30' to right of point
S 46° 28' E	21.25		∠ 86 Marked "13 M" built mound of stone.
S 32° E	18.13	39.38	∠ 87
S 31° E	16.20	55.58	∠ 88
S 39° 38' E	5.18	60.76	∠ 89
S 33° E	13.30	74.06	∠ 90
S 24° 5' E	5.94	80.00	∠ 91 a fir 16 inches diameter bears N 20° E 25 lks distant marked 14 M
S 30° 10' W	4.04		Terminus of road a point S 75° 15' W. 11.36 chains distant from the NE corner sec 30 in Township 2 South range 34 E W.M Set Stone 23×10×6 inches marked R.T. 491; dug pits and raised mound from which a fir 14 inches bears N 31° E 36 lks marked R T 491 B.T. a pine 6 " " S 89° W 13 " " R T 491 T B T

I hereby certify that the above is a correct transcript of Field Notes of County Road Survey № 491, as surveyed by me on the 3d, 4th and 5th days of August, 1897
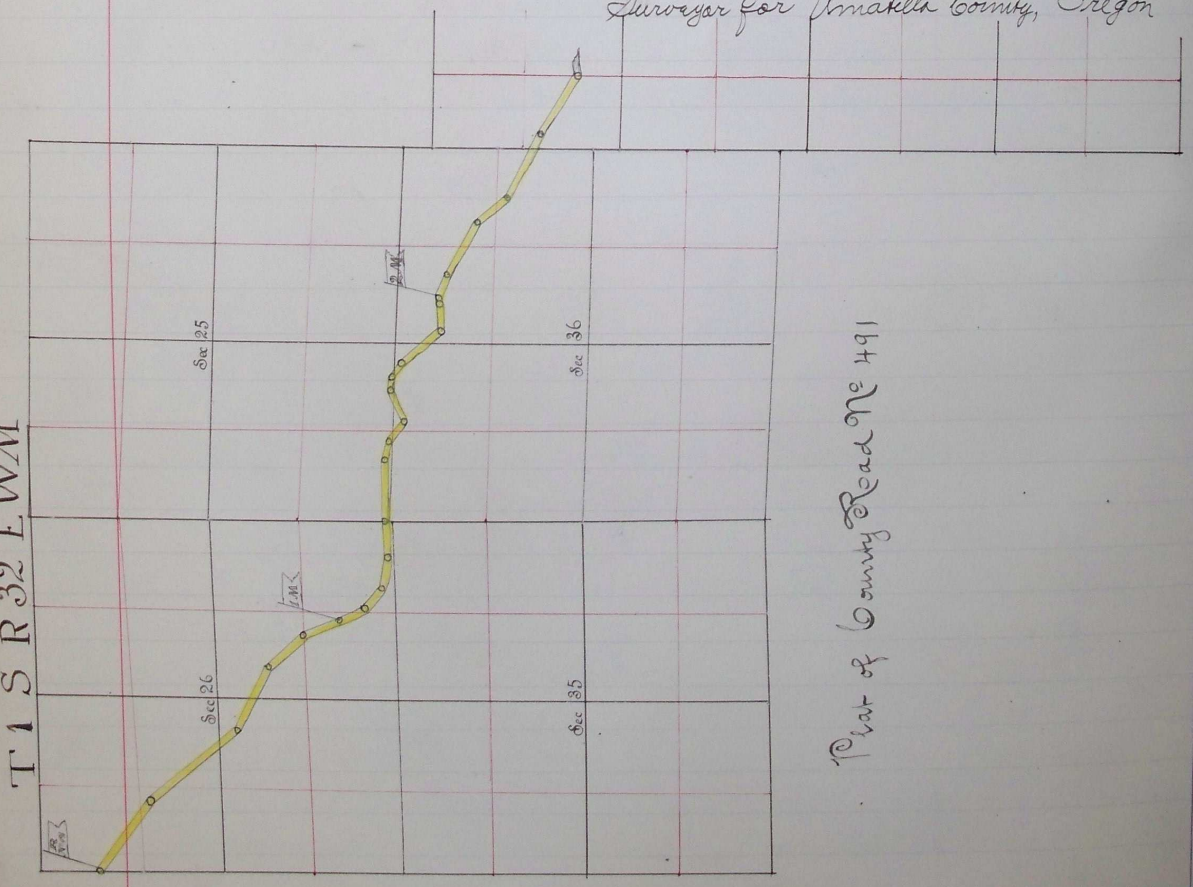
John W Kimbrell
Surveyor for Umatilla County, Oregon