


579

Plat of Road No. 579  
 In T. 6. N. R. 34. E. W. M.

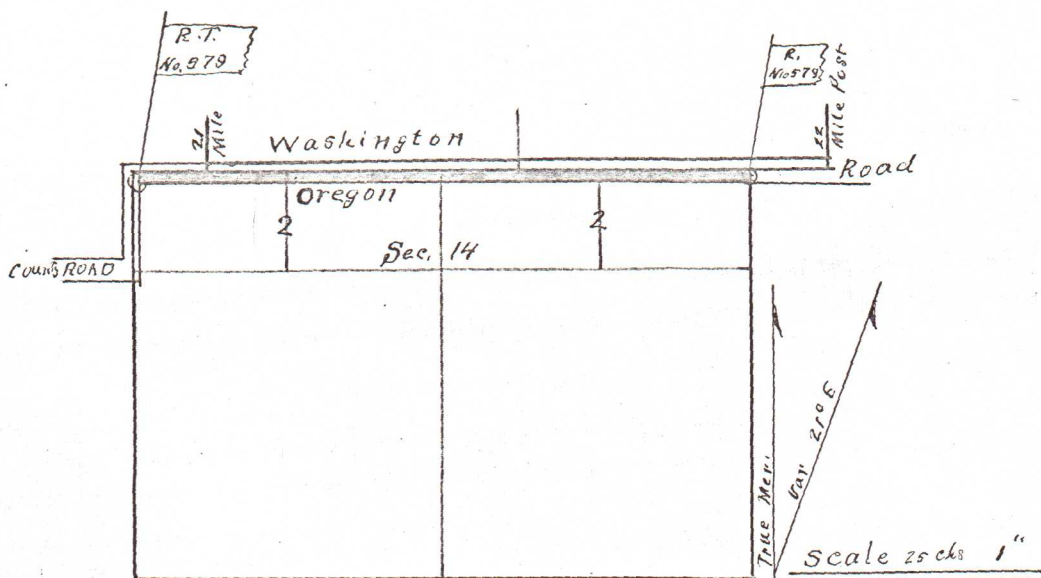

I hereby certify that the above is a correct  
 Plat of Road No 579 as surveyed by me  
 on the 11<sup>th</sup> day of December 1905

John W. Kimball County Surveyor  
 for Umatilla County Oregon