674

Plat of Road No. 674

T. 6. N. R. 35. E. W. M.

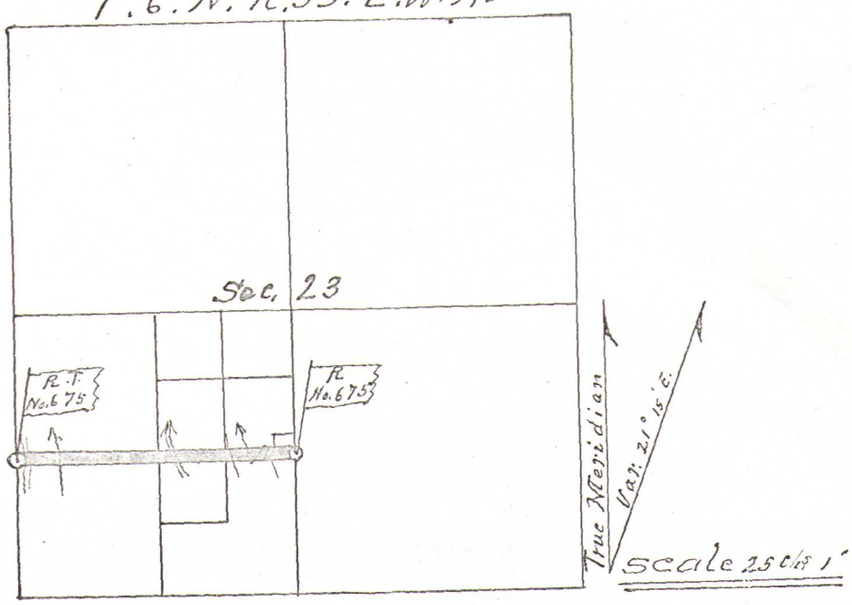

and terminating as follows, to-wit: