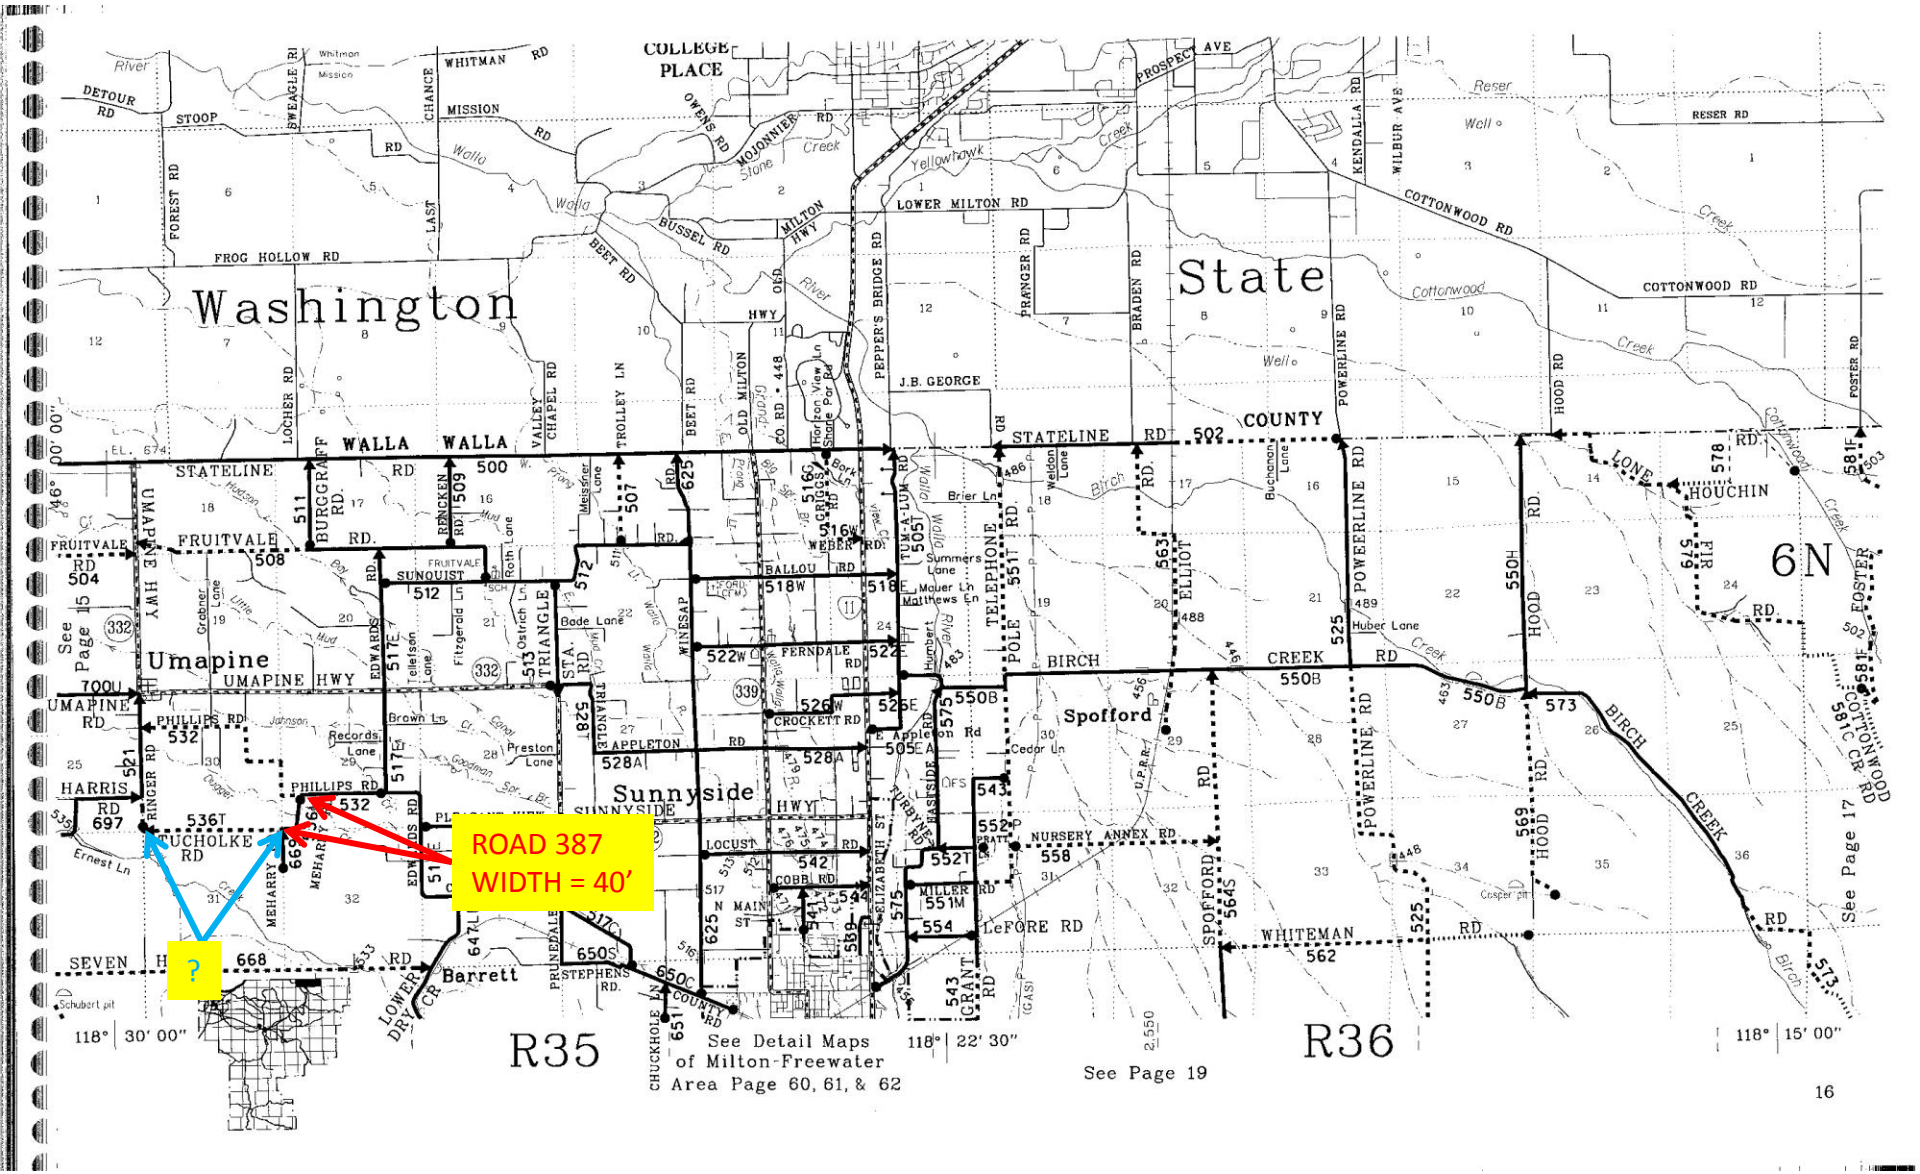
ROAD 387
WIDTH = 40'
?
Washington
State
COUNTY
WALLA WALLA
COLLEGE PLACE
Umapine
Sunnyside
Spofford
Barrett
HOUCHIN
R35
R36
6N
See Page 15
See Page 17
See Page 19
See Detail Maps of Milton-Freewater Area Page 60, 61, & 62
118° 30' 00"
118° 22' 30"
118° 15' 00"
46° 00' 00"
16