


ROAD 442
WIDTH = 40'

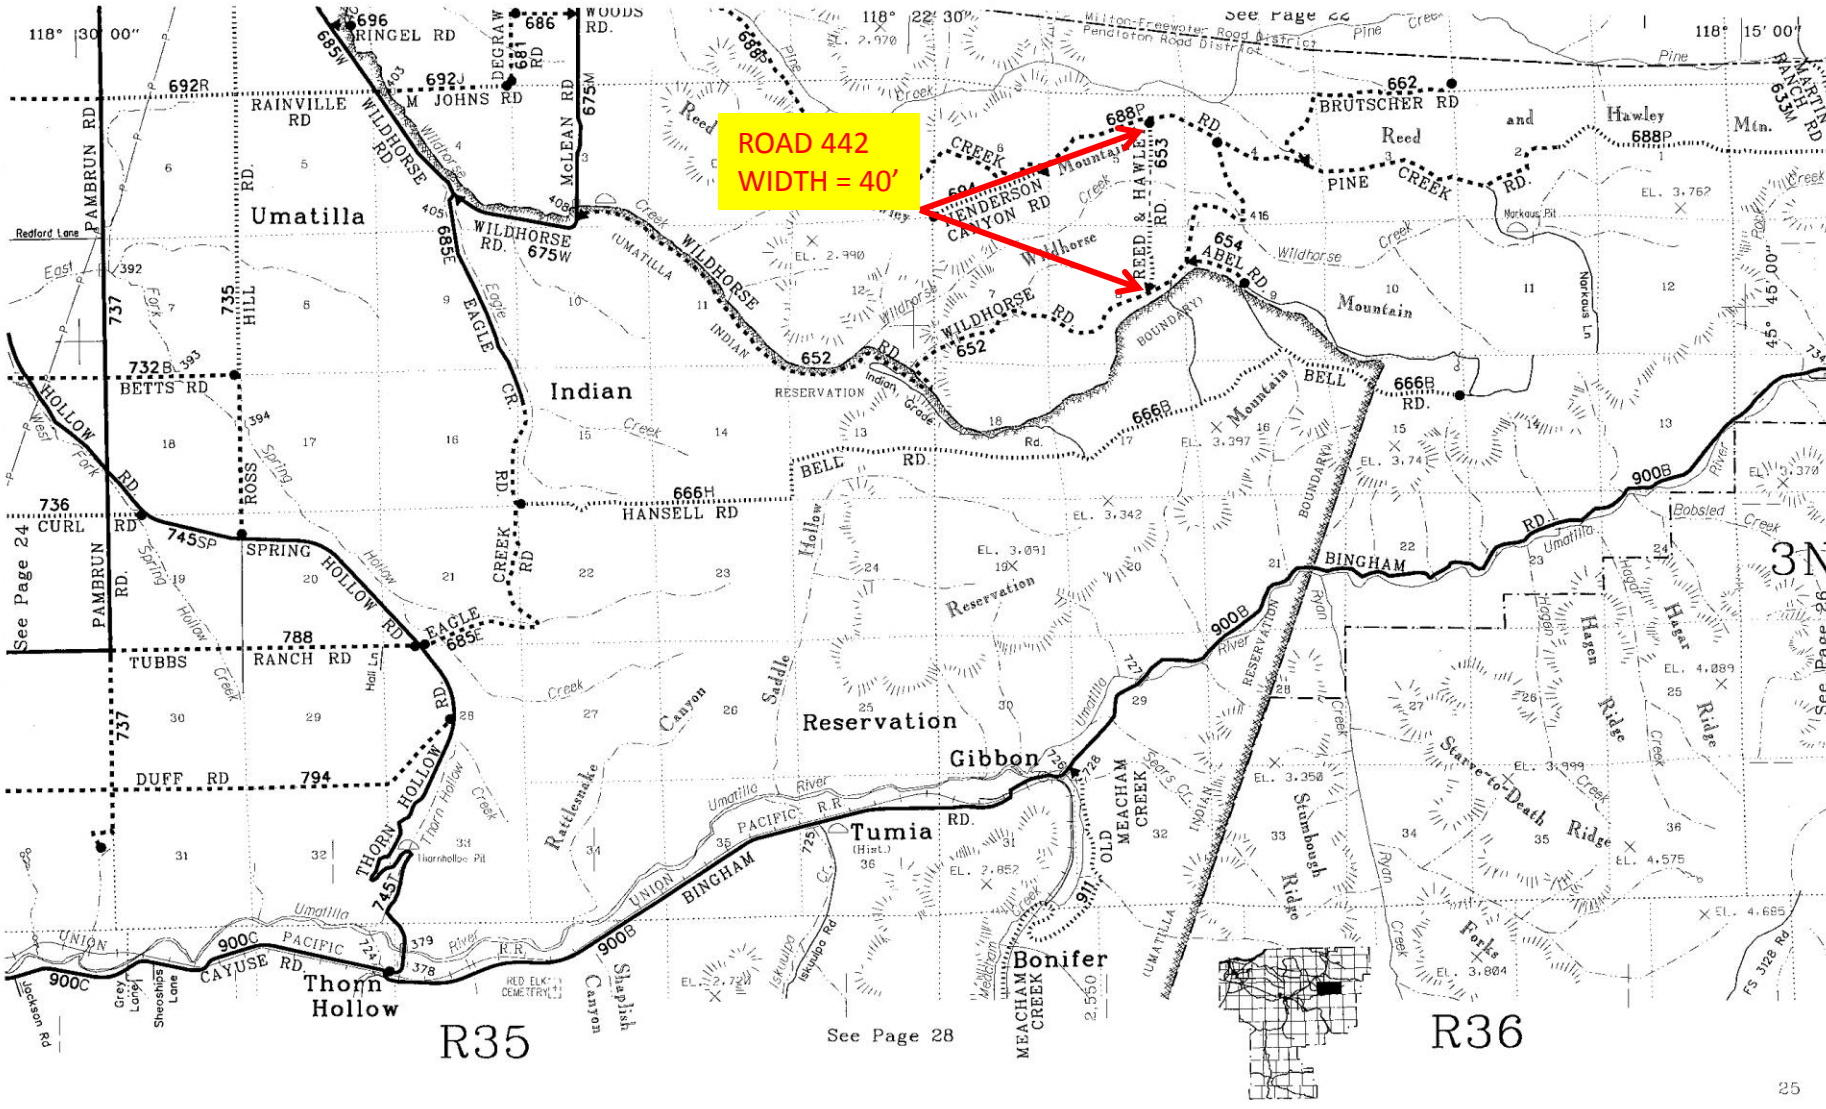

See Page 28