

133

North


133

T4N R34E

T4N R35E

West

East

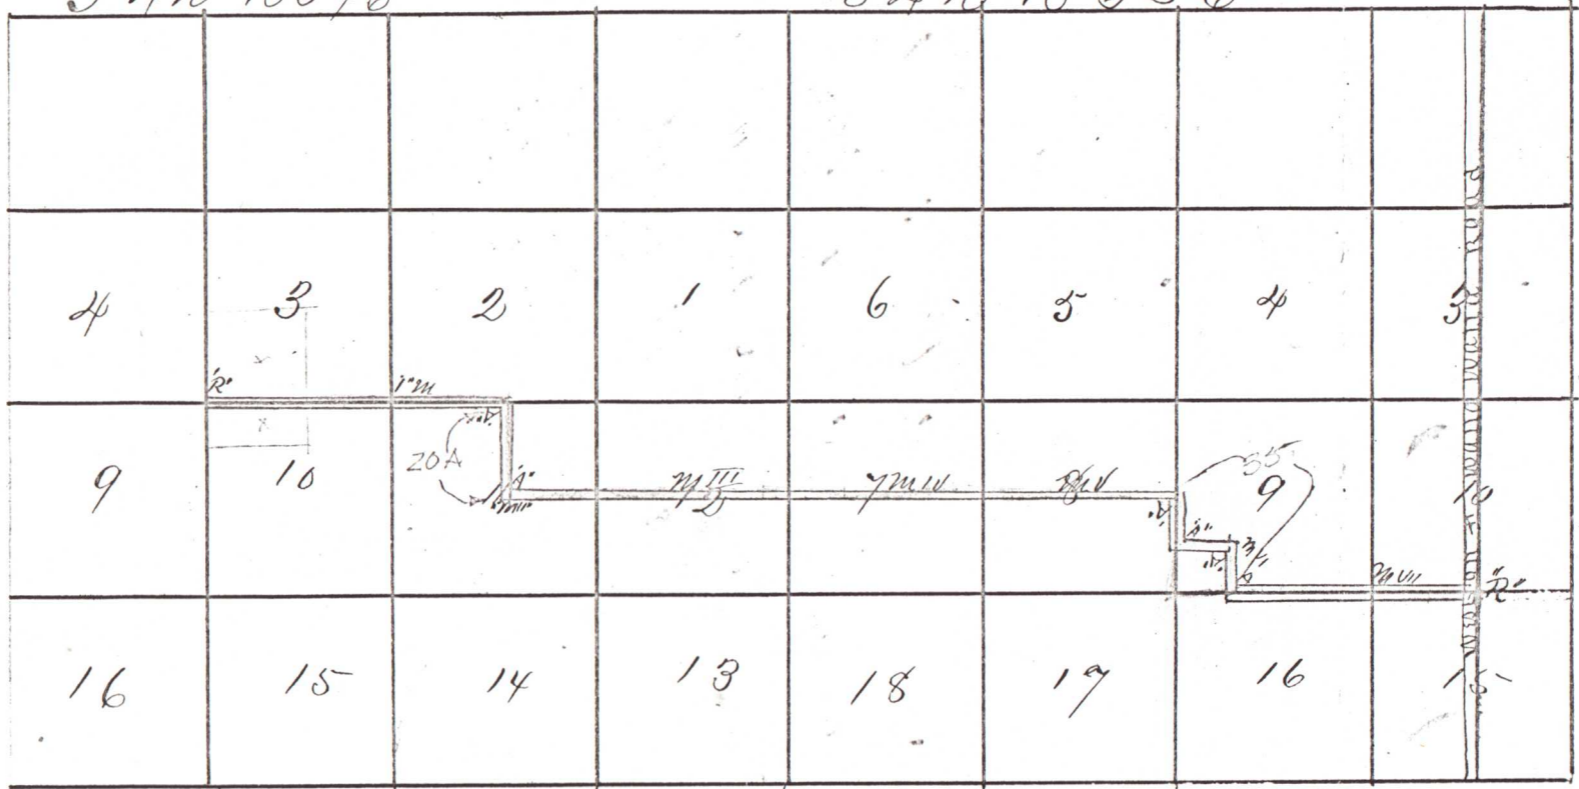

South

Plat of Road from NW Cor of Sec 10 T4N R34E  
 To 1/4 Post on W line of Sec 15 T4N R35E  
 Scale 80 chains to 1 inch  
 J. H. Barry  
 Co Surveyor