0104 385 Geo. D. Barnard & Co., Printers, Lithographers, Stationers and BlankBook Mak... St. Louis.

TOWNSHIP SCALE PLAT.

Township 4 North. Range 35 East.

36	31	32	33	34	35	36	31
1	6	5	4	3	2	1	6
12	7	8	9	10	11	12	7
13	18	17	16	15	14	13	18
24	19	20	21	22	23	24	19
25	30	29	28	27	26	25	30
36	31	32	33	34	35	36	31
1	6	5	4	3	2	1	6
10	11	12	7				
15	14	13	18				

Plat of Road Survey No. 385.

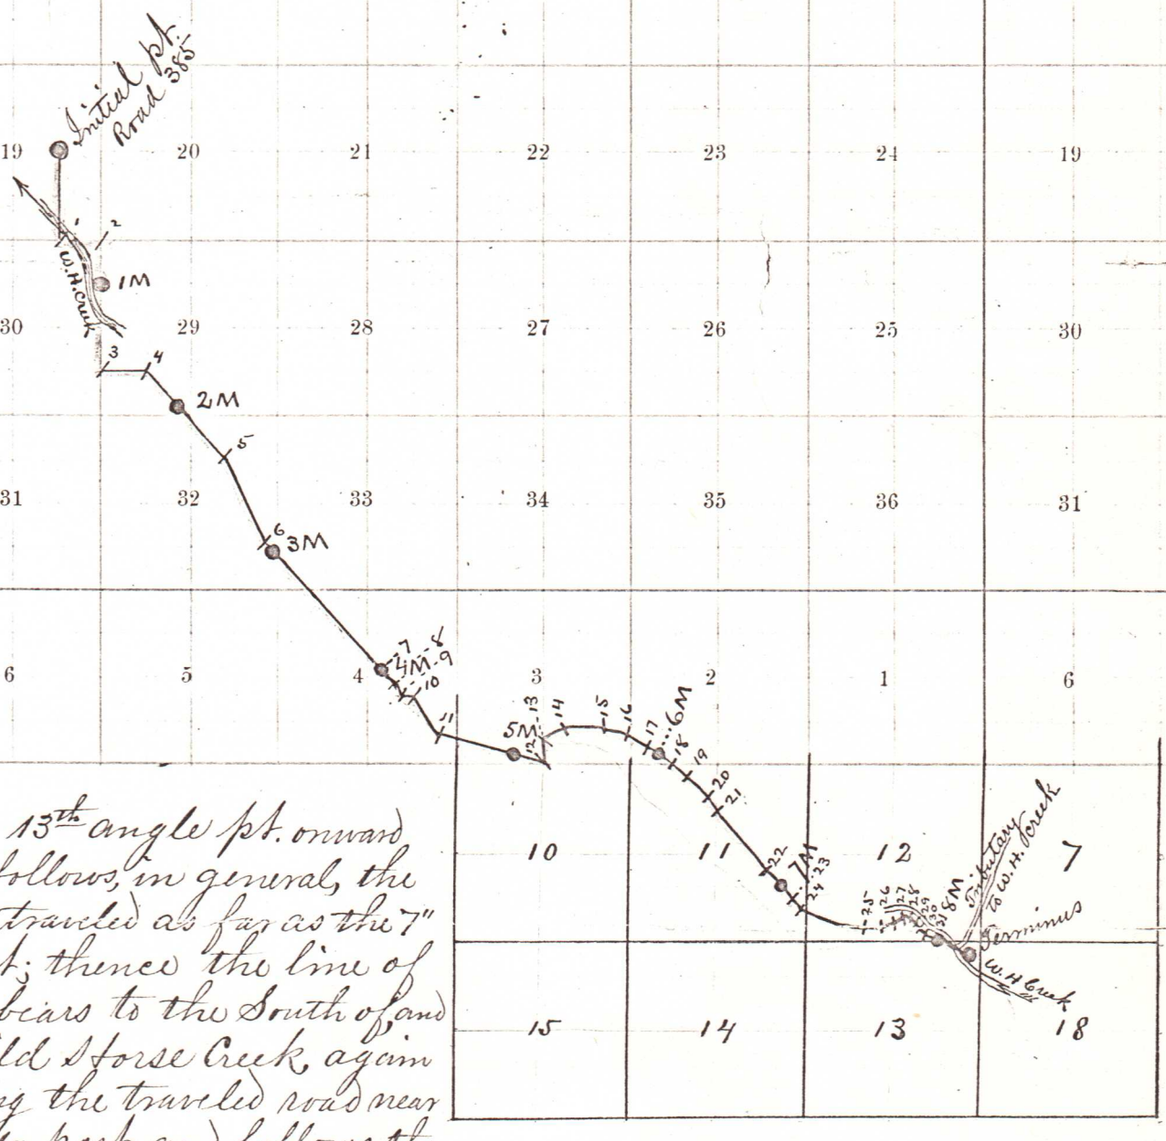

From the 13th angle pt. onward the road follows, in general, the road now traveled as far as the 7th mile post; thence the line of the road bears to the South of and leaves Wild Horse Creek, again intersecting the traveled road near the 8th mile post, and follows the traveled road onward to termimus.

I hereby certify that the foregoing is a correct plat of Road Survey No. 385 for Umatilla County, Oregon.

Jno. C. Arnold, County Surveyor.