



ROAD 405
WIDTH = 60'

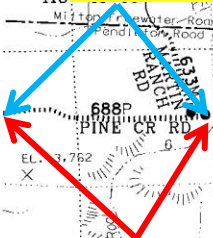

ROAD 337
WIDTH = 40'

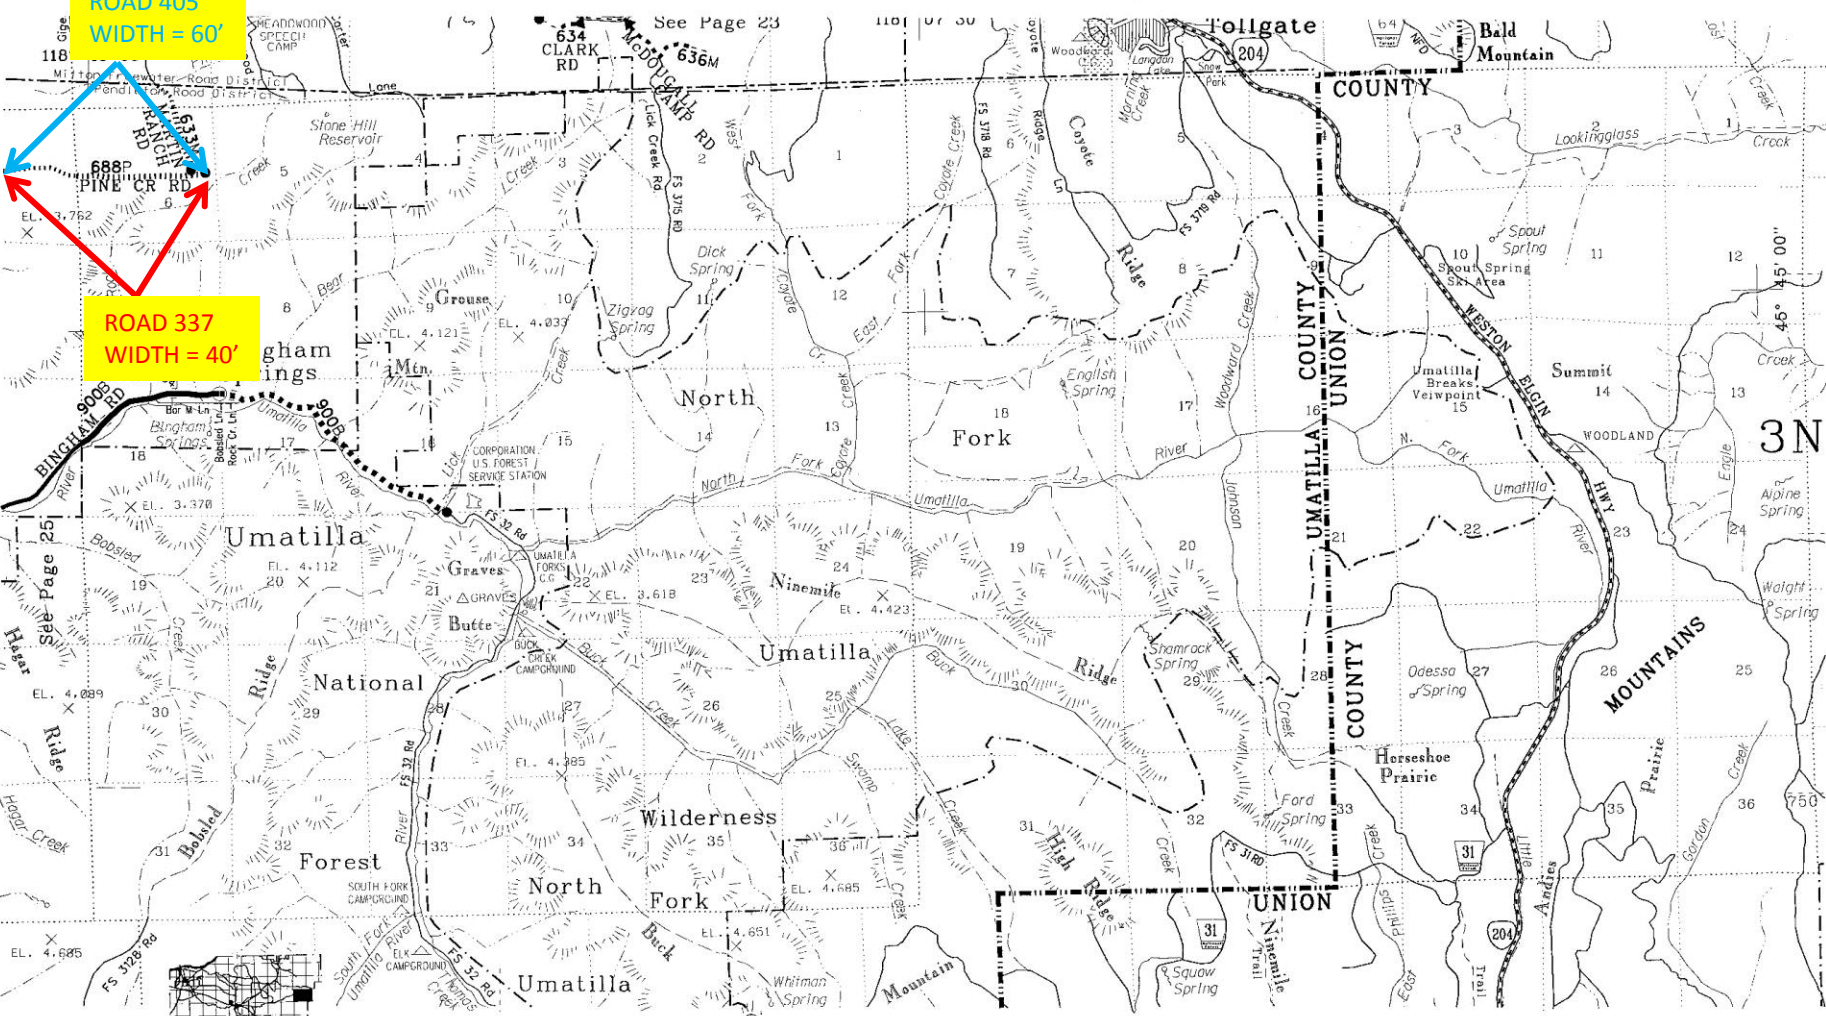

R37

See Page 29

R38