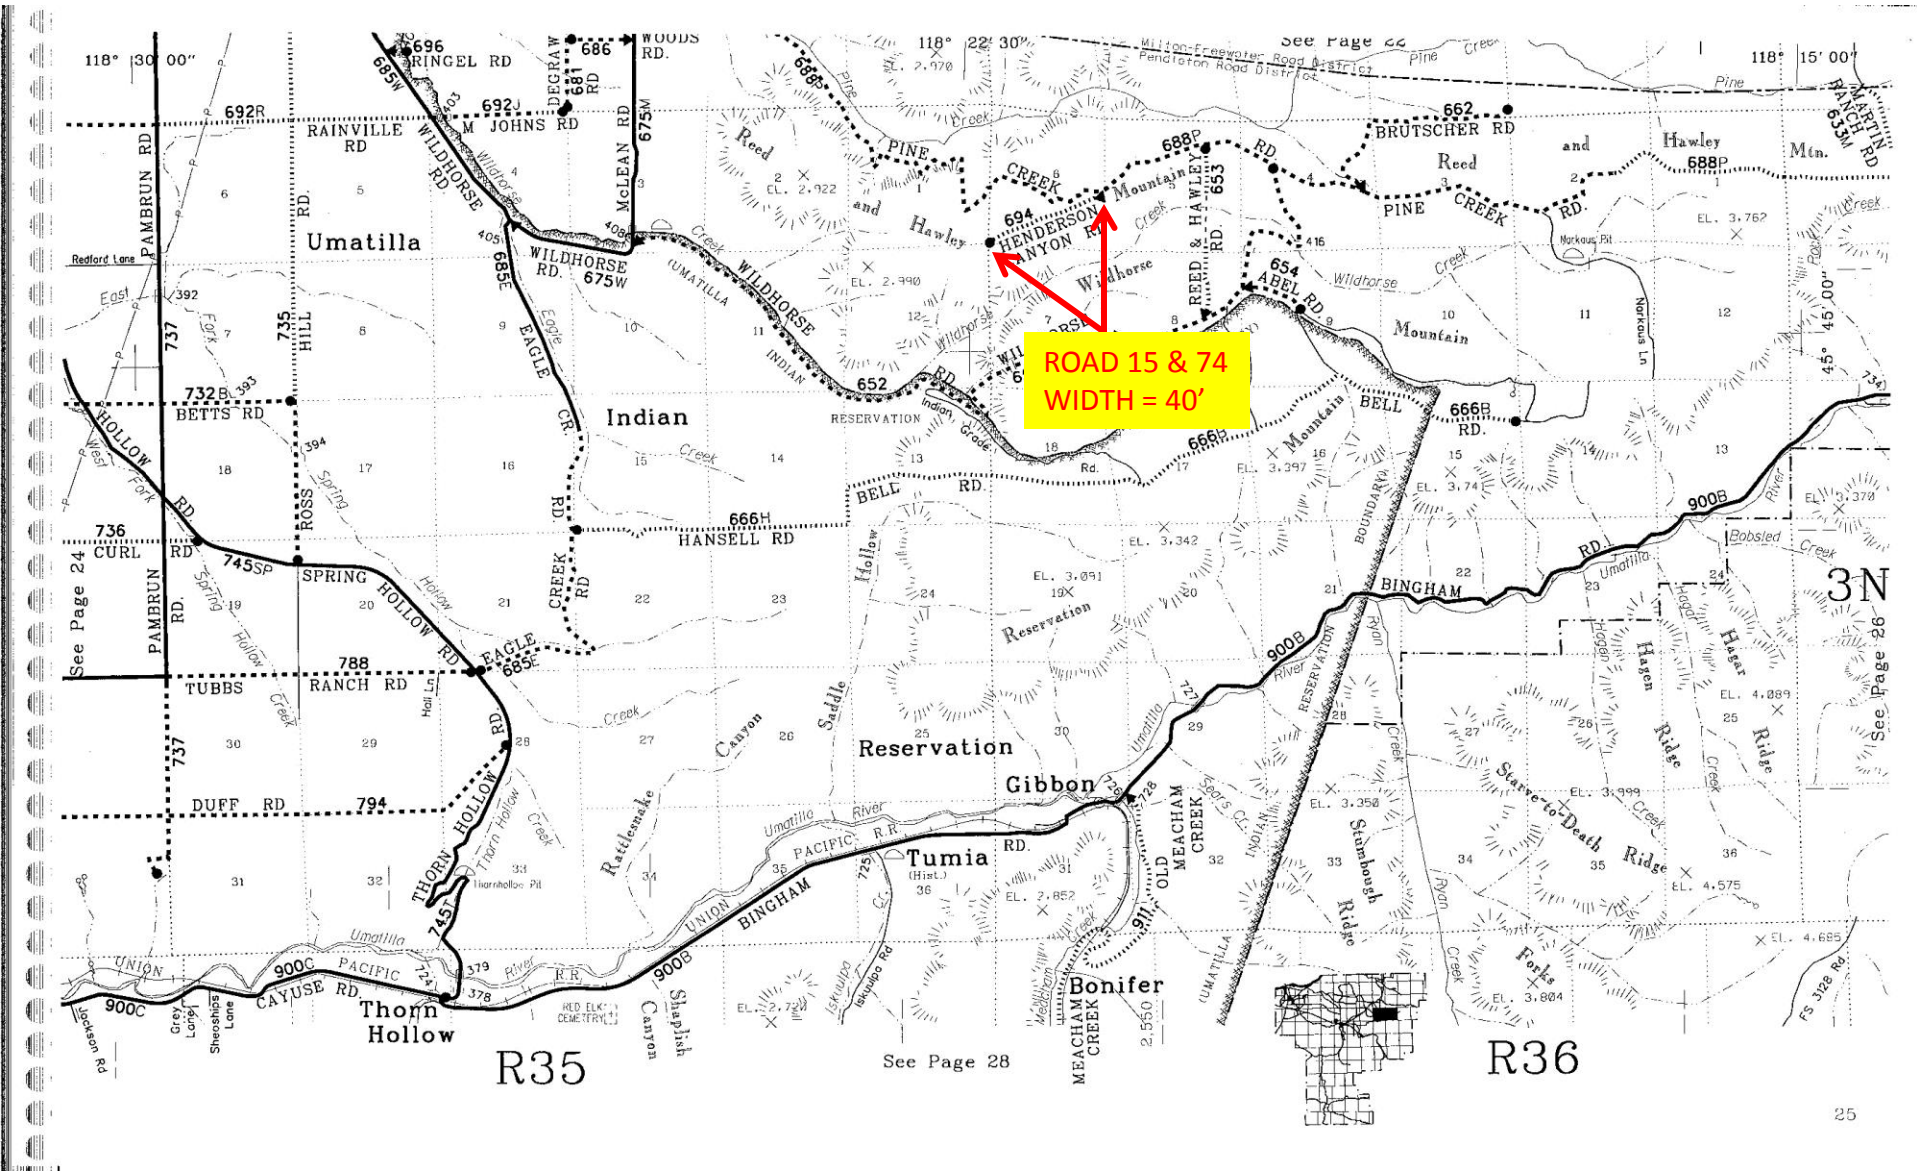
ROAD 15 & 74
WIDTH = 40'
Umatilla
Indian
Reservation
Gibbon
Tumia
Bonifer
Thorn Hollow
R35
R36
3N
See Page 24
See Page 26
See Page 28
See Page 22
PAMBRUN RD
RAINVILLE RD
WILDHORSE RD
McLEAN RD
DEGRAW RD
WOODS RD
M JOHNS RD
RINGEL RD
EAGLE CR. RD
HILL RD
BETTS RD
CURL RD
SPRING HOLLOW RD
TUBBS RANCH RD
DUFF RD
THORN HOLLOW RD
CAYUSE RD
HANSELL RD
CREEK RD
ROSS RD
HENDERSON CANYON RD
REED & HAWLEY RD
BRUTSCHER RD
PINE CREEK RD
ABEL RD
BELL RD
BINGHAM RD
OLD MEACHAM CREEK RD
MARTIN RANCH RD
Pambrun
Wildhorse Creek
Eagle Fork
Spring Hollow
Thorn Hollow Creek
Rattlesnake Canyon
Saddle Hollow
Indian Grave Rd
Umatilla River
Pine Creek
Reed and Hawley Mtn.
Mountain
Bobsled Creek
Hagen Ridge
Starve-to-Death Ridge
Scarbough Ridge
Forks
Meacham Creek
Shaplish Canyon
Isqulpo Rd
Jackson Rd
Grey Lane
Sheoships Lane
Redford Lane
Norkaus Pit
Thornhollow Pit
RED ELK CEMETERY
Union Pacific R.R.
Milton-Freewater Road District
Pendleton Road District
RESERVATION
BOUNDARY
118° 30' 00"
118° 22' 30"
118° 15' 00"
45° 45' 00"
692R
692J
696
686
681
685W
675M
688P
694
653
662
654
666B
666H
652
737
735
732B
736
745SP
788
794
745
900B
900C
911
725
728
734
EL. 2,970
EL. 2,922
EL. 2,990
EL. 3,762
EL. 3,397
EL. 3,741
EL. 3,342
EL. 3,091
EL. 4,089
EL. 3,999
EL. 3,350
EL. 4,575
EL. 4,685
EL. 3,804
EL. 2,852
EL. 2,722
2,550
25