


UMATILLA COUNTY OREGON
COUNTY ENGINEER'S OFFICE
GERKING FLAT ROAD
CONSTRUCTED LINE

SCALE 1 IN.=400FT.

MAY 1929




22

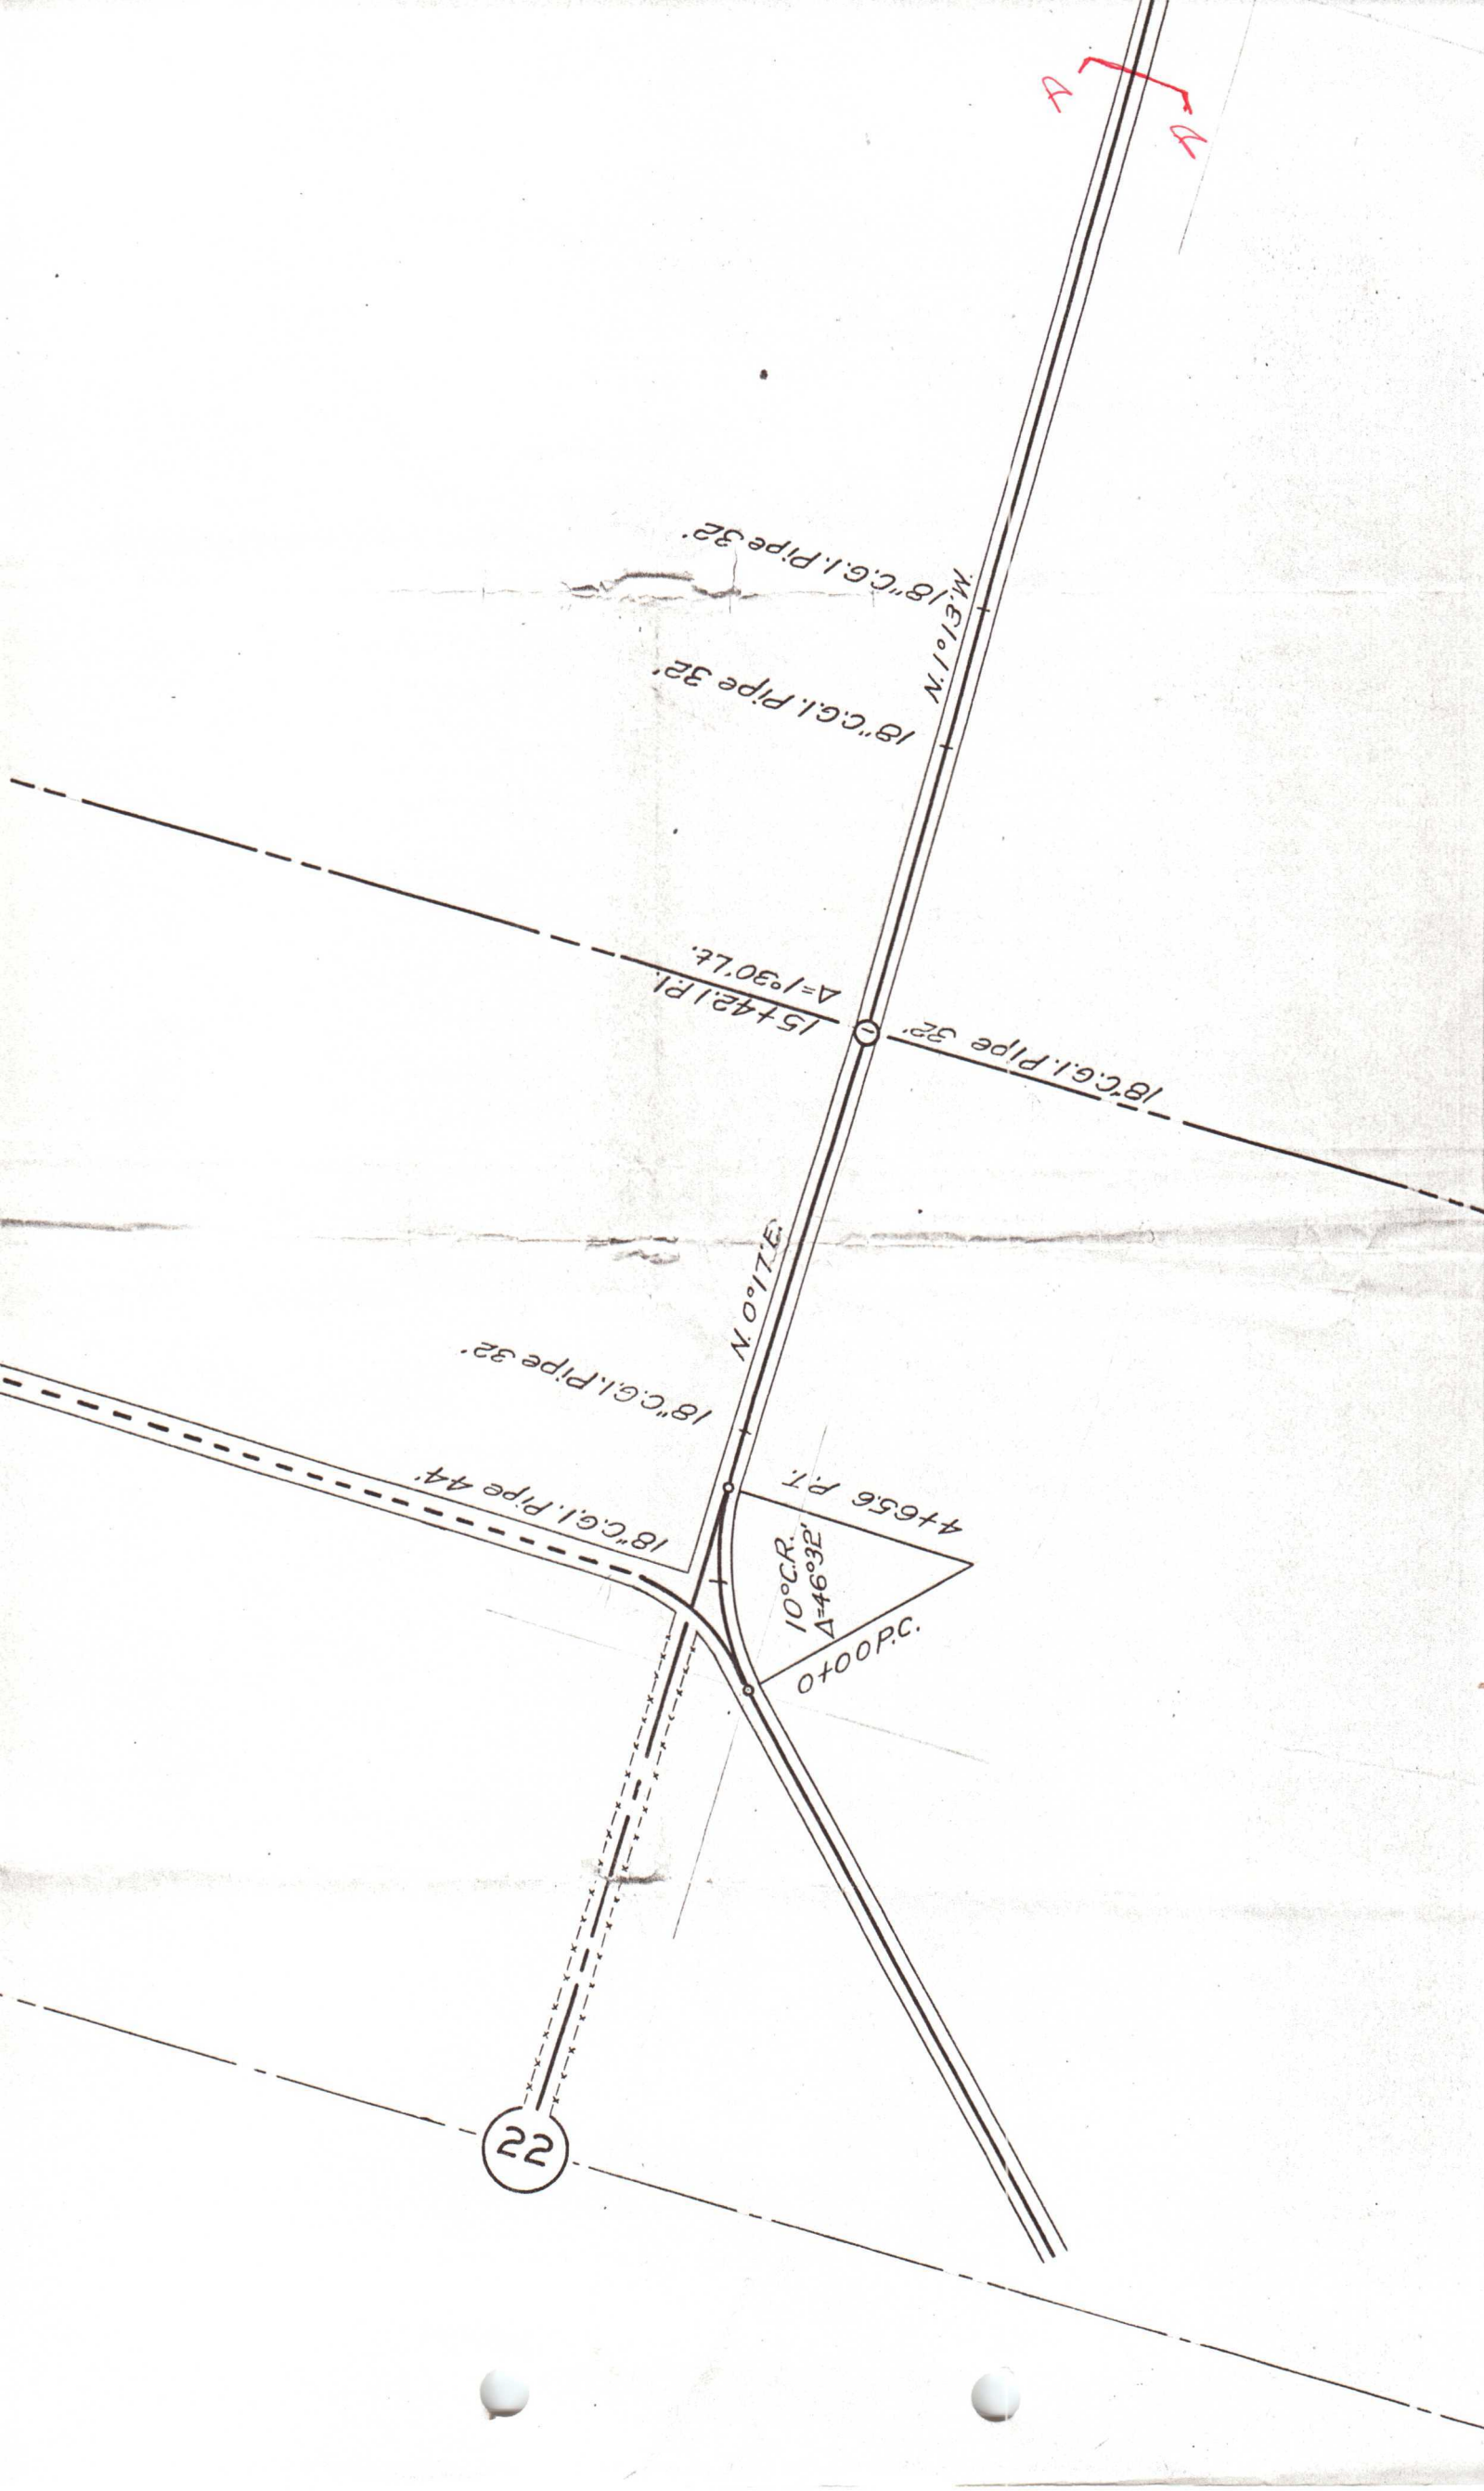



18" C.G.I. Pipe 32'

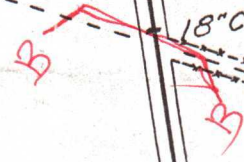

12" C.G.I. Pipe 30'

N. 26° 01' W.

36" C.G.I. Pipe 36'

12" C.G.I. Pipe 32'

12" C.G.I. Pipe 32'

EQUATION

59+90.0 P.O.T. =
59+85.0 P.T. =

49 C.L.
Δ = 124° 48'

53+65.0 P.C.

12" C.G.I. Pipe

1" Pipe 32'


24" C.G.I. Pipe 32'


41+91.4 P.O.T.

5-1

18" C.G.I. Pipe 32'



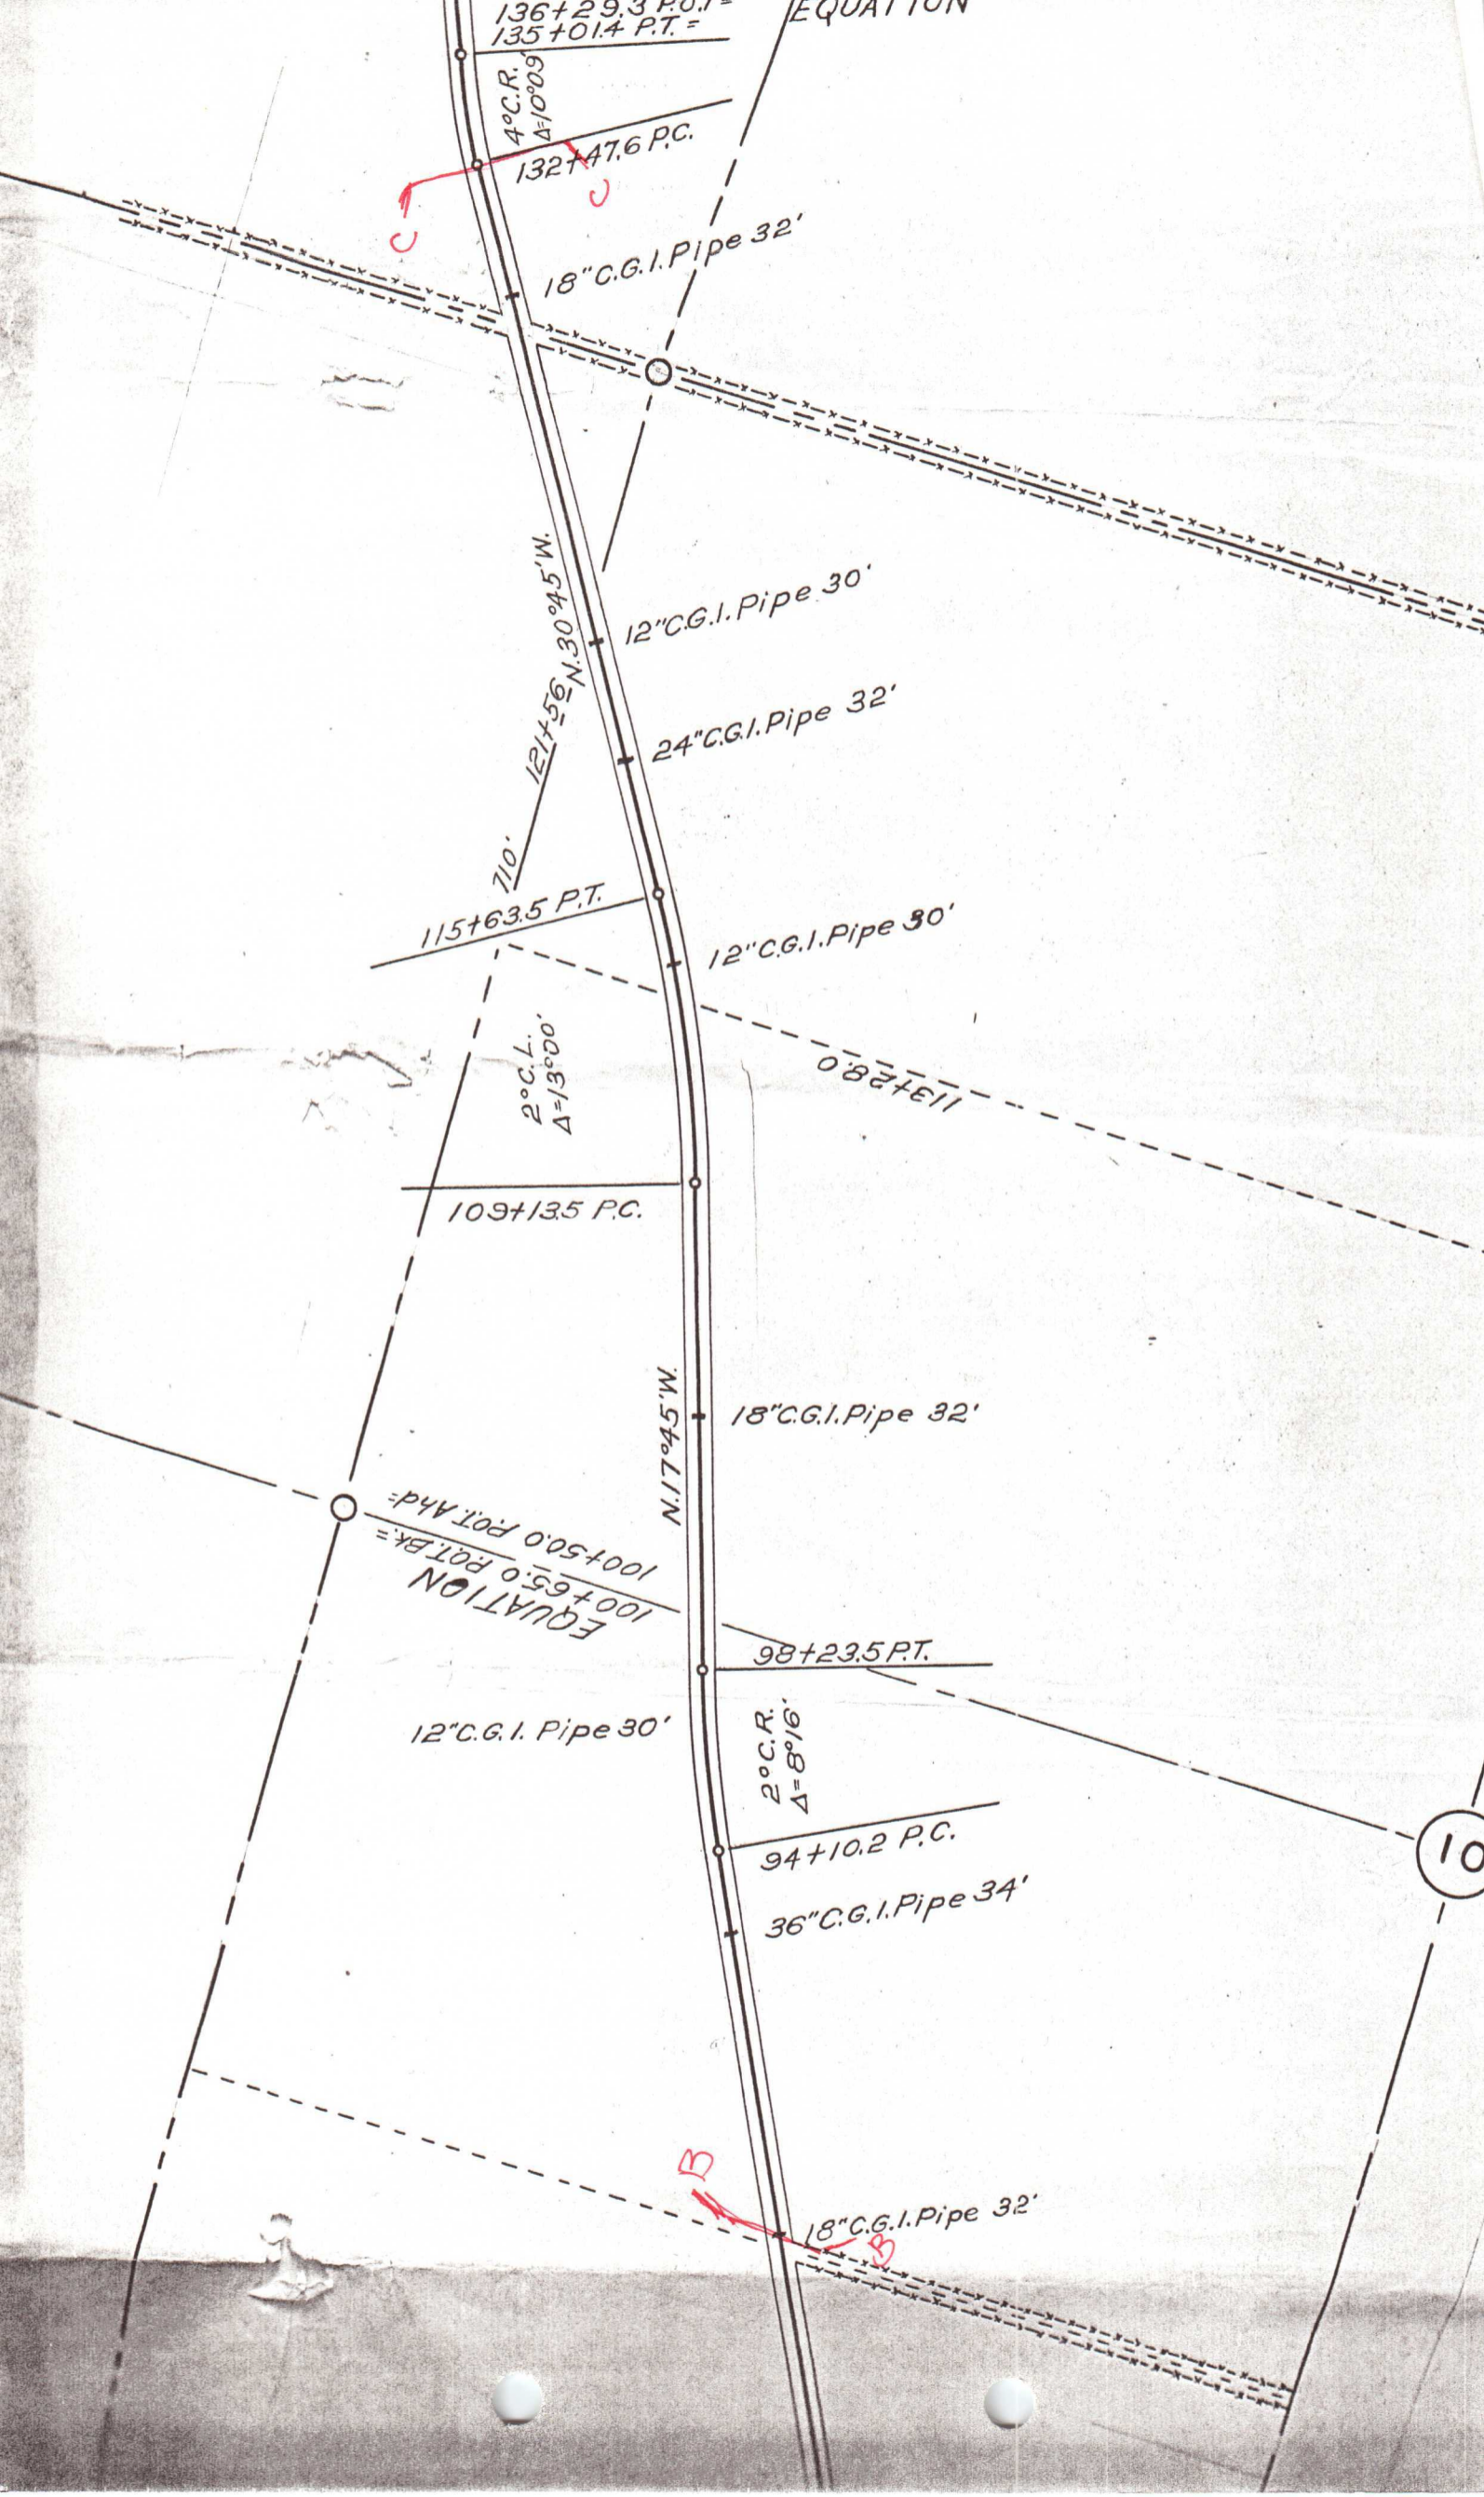

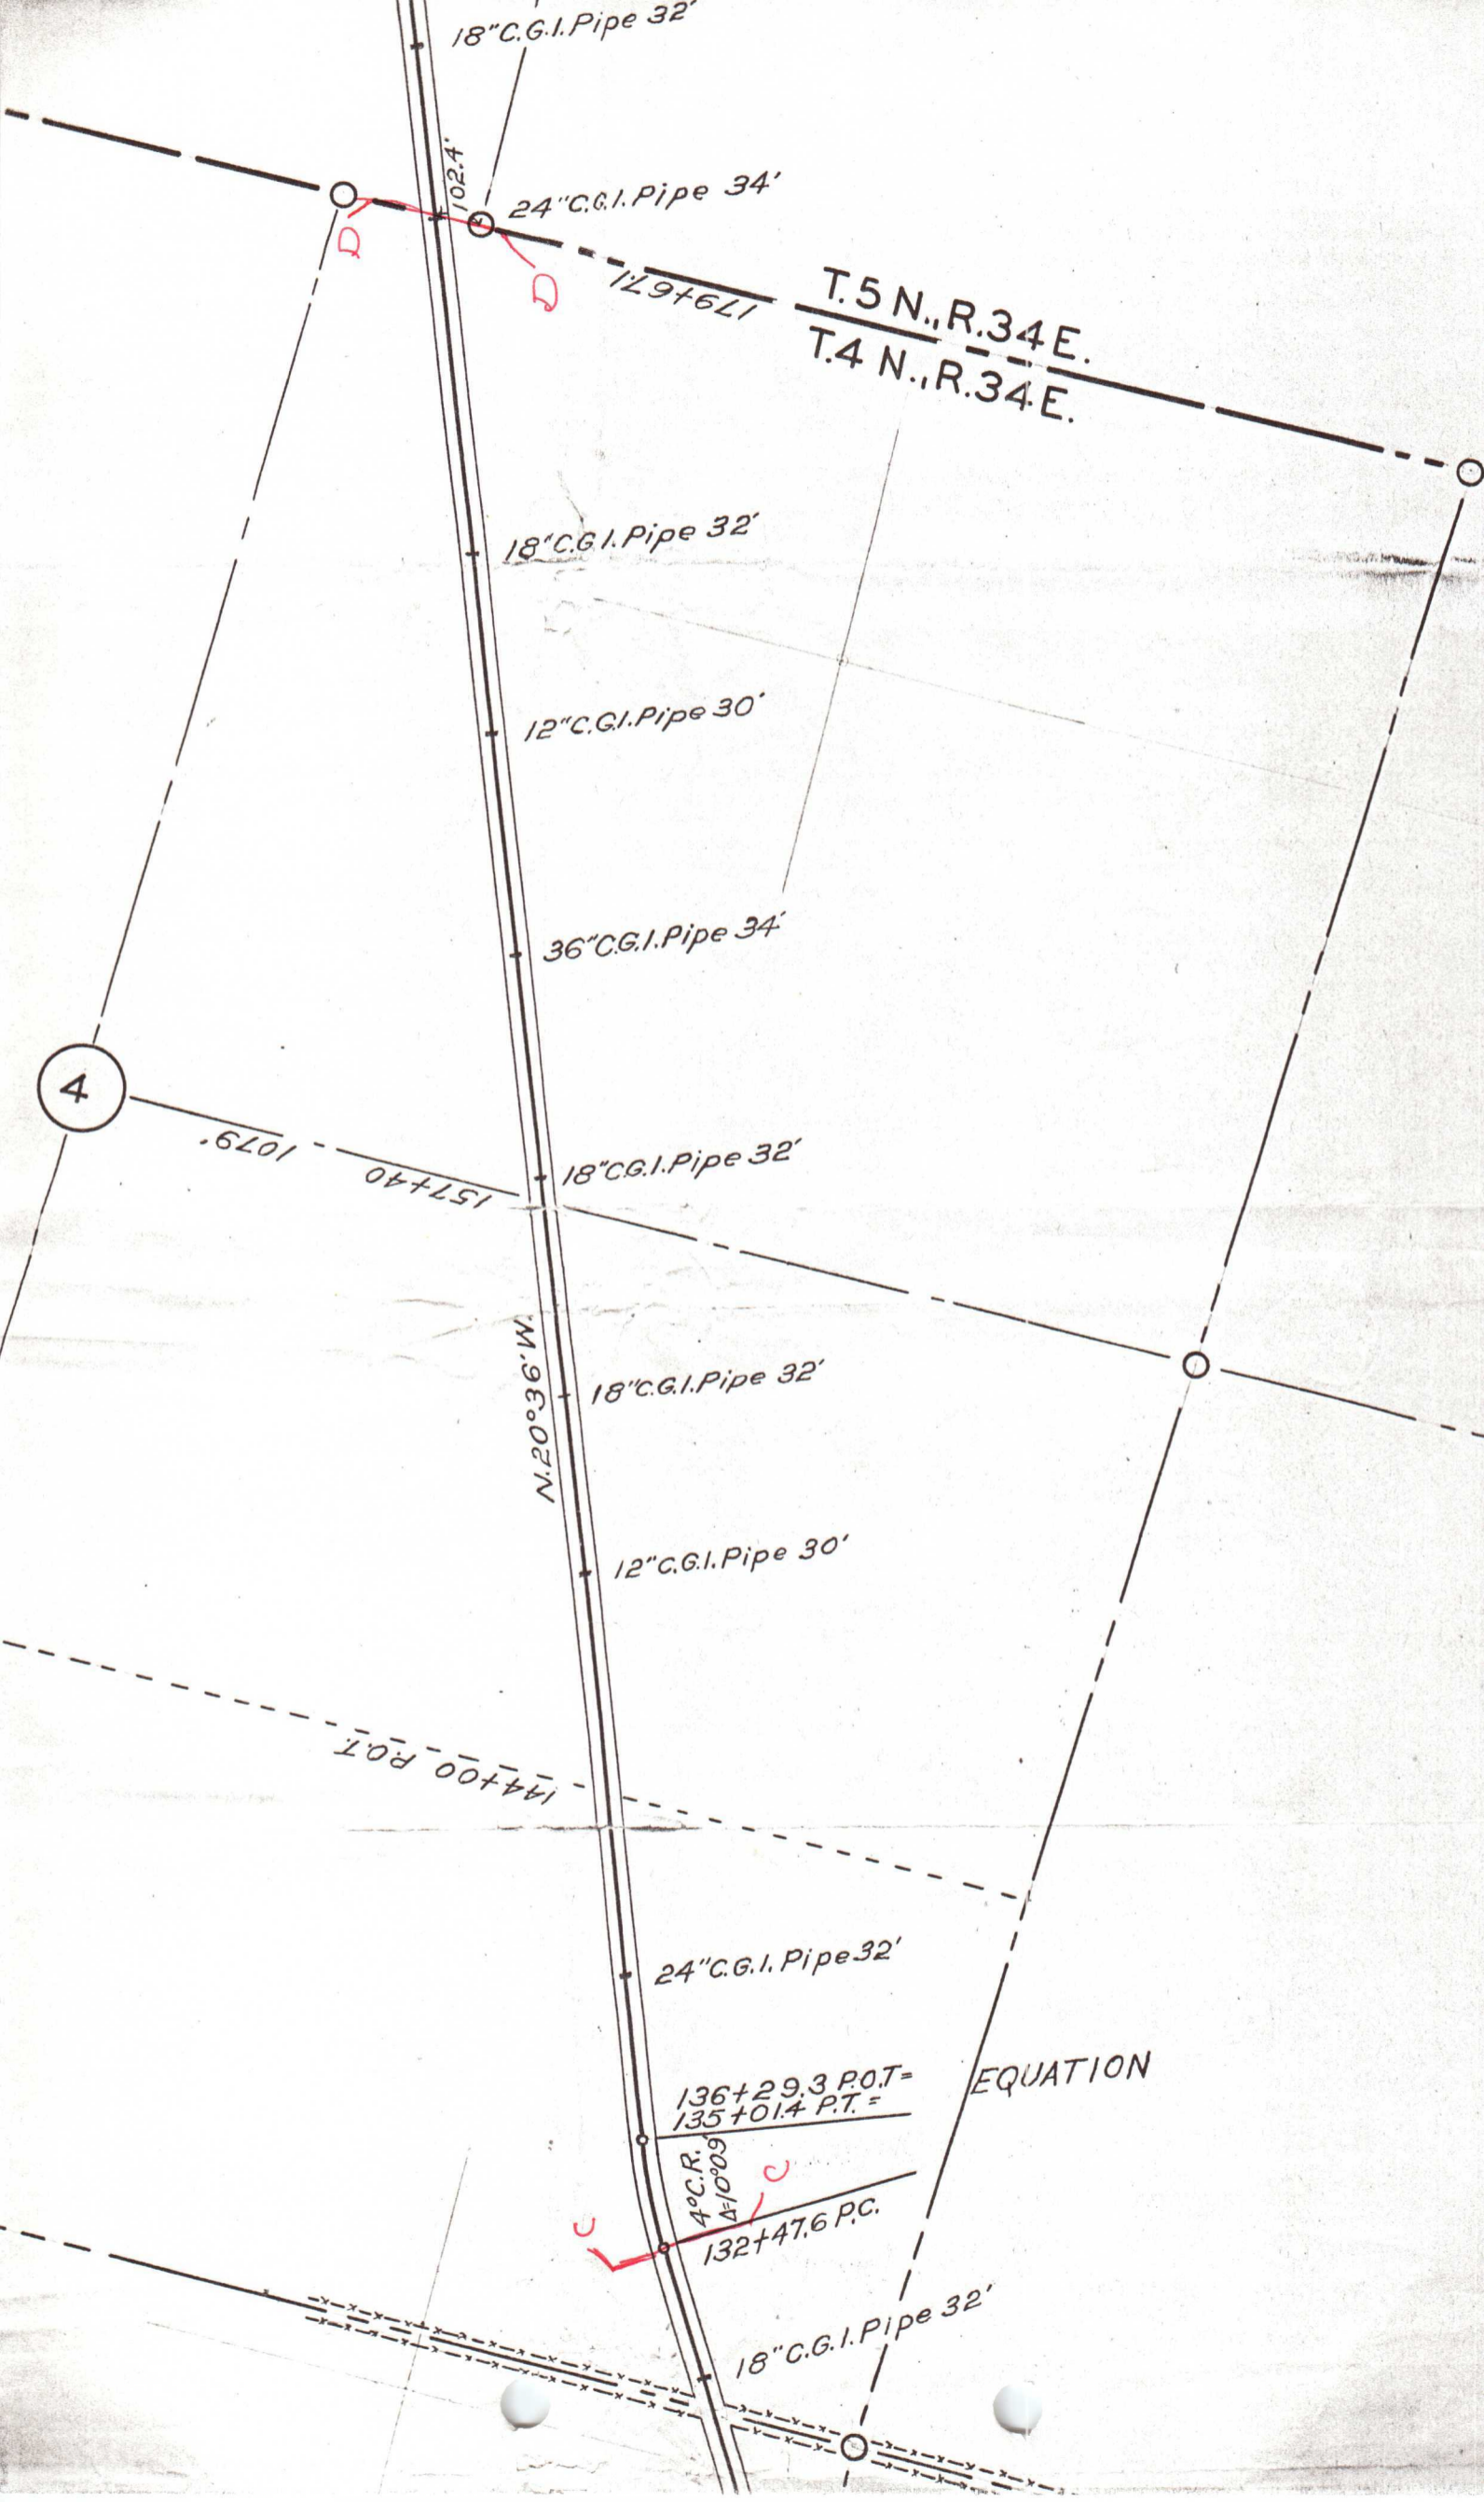

18" C.G.I. Pipe 32'

102.4'

24" C.G.I. Pipe 34'


T.5 N., R.34 E.
T.4 N., R.34 E.

18" C.G.I. Pipe 32'

12" C.G.I. Pipe 30'

36" C.G.I. Pipe 34'

18" C.G.I. Pipe 32'

4

1079.6

157+4.0

N.20°36'W

18" C.G.I. Pipe 32'

12" C.G.I. Pipe 30'

144+0.0 P.O.T.

24" C.G.I. Pipe 32'

136+29.3 P.O.T.
135+01.4 P.T. =

EQUATION

4° C.R.
410°09'

132+47.6 P.C.

18" C.G.I. Pipe 32'

