


Plot of road from center of sec. 27 T4R34E

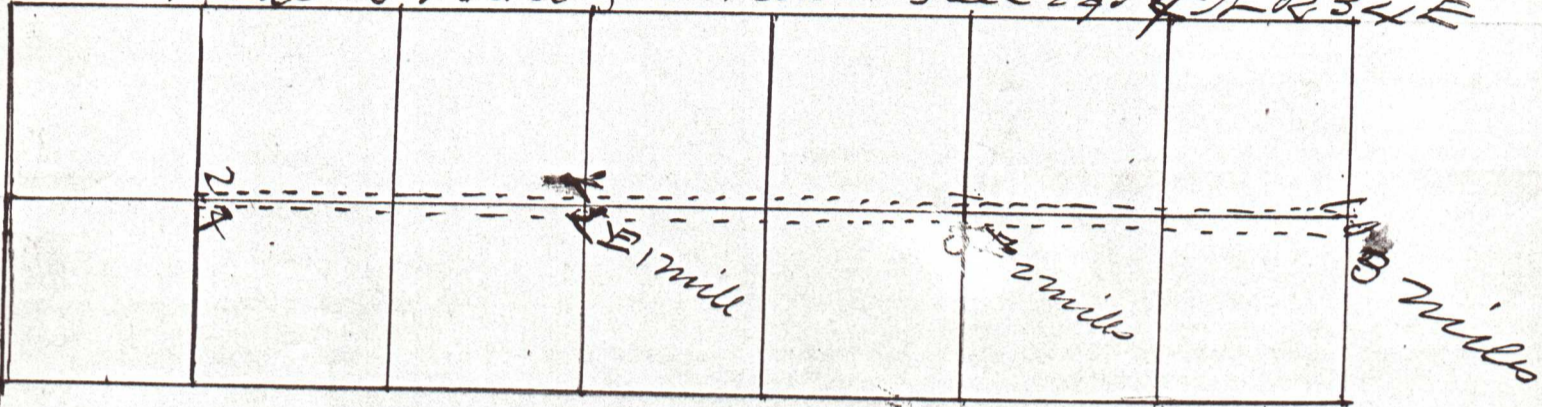

Surveyed May 16<sup>th</sup> 1876

J. L. Moorhouse  
Surveyor  
Winnemucca