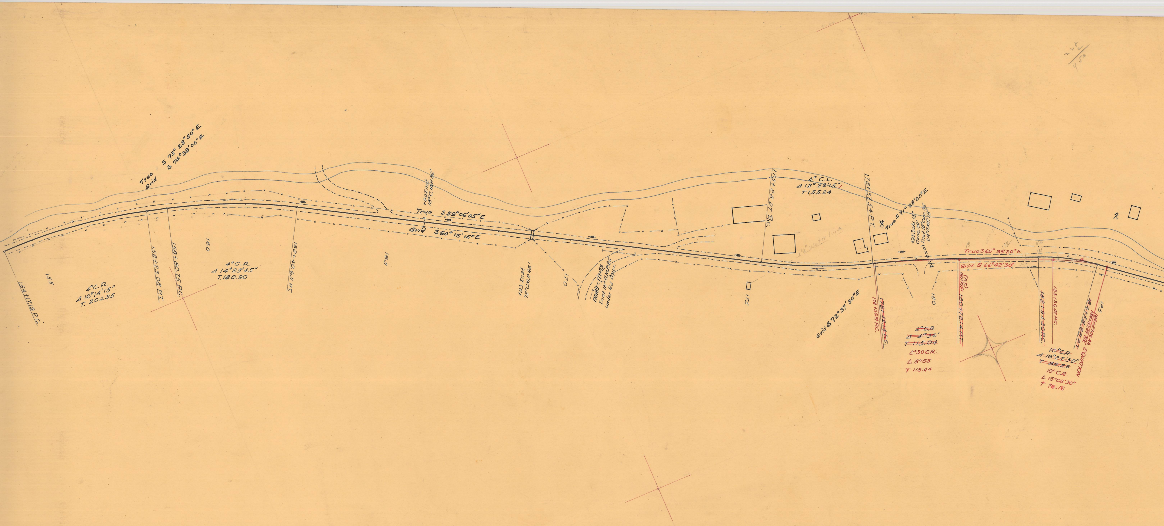
True S 73° 29' 50" E
Grid S 74° 39' 00" E
154+17.19 P.C.
155
4°C.R.
Δ 16°14'15"
T. 204.35
158+23.08 P.I.
158+80.75 P.C.
160
4°C.R.
Δ 14°23'45"
T.180.90
162+40.65 P.T.
165
+90 Inst. 18"C.M.P. 36'
True S 59°06'05" E
Grid S 60°15'15" E
+93 Inst. 72"C.M.P. 45'
170
170+89 - 171+75 Inst. 15"C.M.P. 86' Under Rd Appr
175+28.27 P.C.
4° C.L.
Δ 12°22'15"
T 155.24
175
1¼" Water line
178+37.54 P.T.
True S 71°28'20" E
+95 Salv. 18" Conc. 36' Inst. 18" Conc. 36' 24" C.M.P. 18'
Grid S 72°37'30" E
~~178+42.14 P.C.~~
178+38.74 P.C.
180
(P.T.) 180+75.41
~~180+72.14 P.T.~~
~~2°C.R.~~
~~Δ 4°36'~~
~~T 115.04~~
2°30 C.R.
Δ 5°55
T 118.44
True S 65° 33' 20" E
Grid. S 66°42'30"
181
182
183
~~182+94.30 P.C.~~
183+36.97 P.C.
~~184+56.85 P.T.~~
184+87.89 Bk.
184+89.06 Ah.
EQUATION
185
~~10°C.R.~~
~~Δ 16°27'30"~~
~~T 82.26~~
10°C.R.
Δ 15°08'30"
T 76.16

5F13-2
SH.6

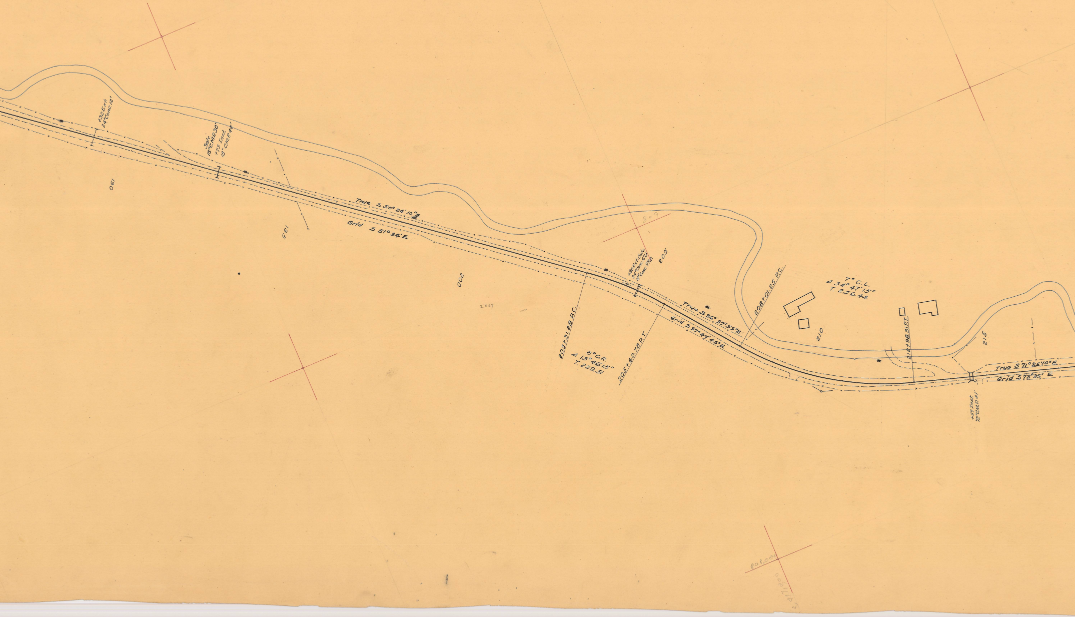
+32 Ext.
24" Conc. 12'
Solv.
15" C.M.P. 30'
+75 Inst.
18" C.M.P. 44'
190
195
True S 50° 24' 10" E
Grid S 51° 34' E
200
203+31.28 P.C.
6° C.R.
Δ 15° 46' 15"
T. 229.51
+80 Ext. Culv.
24" Conc. 6' Lt.
18" Conc. 9' Rt.
205
205+60.78 P.T.
True S 36° 37' 55" E
Grid S 37° 47' 45" E
808
208+01.25 P.C.
7° C.L.
Δ 34° 47' 15"
T. 256.44
210
212+98.31 P.T.
215
True S 71° 25' 10" E
Grid S 72° 35' E
+57 Inst.
72" C.M.P. 41'
808,000
2,171,000

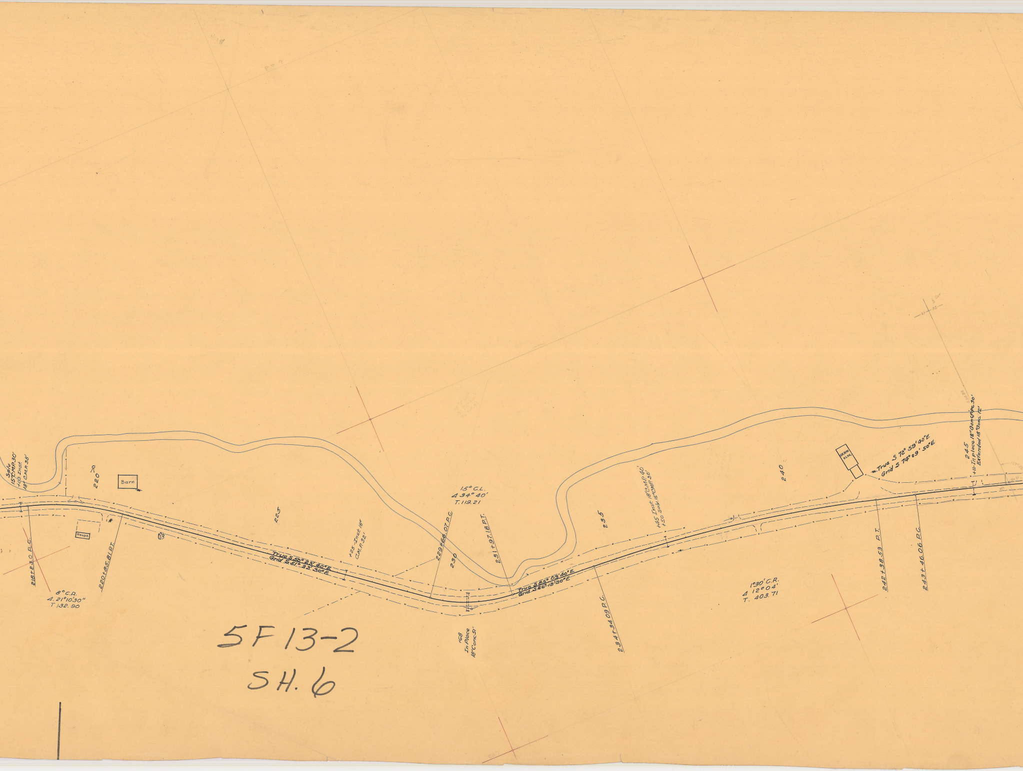
Salv. 15" C.M.P. 30'
+03 Inst. 18" C.M.P. 38'
218+23.0 P.C.
220
Barn
House
220+85.81 P.T.
8° C.R.
Δ. 21°10'30"
T 132.90
225
True S 50° 23' 40" E
Grid S 51° 33' 30" E
+25 - Inst. 18" C.M.P. 32'
15° C.L.
Δ 34° 40'
T. 119.21
229+66.07 P.C.
230
231+97.18 P.T.
+68
In Place
18" Conc. 51'
True S 85° 03' 40" E
Grid S 86° 13' 30" E
234+34.09 P.C.
235
+45 Inst. 18" C.M.P. 40'
+50 Salv. 15" C.M.P. 30'
240
1°30' C.R.
Δ 12° 04'
T. 403.71
GRAIN ELEV.
True S 72° 59' 40" E
Grid S 74° 09' 50" E
242+38.53 P.T.
243+46.06 P.C.
245
+11 - In place 18" Conc. Pipe 30'
Extended 18" Conc. 12'

5F 13-2
SH. 6

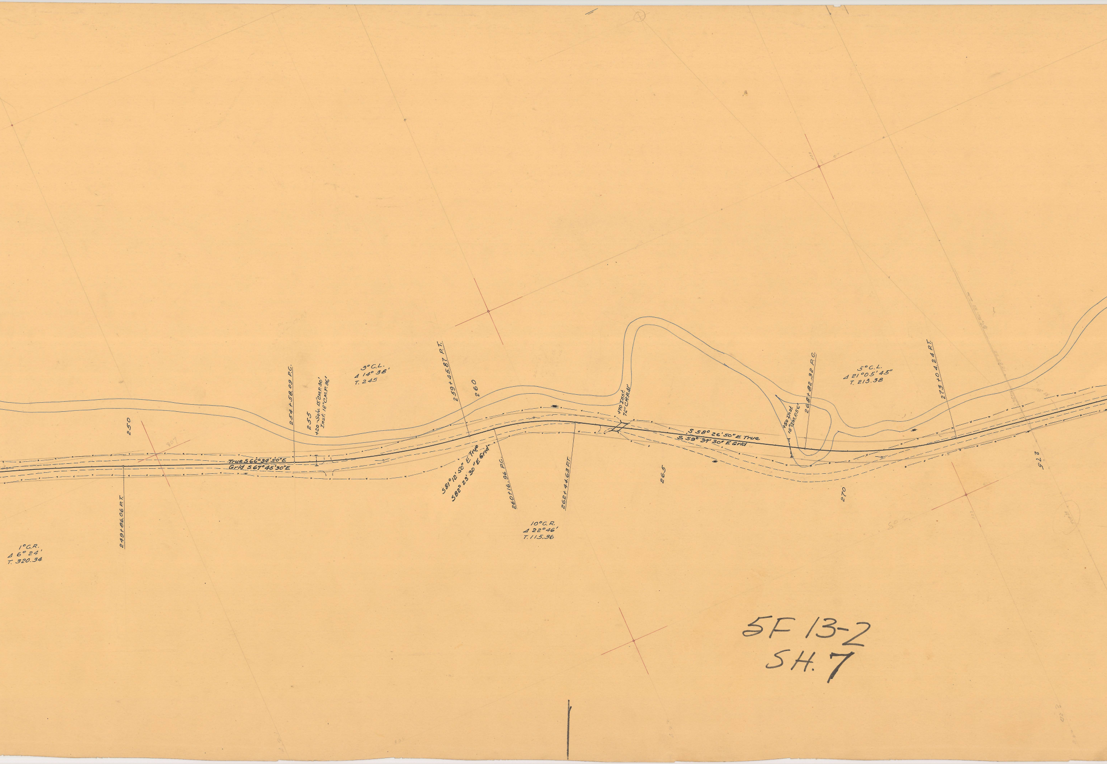

250
249+86.06 P.T.
1°C.R.
Δ 6° 24'
T. 320.34
807
True S66°34'50"E
Grid S67°45'30"E
254+58.09 P.C.
255
+20 Salv. 15"C.M.P. 30'
Inst. 18"C.M.P. 36'
3°C.L.
Δ 14° 38'
T. 245
259+45.87 P.T.
260
S81°12'50" E True
S82°23'30" E Grid
260+16.96 P.C.
262+44.63 P.T.
10°C.R.
Δ 22°46'
T. 115.36
+70 Inst.
72" C.M.P. 41'
265
S 58° 26' 50" E True
S 59° 34' 30" E Grid
+50 Inst.
18" C.M.P. 56'
268+82.32 P.C.
5°C.L.
Δ 21°05'45"
T. 213.38
270
273+04.24 P.T.
275

5F 13-2
SH. 7

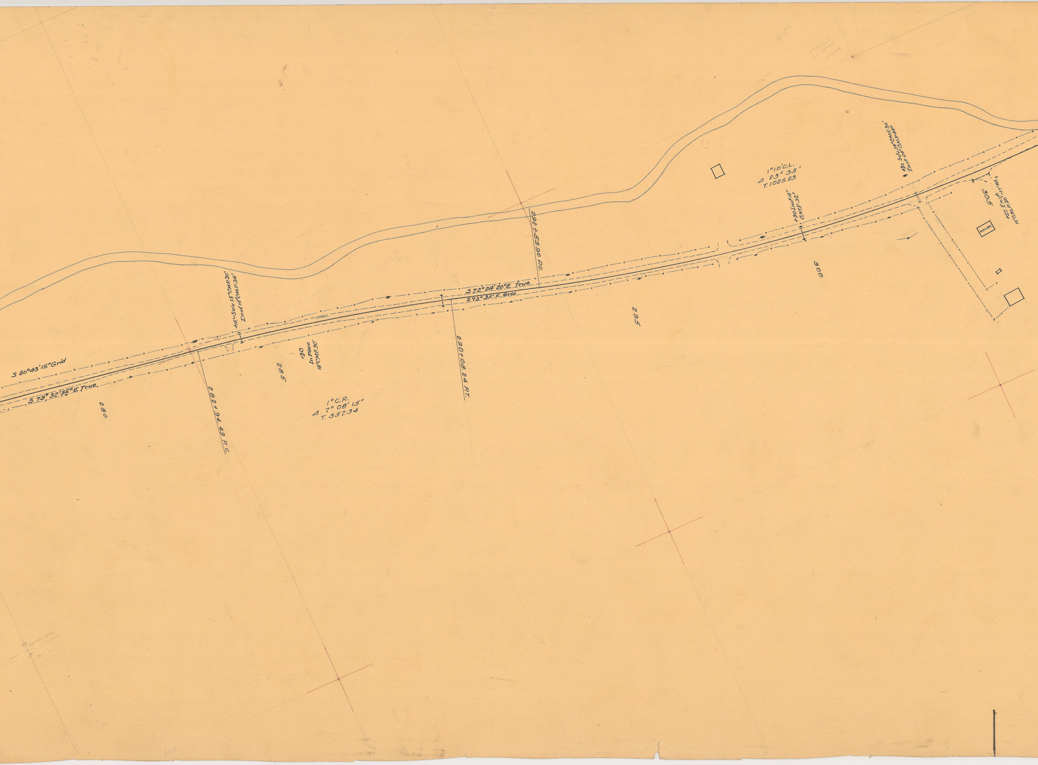
S 80°43'15" Grid
S 79° 32' 35" E True,
280
282+94.49 P.C.
+18'-Salv 15" C.M.P. 30'
Inst. 18" C.M.P. 38'
285
+90
In Place
18" C.M.P. 30'
1° C.R.
Δ 7° 08' 15"
T. 357.34
S 72° 24' 20" E True
S 73° 35' E Grid
290+08.24 P.T.
292+53.90 P.C.
295
1°10' C.L.
Δ 23° 35'
T. 1025.23
+90 Inst. 18"
C.M.P. 32'
300
+30 Salv. 24" C.M.P. 30'
Inst. 24" C.M.P. 44'
305
+22 Inst.-17' Rt.
12" C.M.P. 30'
HOUSE

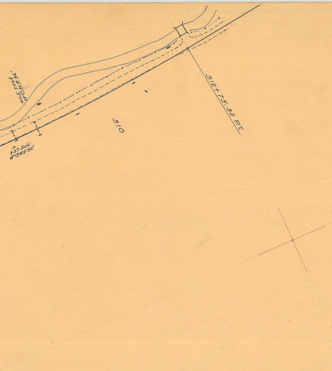
+05 Inst. 18" C.M.P. 36'
+37 Salv. 18" CMP 30'
310
312+75.32 P.T.

5F 13-2
SH. 8