


119° 00' 00"

118° 52' 30"

118° 45' 00"

15° 52' 30"

See Page 5

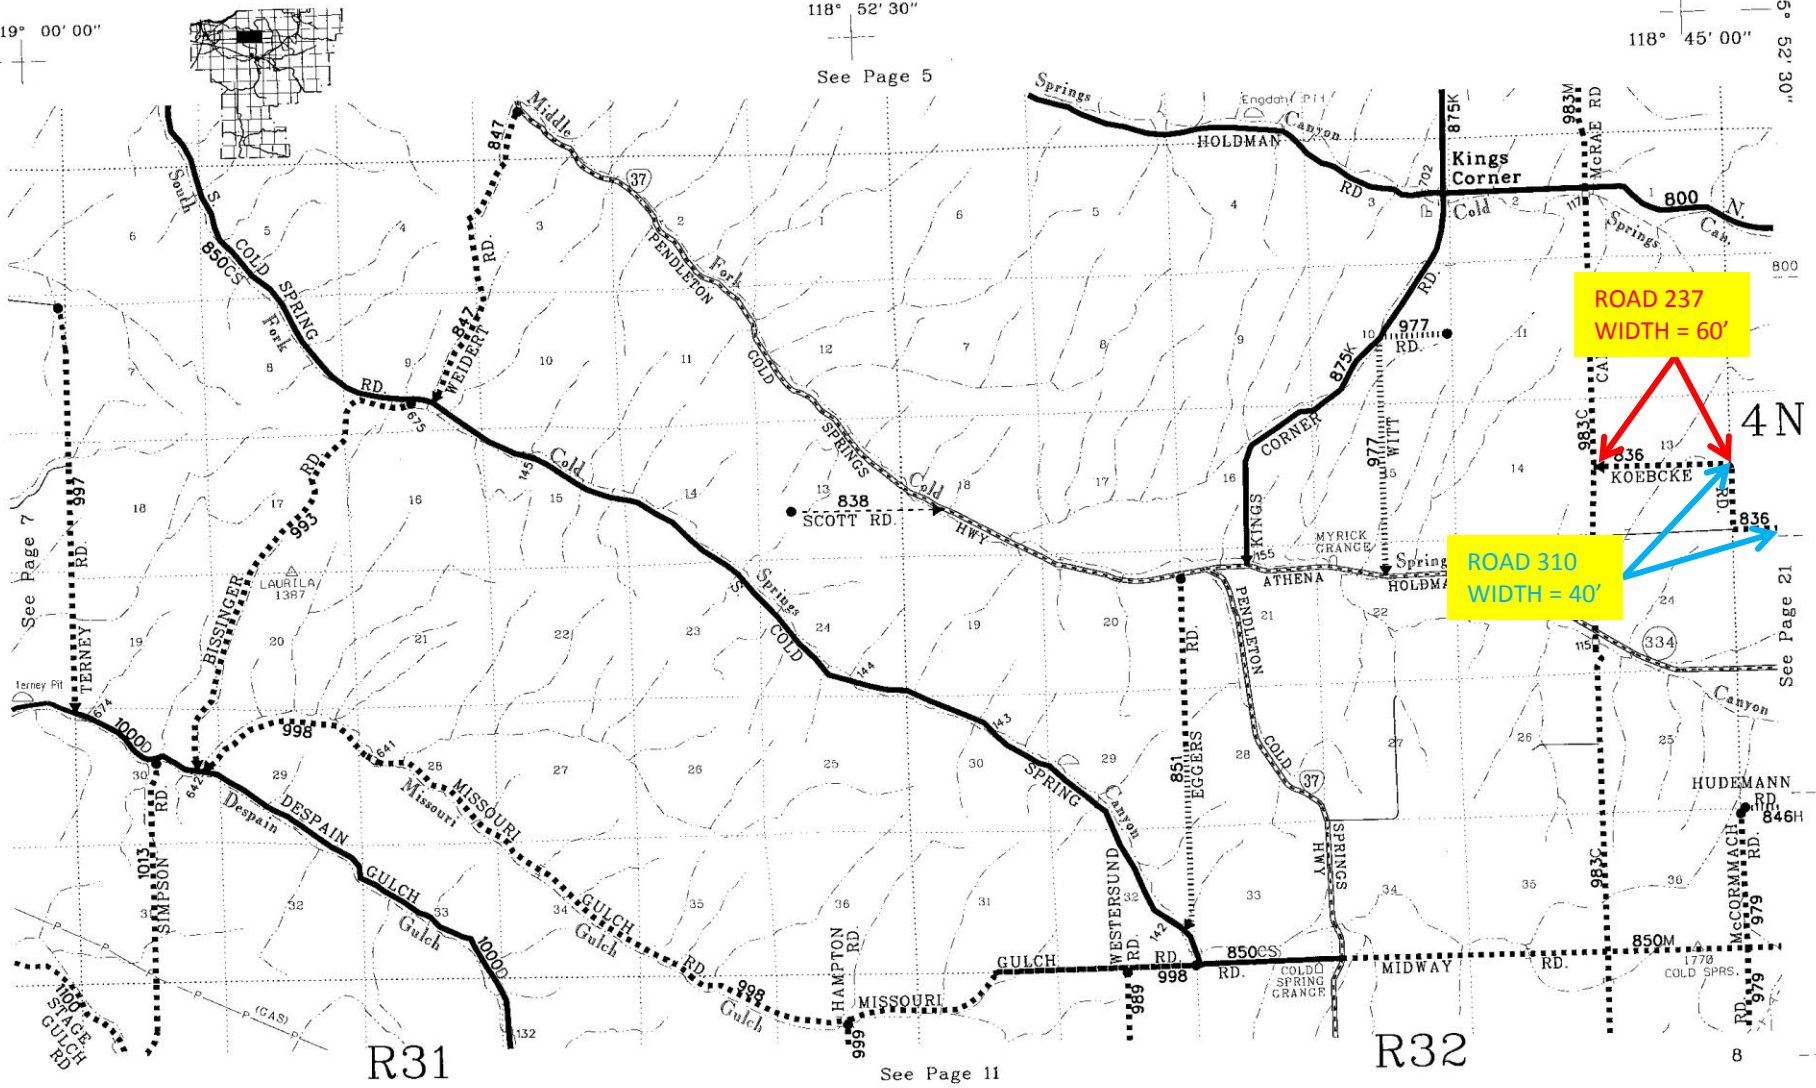

ROAD 237
WIDTH = 60'

ROAD 310
WIDTH = 40'

See Page 7

See Page 11

See Page 11

See Page 21

R31

R32

4N

8



