OREGON STATE HIGHWAY DEPARTMENT

AS CONSTRUCTED

~~LOCATED LINE~~

HELIX—VANSYCLE SECTION

F.A.S. NO. 467

UMATILLA COUNTY

STATION 0+00 —— STATION 195+00

BEARINGS MAGNETIC NOVEMBER 1955

JOHN H. WALKER—RESIDENT ENGR. SCALE 1"=100'

6F 18-9
SH. 1

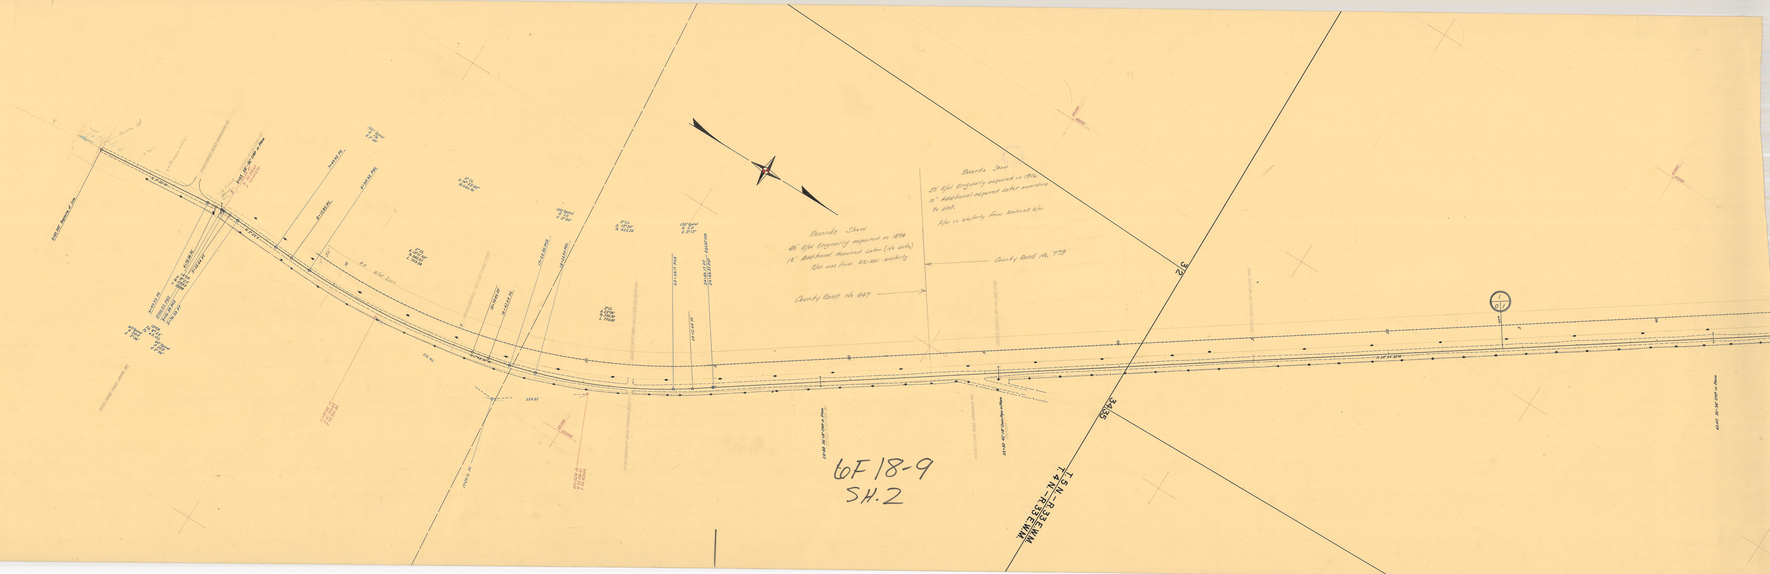

6F 18-9
SH. 2