

119° 00' 00"

118° 52' 30"

118° 45' 00"

15° 52' 30"

See Page 5

MARKET ROAD 378
WIDTH = 60'

ROAD 157
WIDTH = 60'

ROAD 899
WIDTH = 60'

ROAD 336
WIDTH = 60'


See Page 11


See Page 21

R31

R32

8

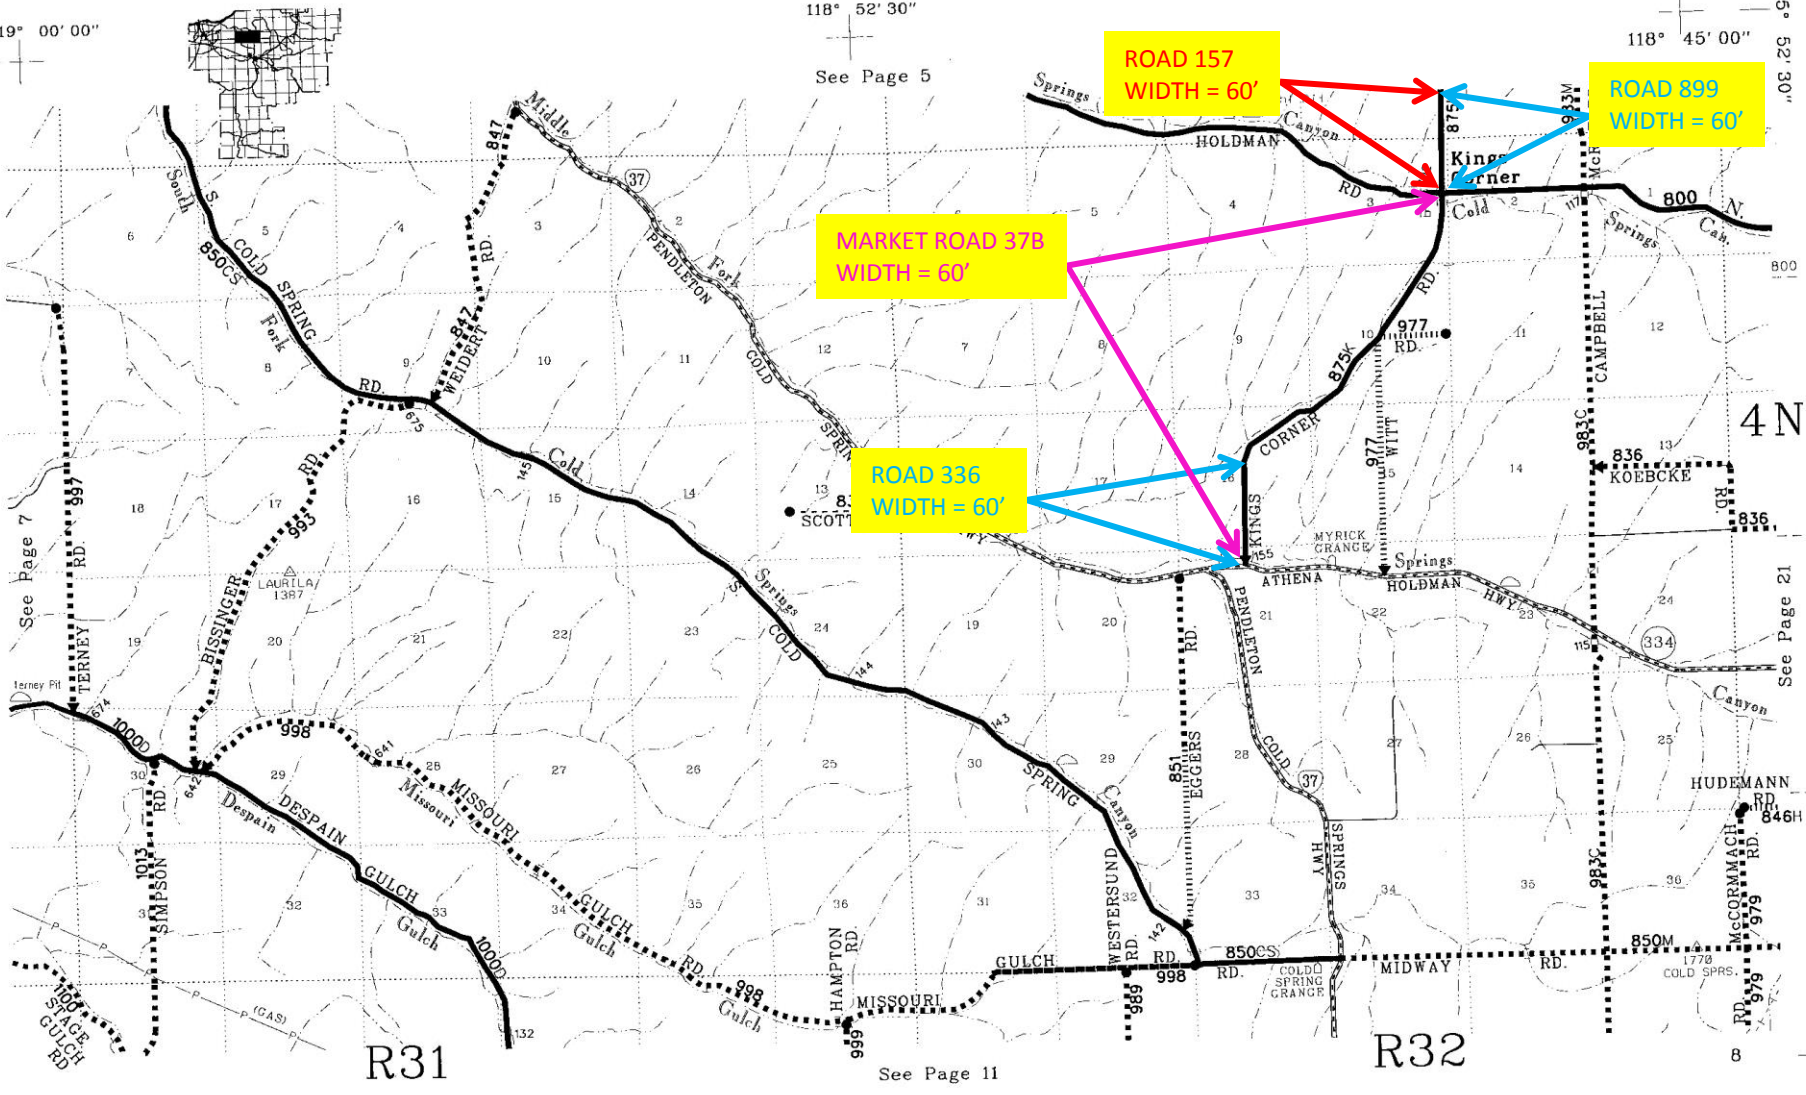

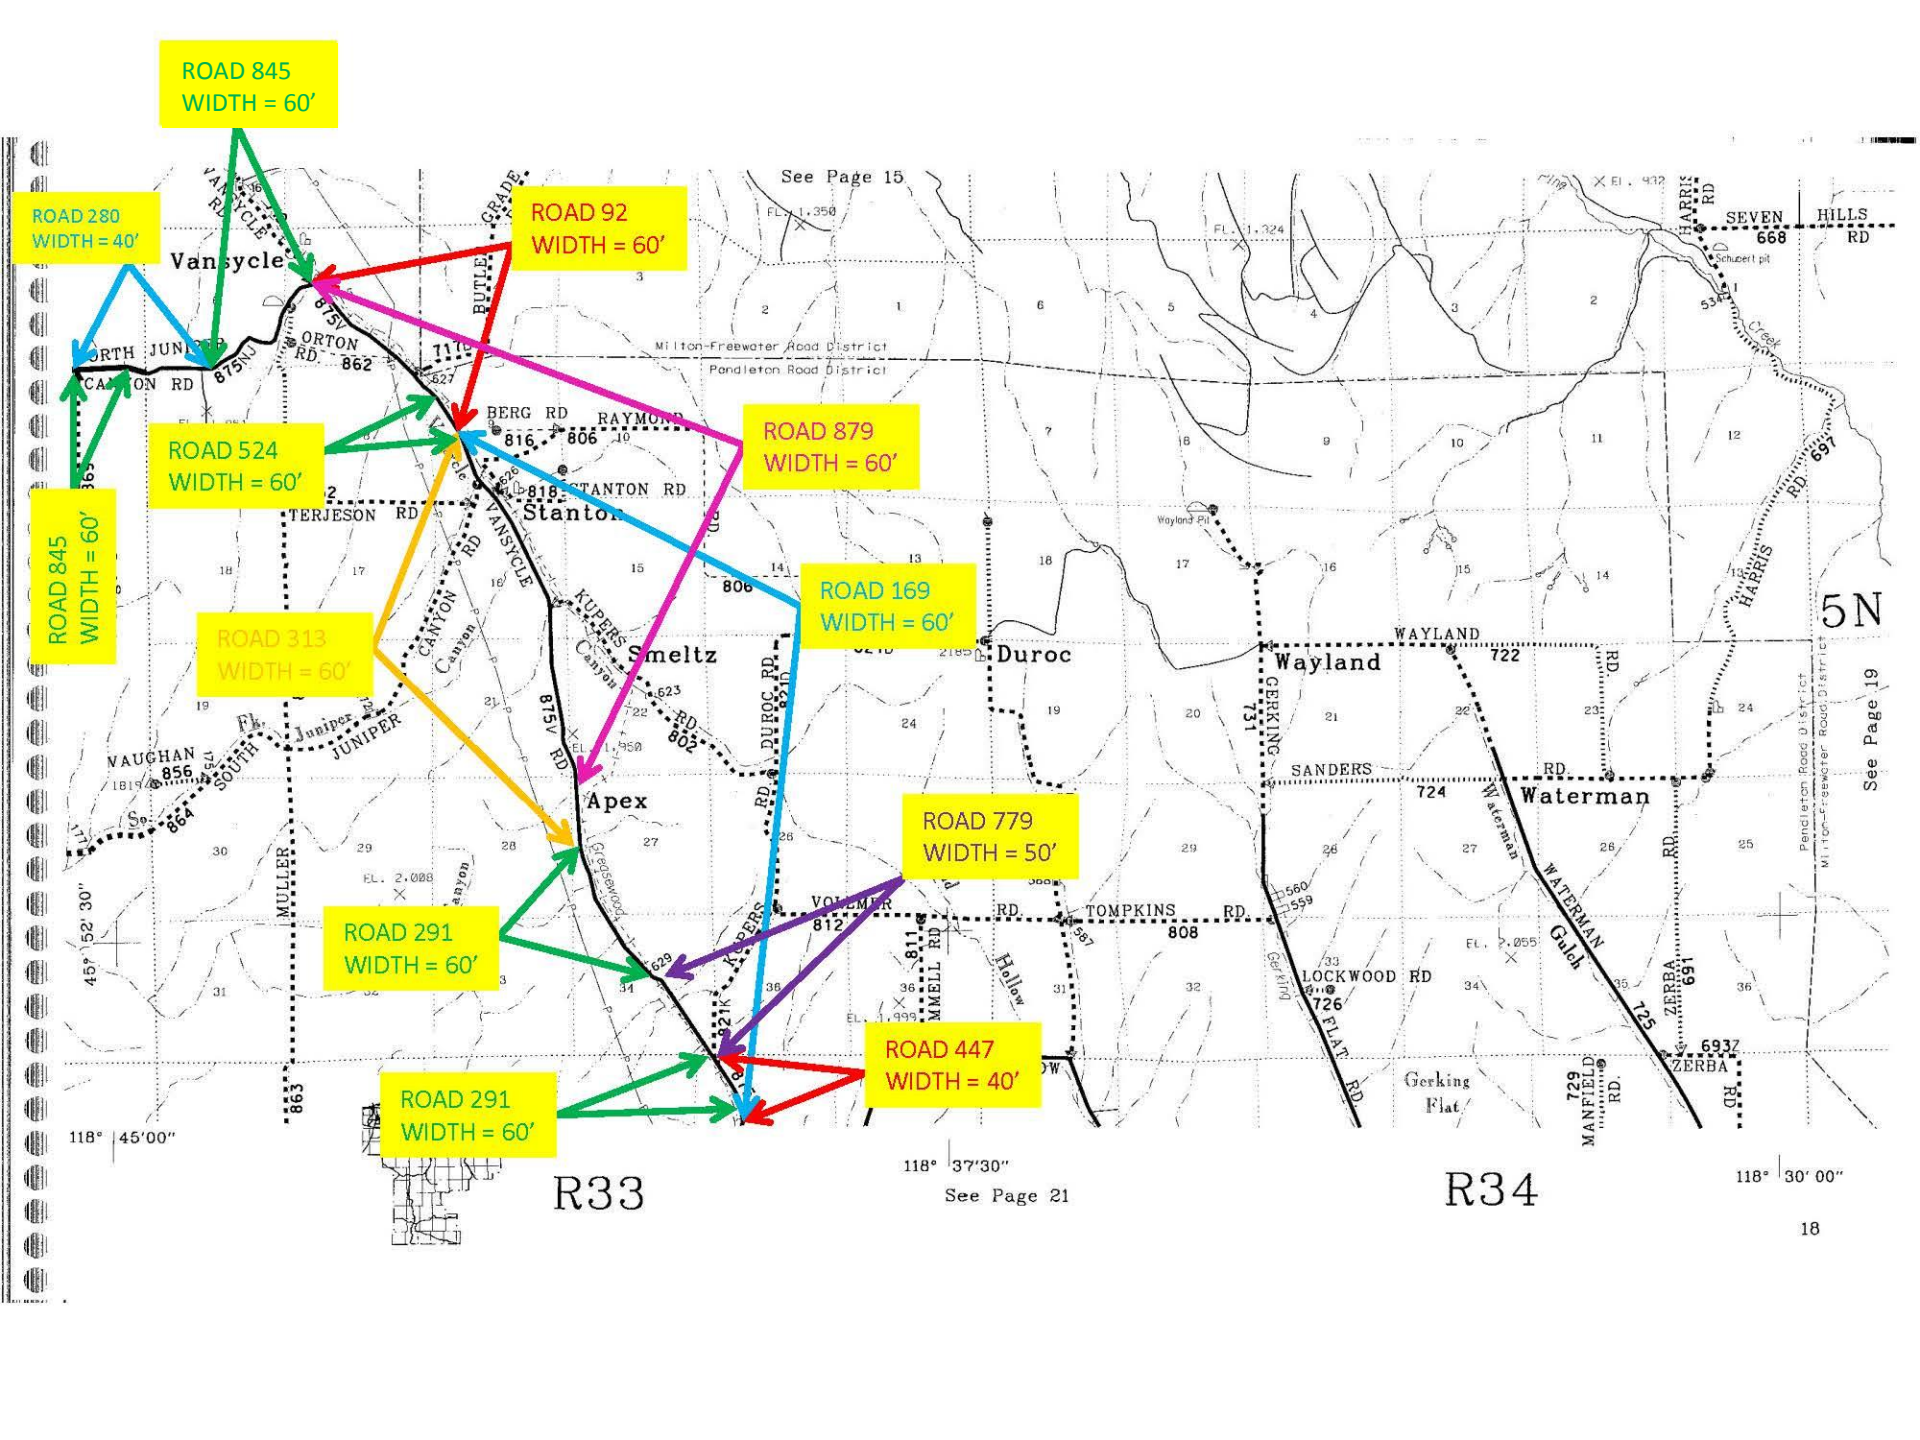

ROAD 845
WIDTH = 60'

ROAD 280
WIDTH = 40'

ROAD 92
WIDTH = 60'

ROAD 524
WIDTH = 60'

ROAD 879
WIDTH = 60'

ROAD 845
WIDTH = 60'

ROAD 169
WIDTH = 60'

ROAD 313
WIDTH = 60'

ROAD 779
WIDTH = 50'

ROAD 291
WIDTH = 60'

ROAD 447
WIDTH = 40'


ROAD 291
WIDTH = 60'

R33

118° 37' 30"
See Page 21

R34

118° 30' 00"

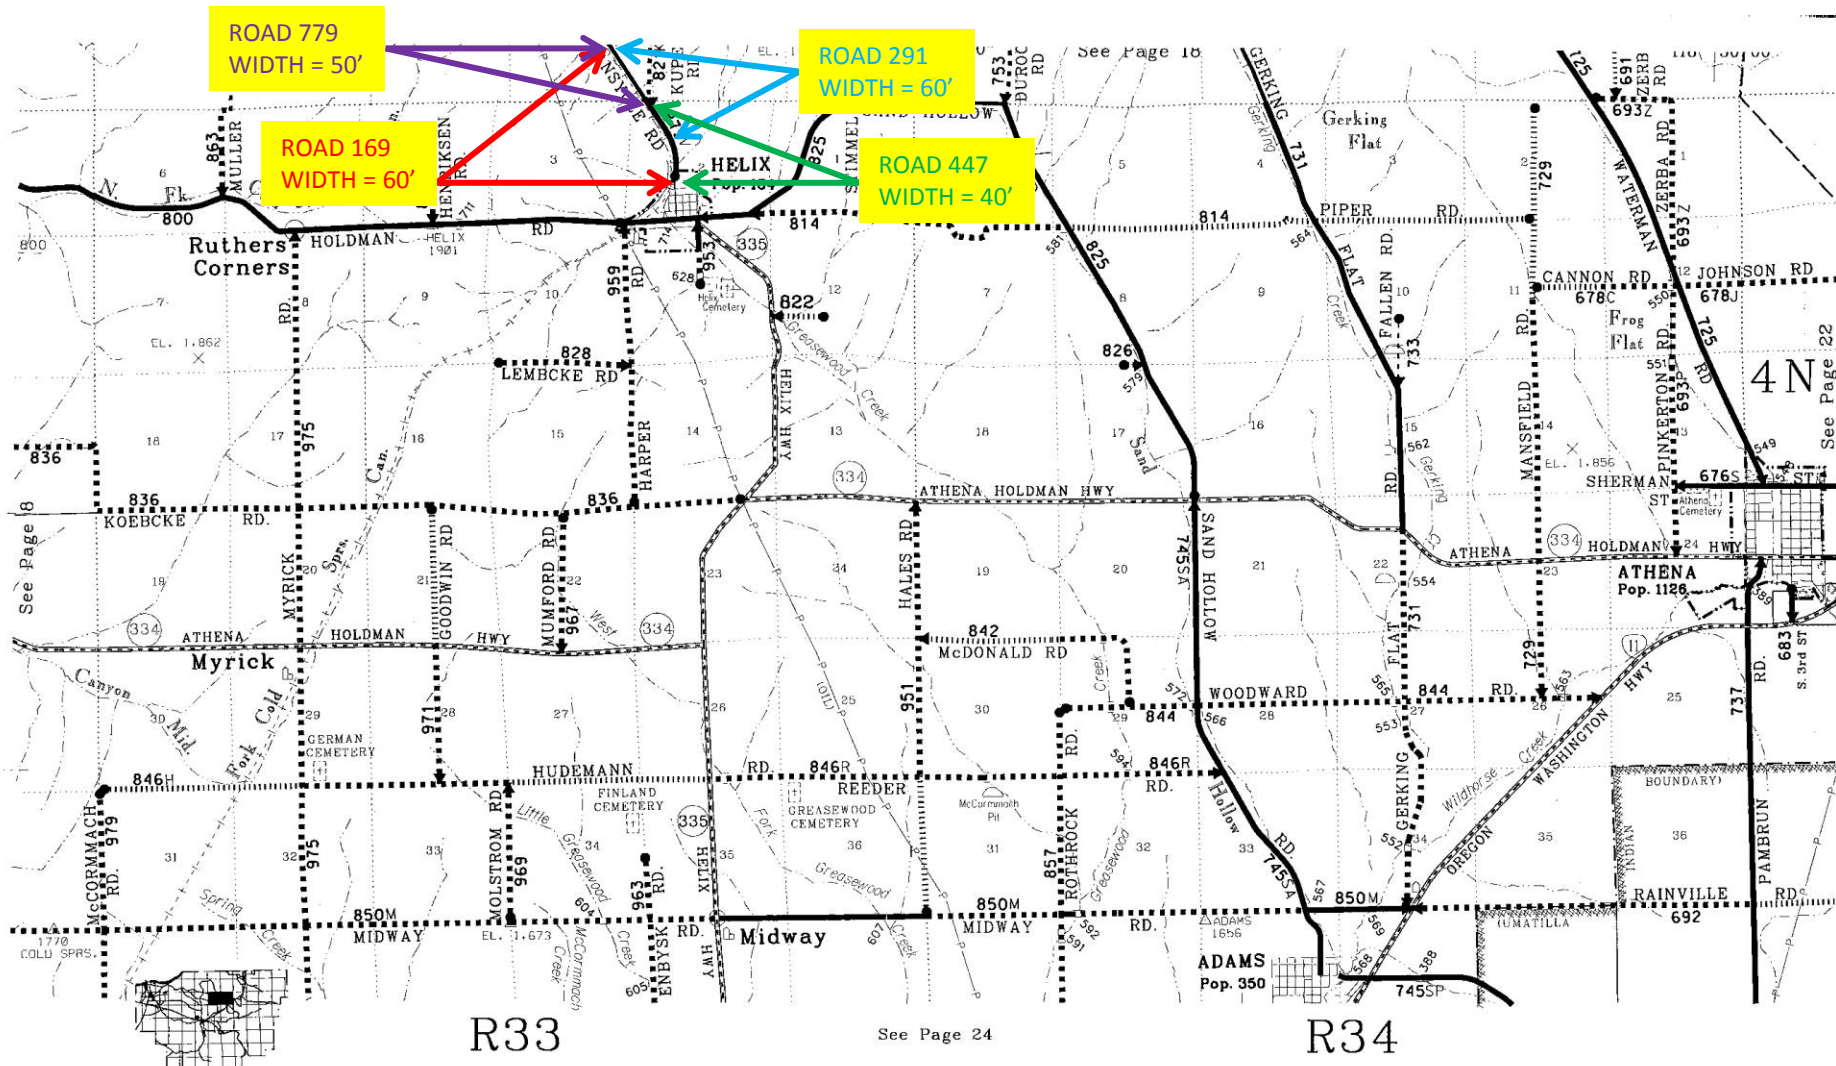



119° 00' 00"

118° 52' 30"

118° 45' 00"

15° 52' 30"

See Page 5

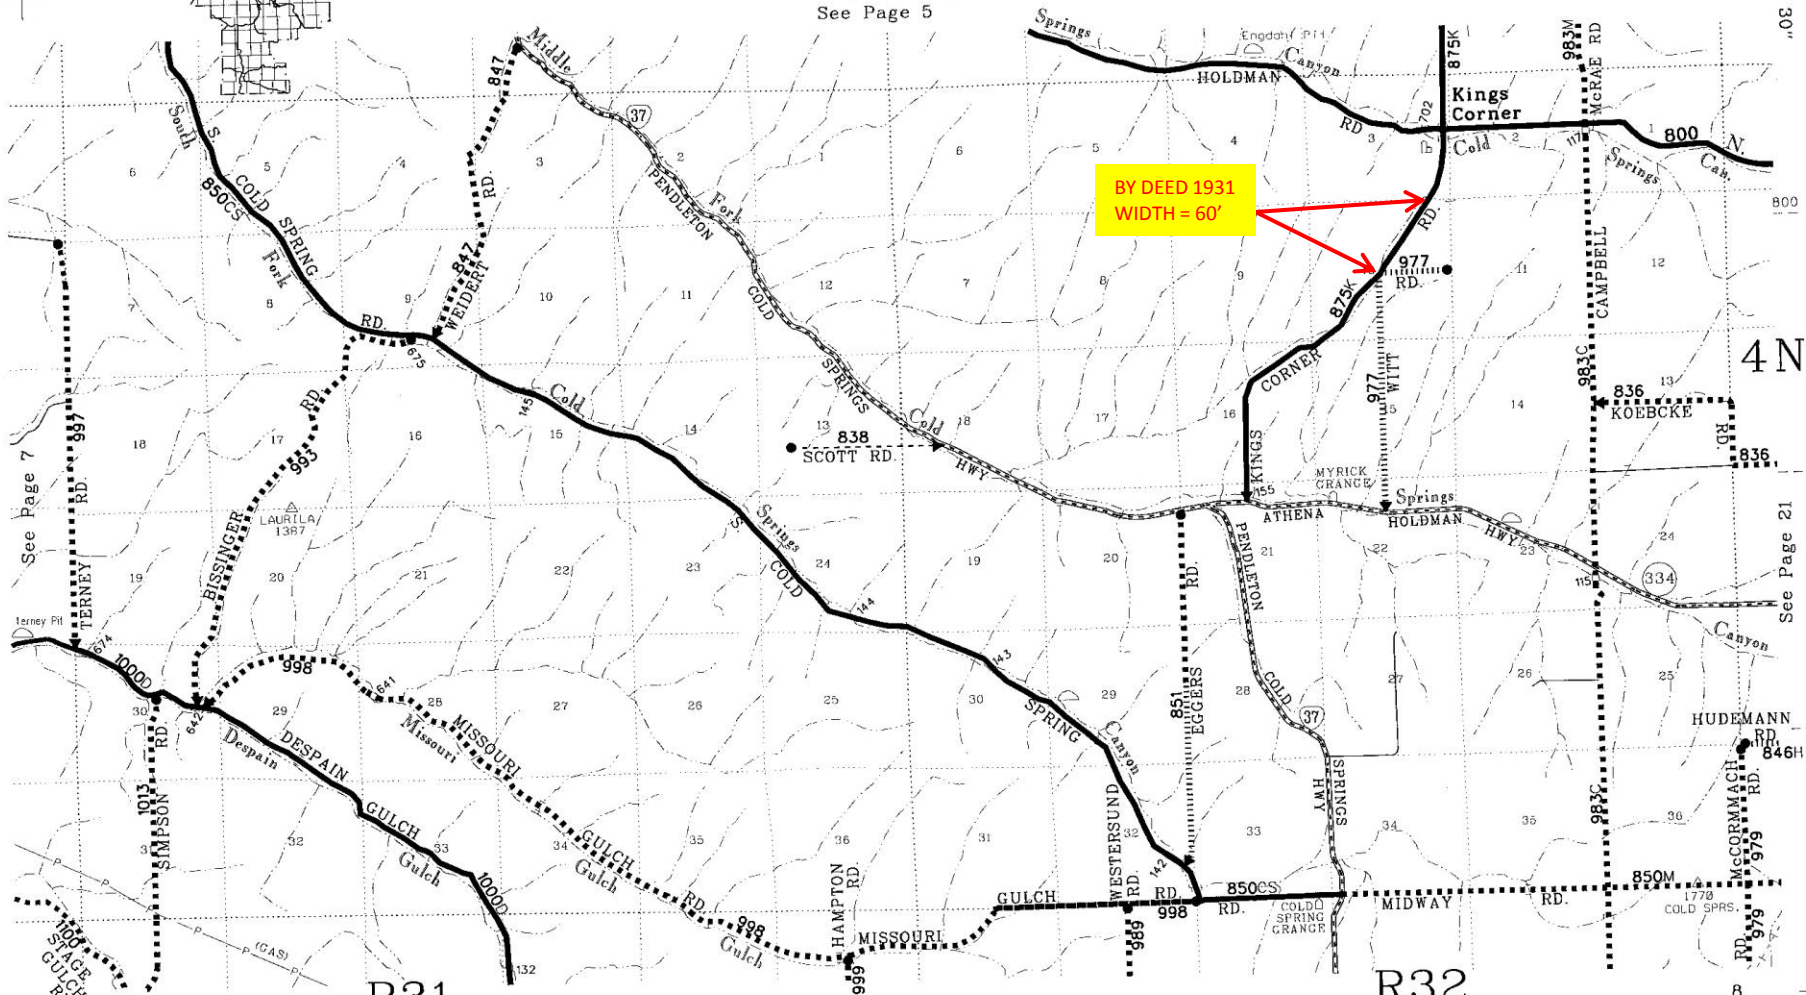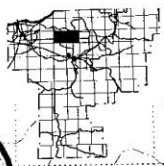

BY DEED 1931
WIDTH = 60'



See Page 7


See Page 21

R31

See Page 11

R32

8

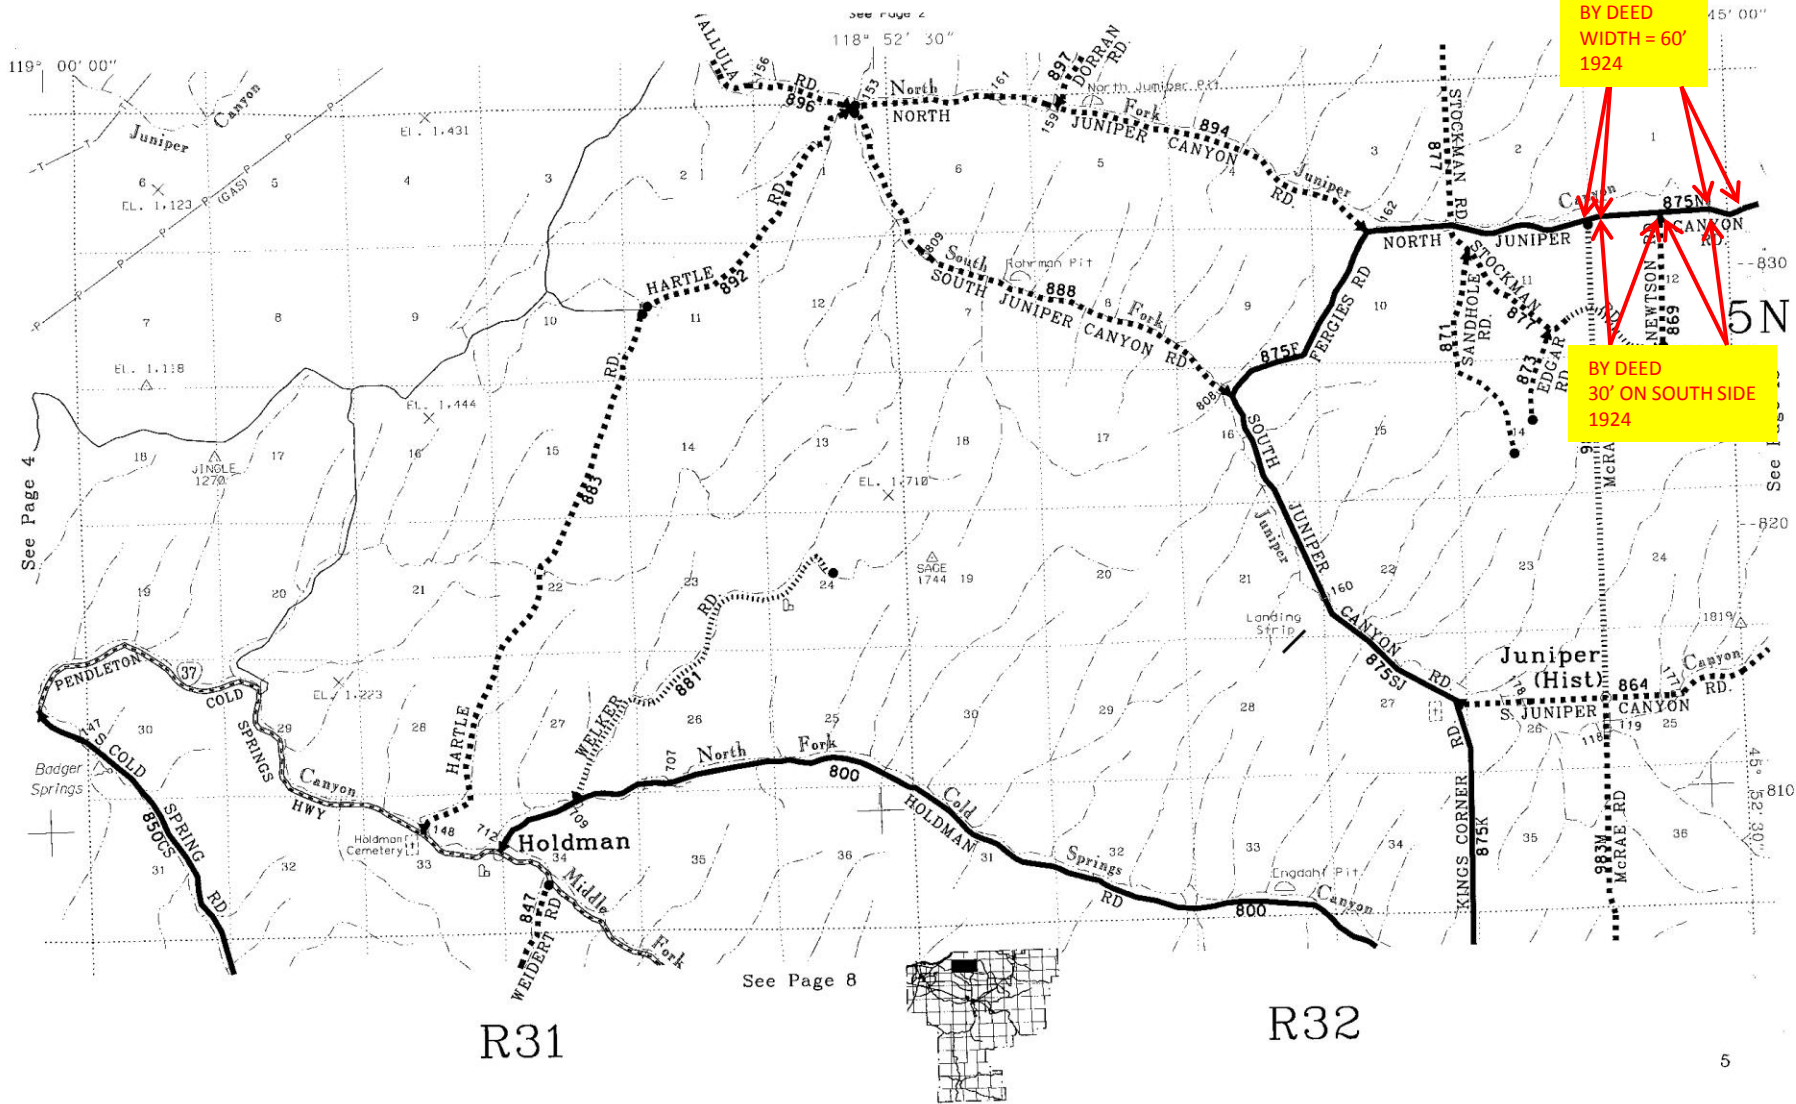

BY DEED
WIDTH = 60'
1924

BY DEED
30' ON SOUTH SIDE
1924

See Page 4

See Page 8

R31

R32

