


**ROAD 478  
WIDTH = 40'**

R35

R36


See Page 28

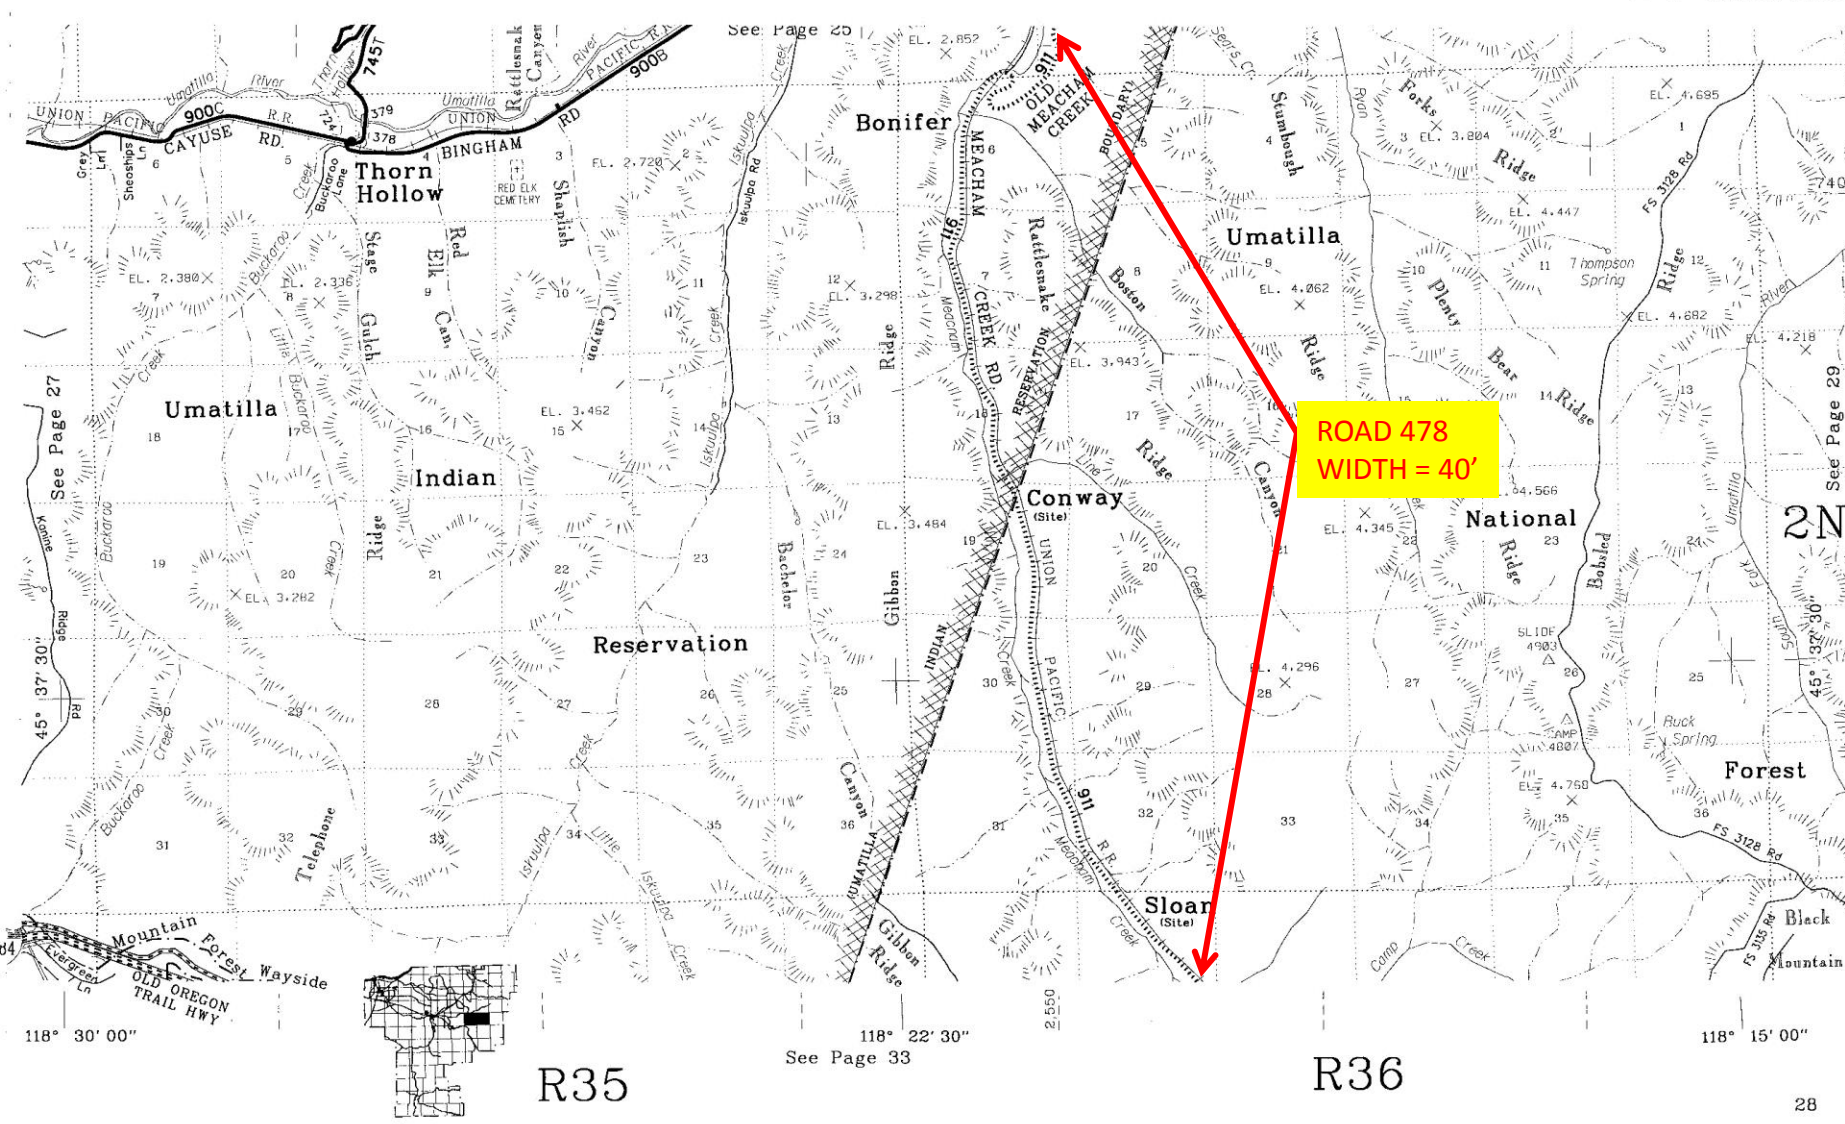

**ROAD 478  
WIDTH = 40'**

R35

R36

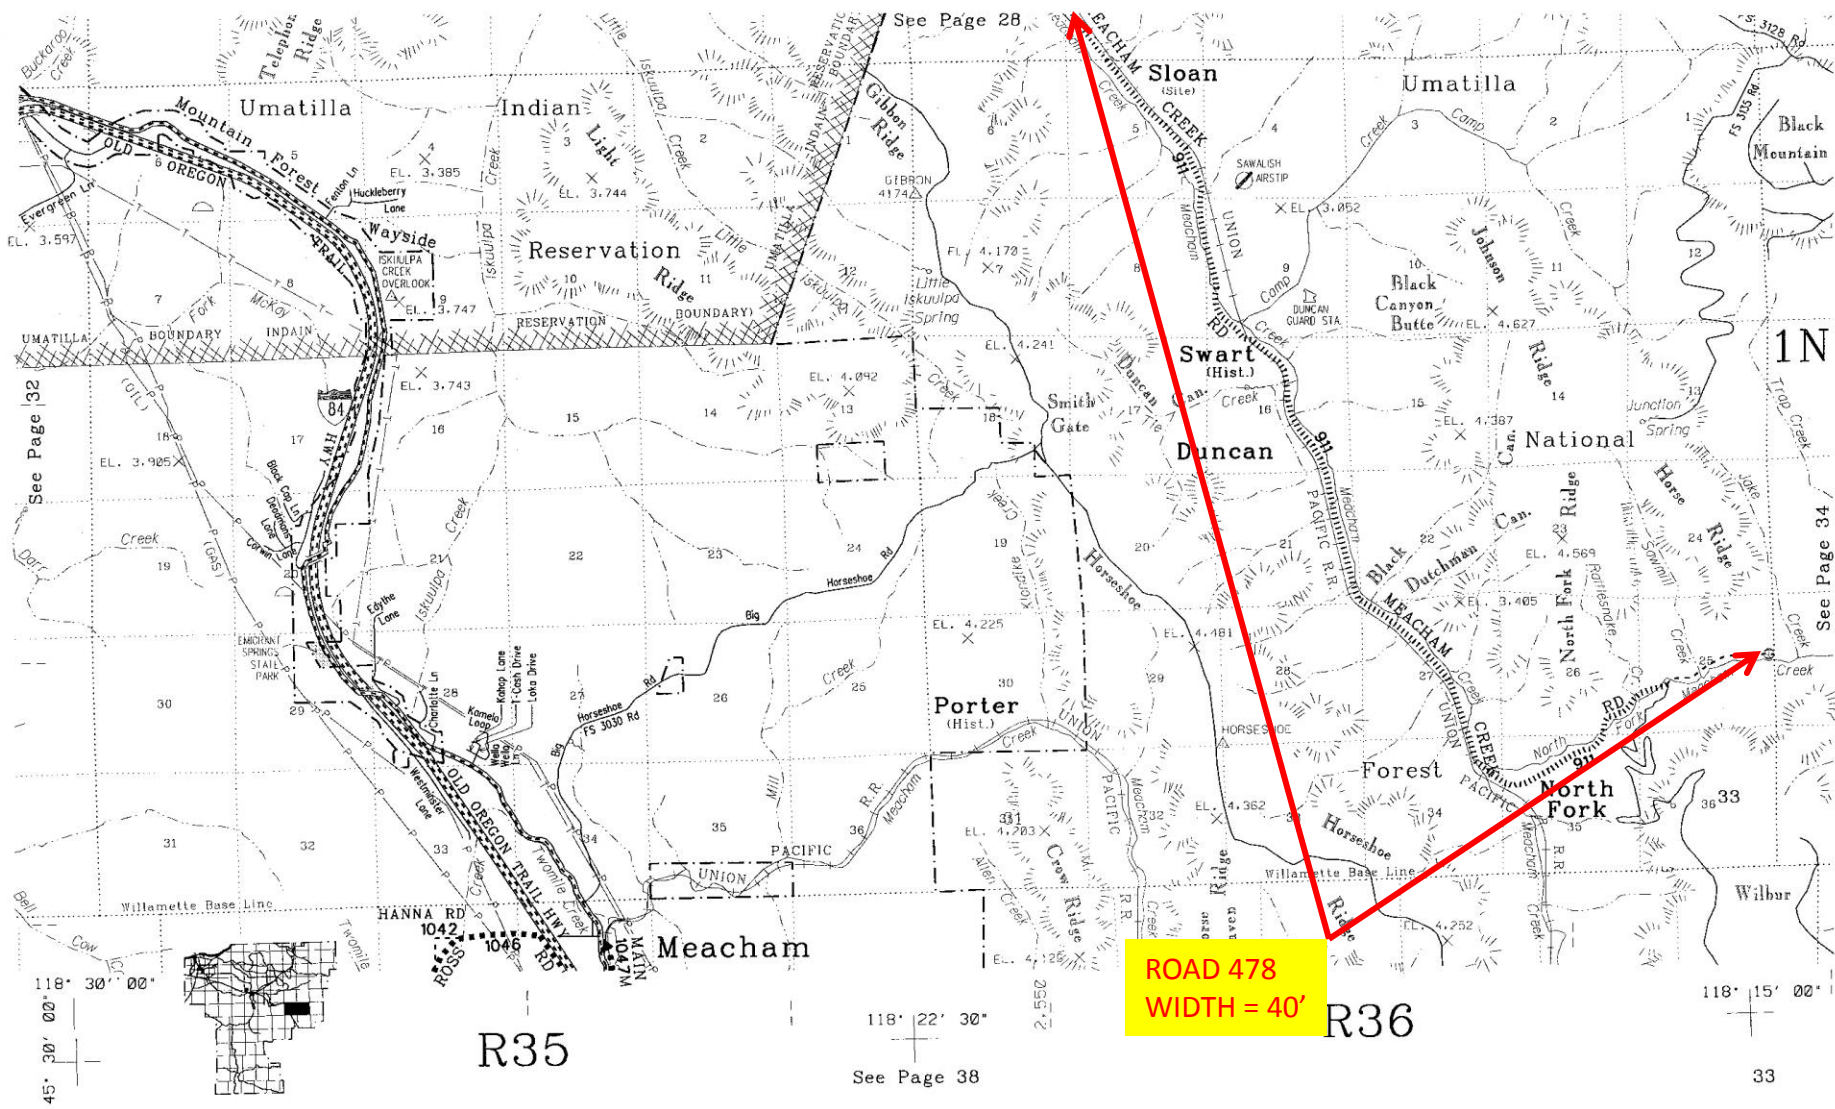

**ROAD 478  
WIDTH = 40'**

R35

R36


See Page 38

33

See Page 32

See Page 34

See Page 28

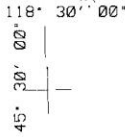

45° 30' 00"  
118° 30' 00"

118° 15' 00"

