


T 3 N., R. 34 E. W.M.
T. 2 N., R. 34 E. W.M.

UMATILLA COUNTY ROAD DEPARTMENT
 County Road No. 751 R/W 60 ft.
 Project CAYUSE BRIDGE Job # 286
 Section 3, Twp. 2N., Rg. 34 E.W.M.
 COUNTY ROADMASTER The COUNTY COURT
 E.F. PALMER D.R. COOK
 Date: April 3, 1969 R.E. REES
 Scale: 1" = 400' R.R. BEVANS

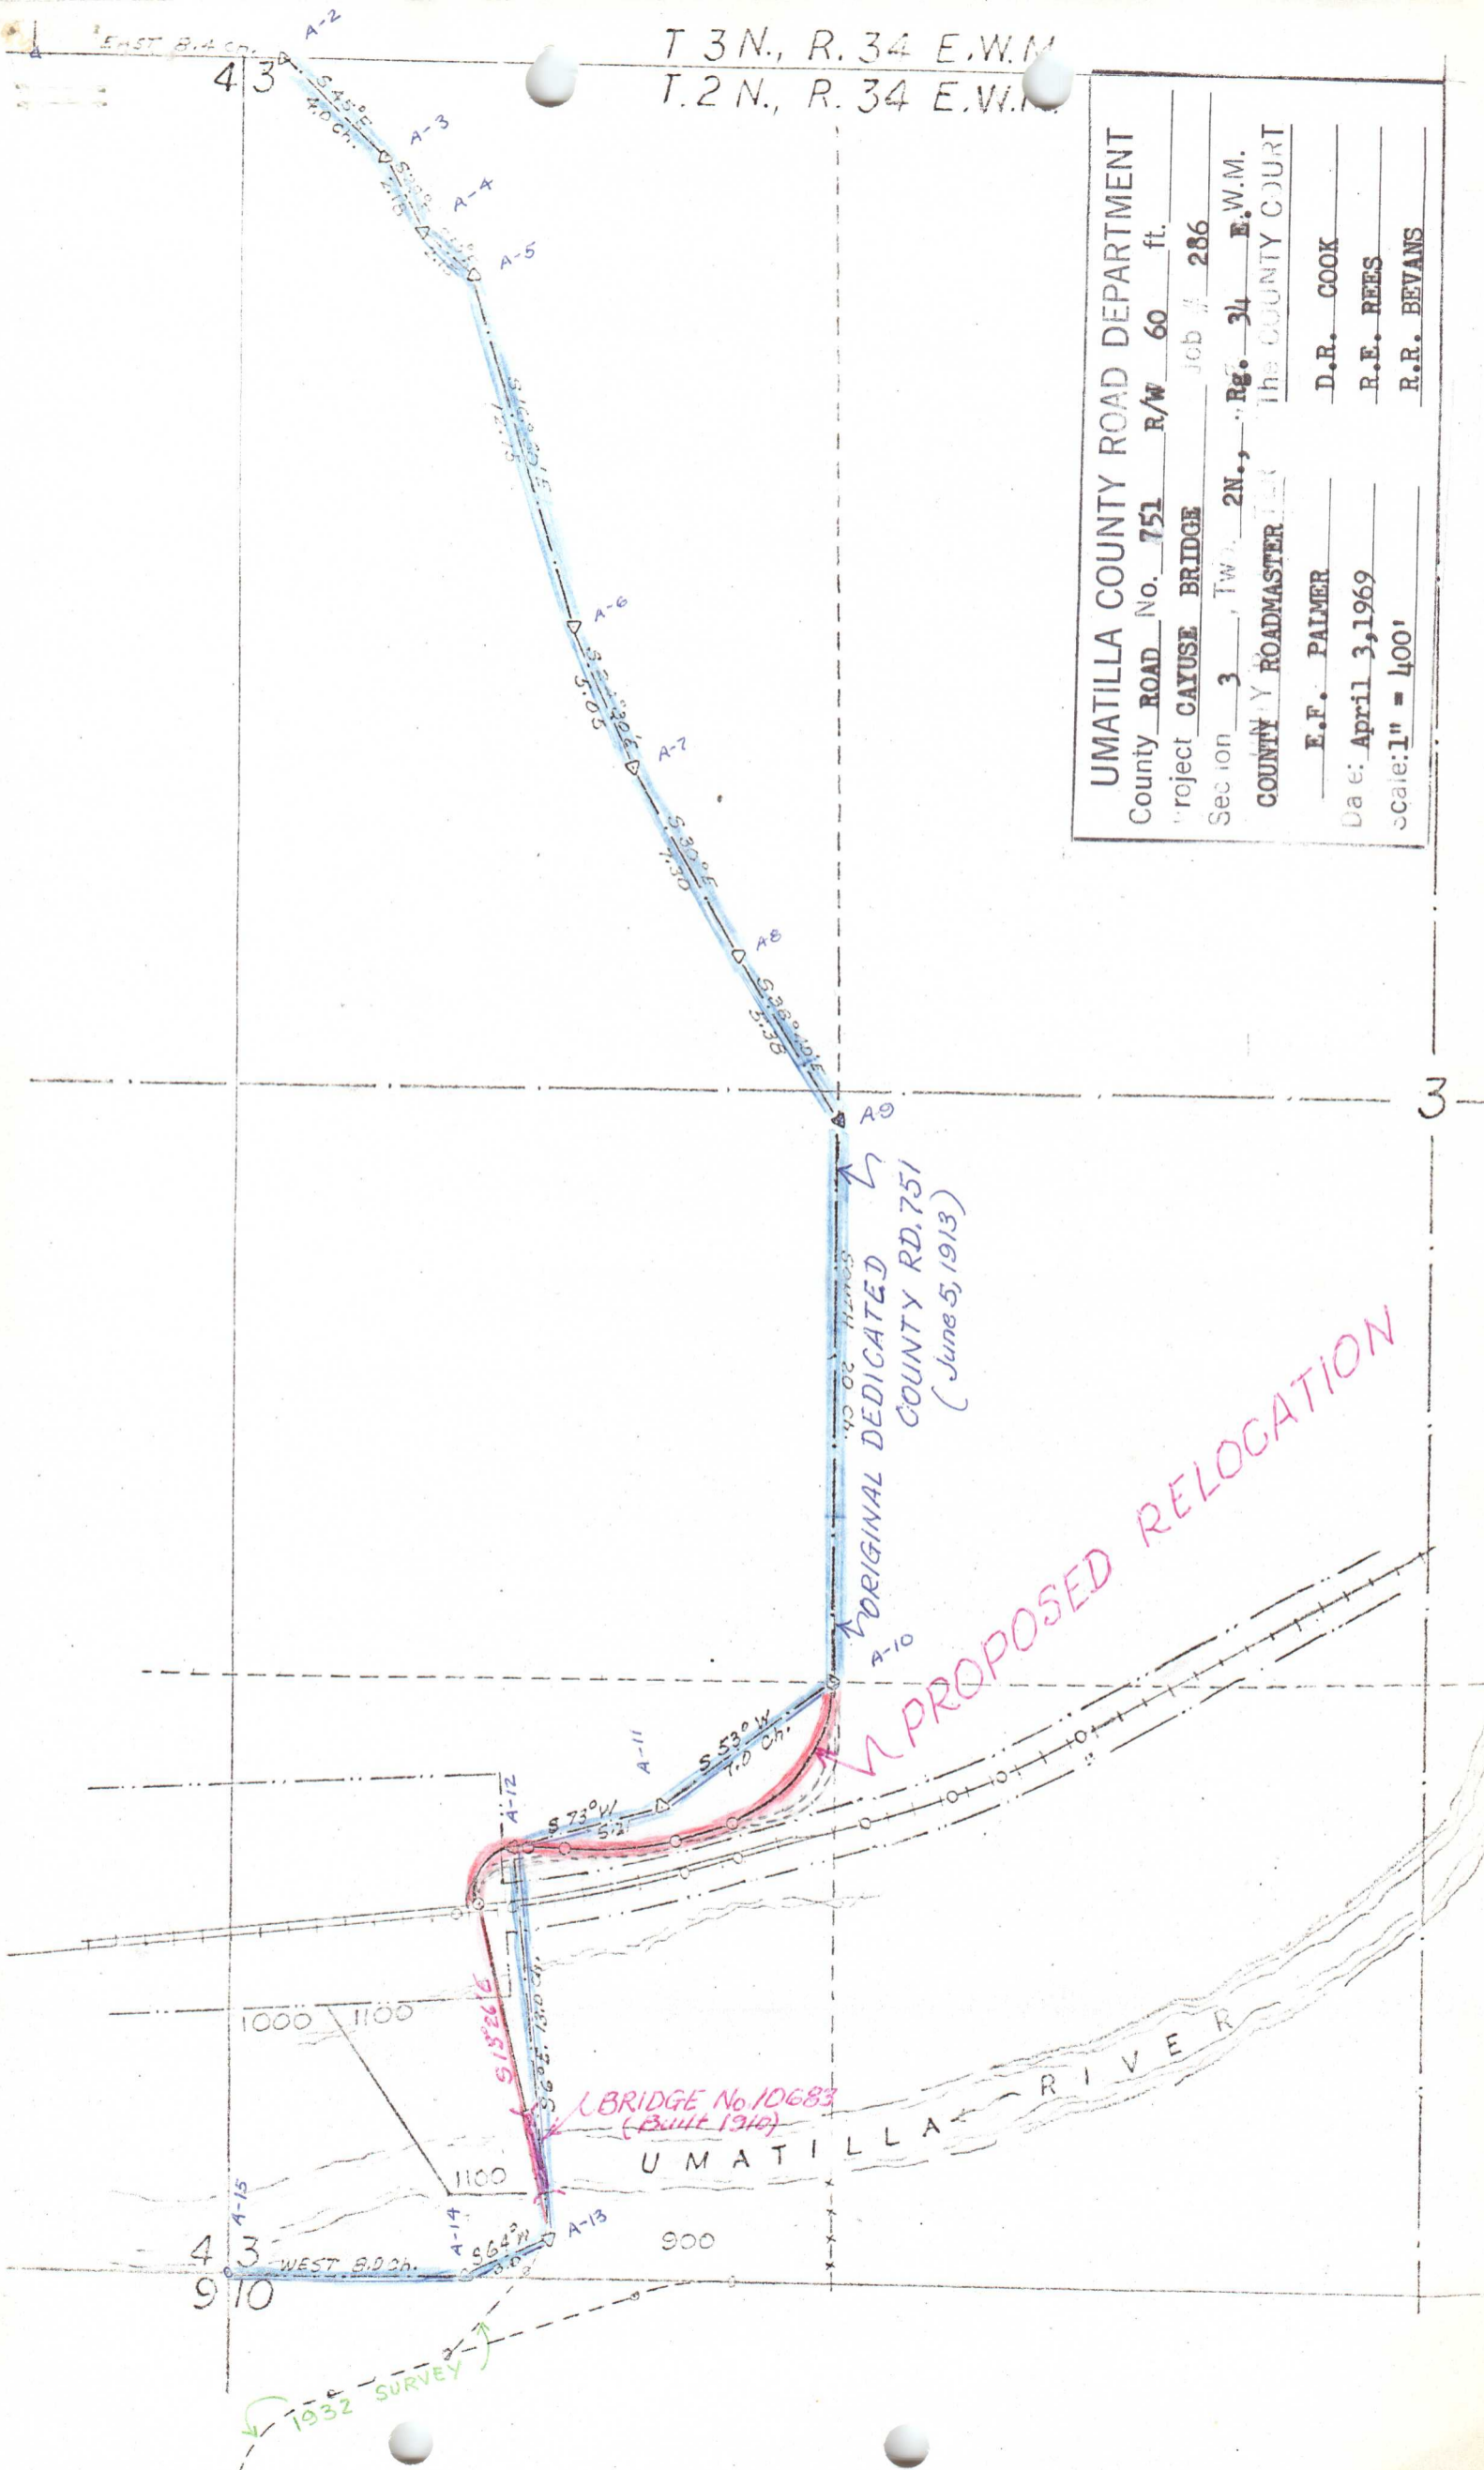

3