


This Plat is not  
CORRECT - IT IS Road  
No 658

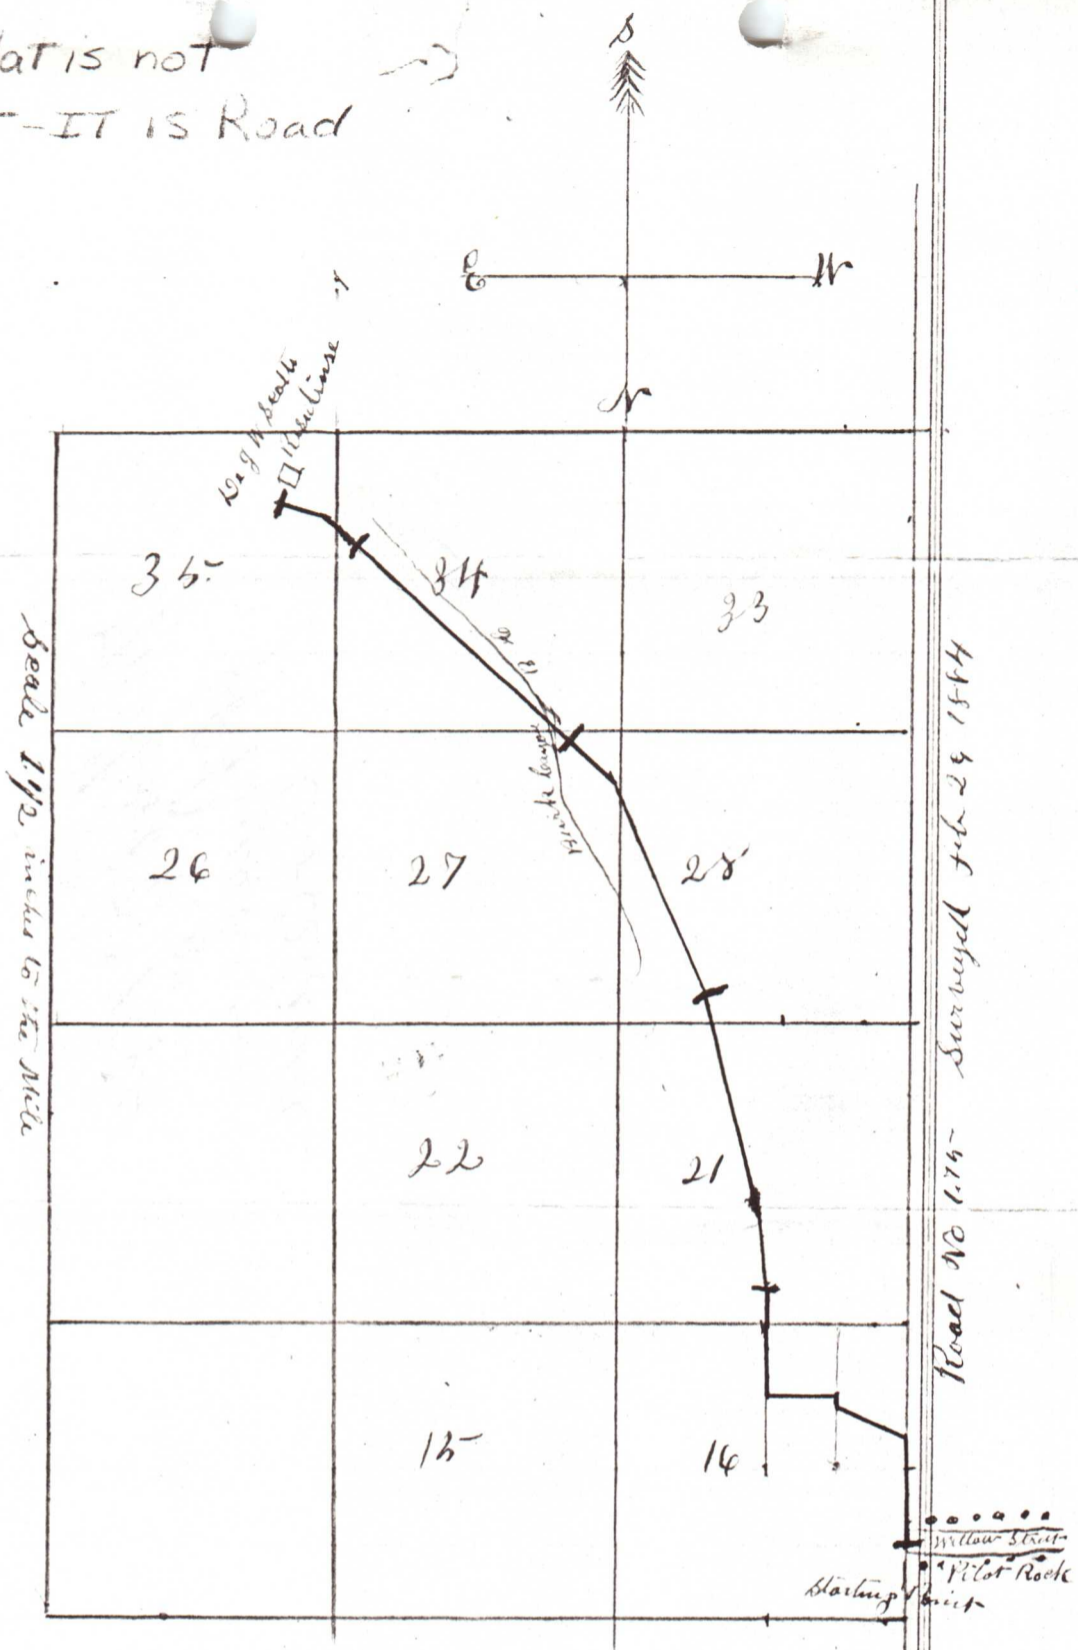

I hereby certify that this is a  
True Plat of Road Survey No 175 -  
from Pilot Rock to W. W. Scott's Residence  

W. W. Bairnes  
Surveyor