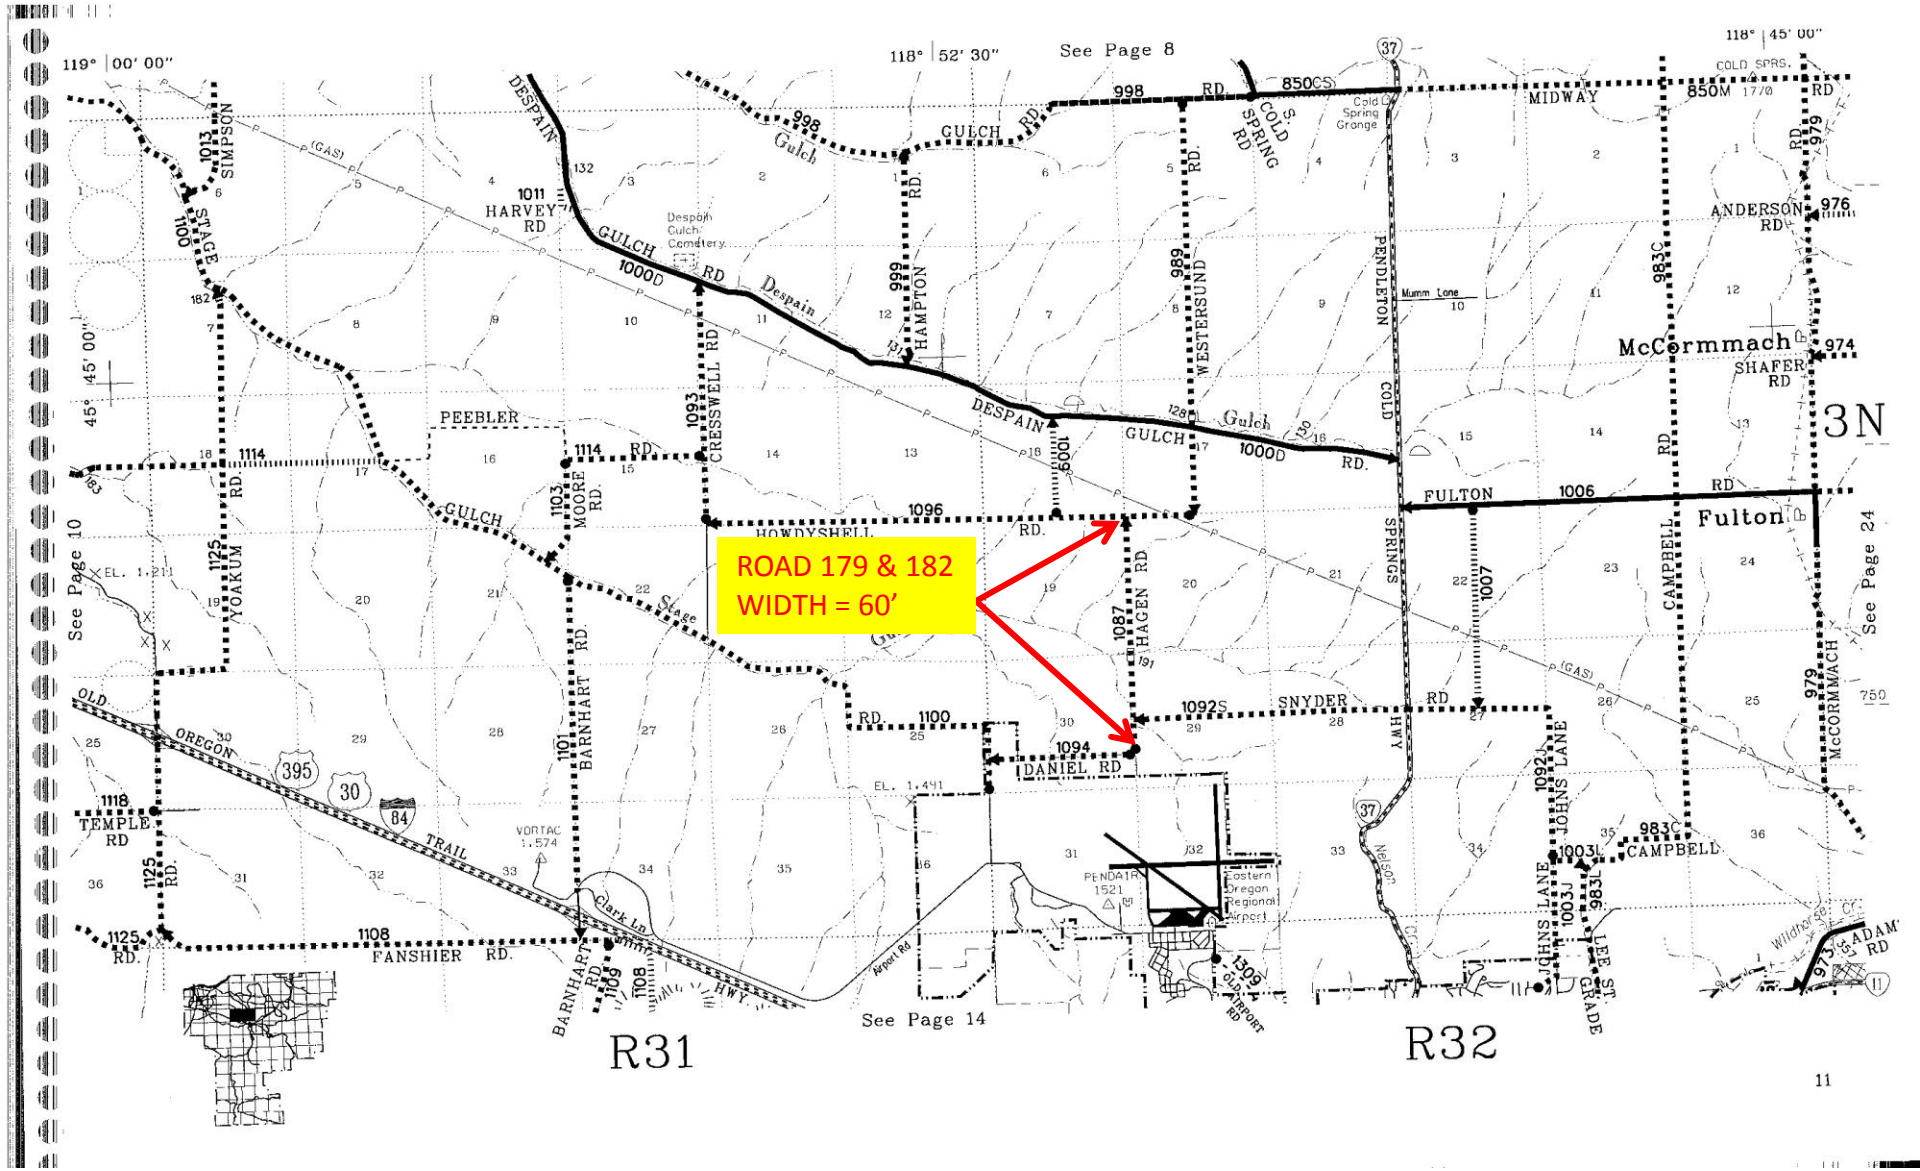
ROAD 179 & 182
WIDTH = 60'
See Page 8
See Page 10
See Page 14
See Page 24
R31
R32
3N
DESPAIN GULCH RD
HARVEY RD
HAMPTON RD
WESTERSUND RD
PENDLETON
COLD SPRINGS HWY
MIDWAY
ANDERSON RD
McCormmach
SHAFER RD
FULTON RD
Fulton
CAMPBELL RD
McCORMMACH
SNYDER RD
DANIEL RD
HAGEN RD
HOWDYSHELL RD
CRESSWELL RD
PEEBLER
MOORE RD
BARNHART RD
YOAKUM RD
SIMPSON
STAGE
TEMPLE RD
FANSHIER RD
OLD OREGON TRAIL HWY
JOHNS LANE
LEE ST GRADE
Eastern Oregon Regional Airport
Despain Gulch Cemetery
Cold Spring Grange
Mumm Lane
Clark Ln
Airport Rd
Nelson Cr
Wildhorse Cr
VORTAC 1.574
PENDAIR 1521
119° 00' 00"
118° 52' 30"
118° 45' 00"
45° 45' 00"