


ROAD 248  
WIDTH = 60'

BY DEED  
WIDTH VARIES

?

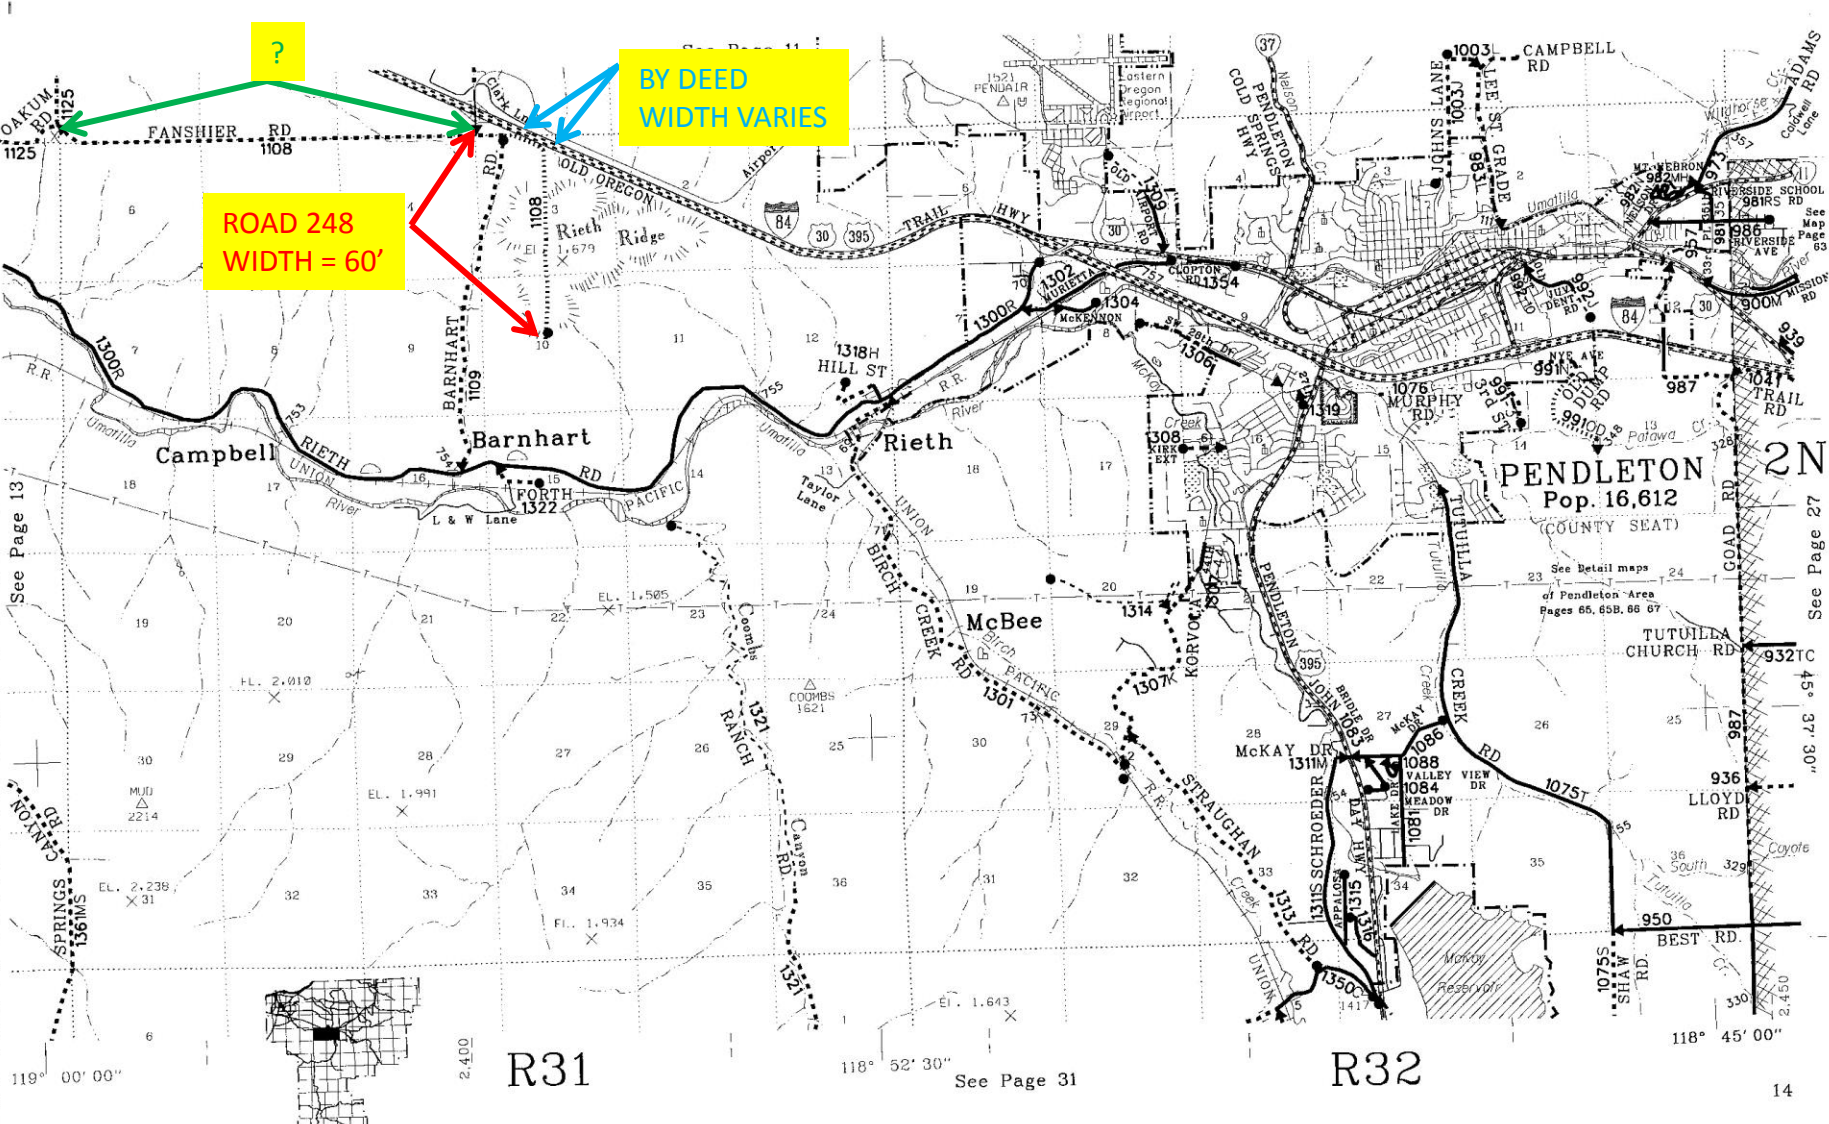

See Page 13

See Page 27

119° 00' 00"

118° 52' 30"

118° 45' 00"

R31

R32

See Page 31

14