

119° 15' 00"

See Detail Map Page 68

See page 7

119° 07' 30"

119° 00' 00"

STANFIELD MDWS: 1332SM

STAGE GULCH RD 1186

STAGE GULCH RD 555

**ROAD 288
WIDTH = 60'**

**ROAD 300
WIDTH = 60'**

1342 ANDREWS RD

1366 OLD HWY 320

WHITMORE RD 1124

PEEBLER RD 1127

3N

1347M ECHO MEADOWS RD

ECHO Pop. 699

OREGON RD 1116

LORENZEN RD 1127

See Page 11

1347S SNOW RD

1300R

1118 TEMPLE RD

1118

1343 WHITEHOUSE RD

1300R

1362 Nolin CEMETERY


1300R

10

R29

See Page 13

R30

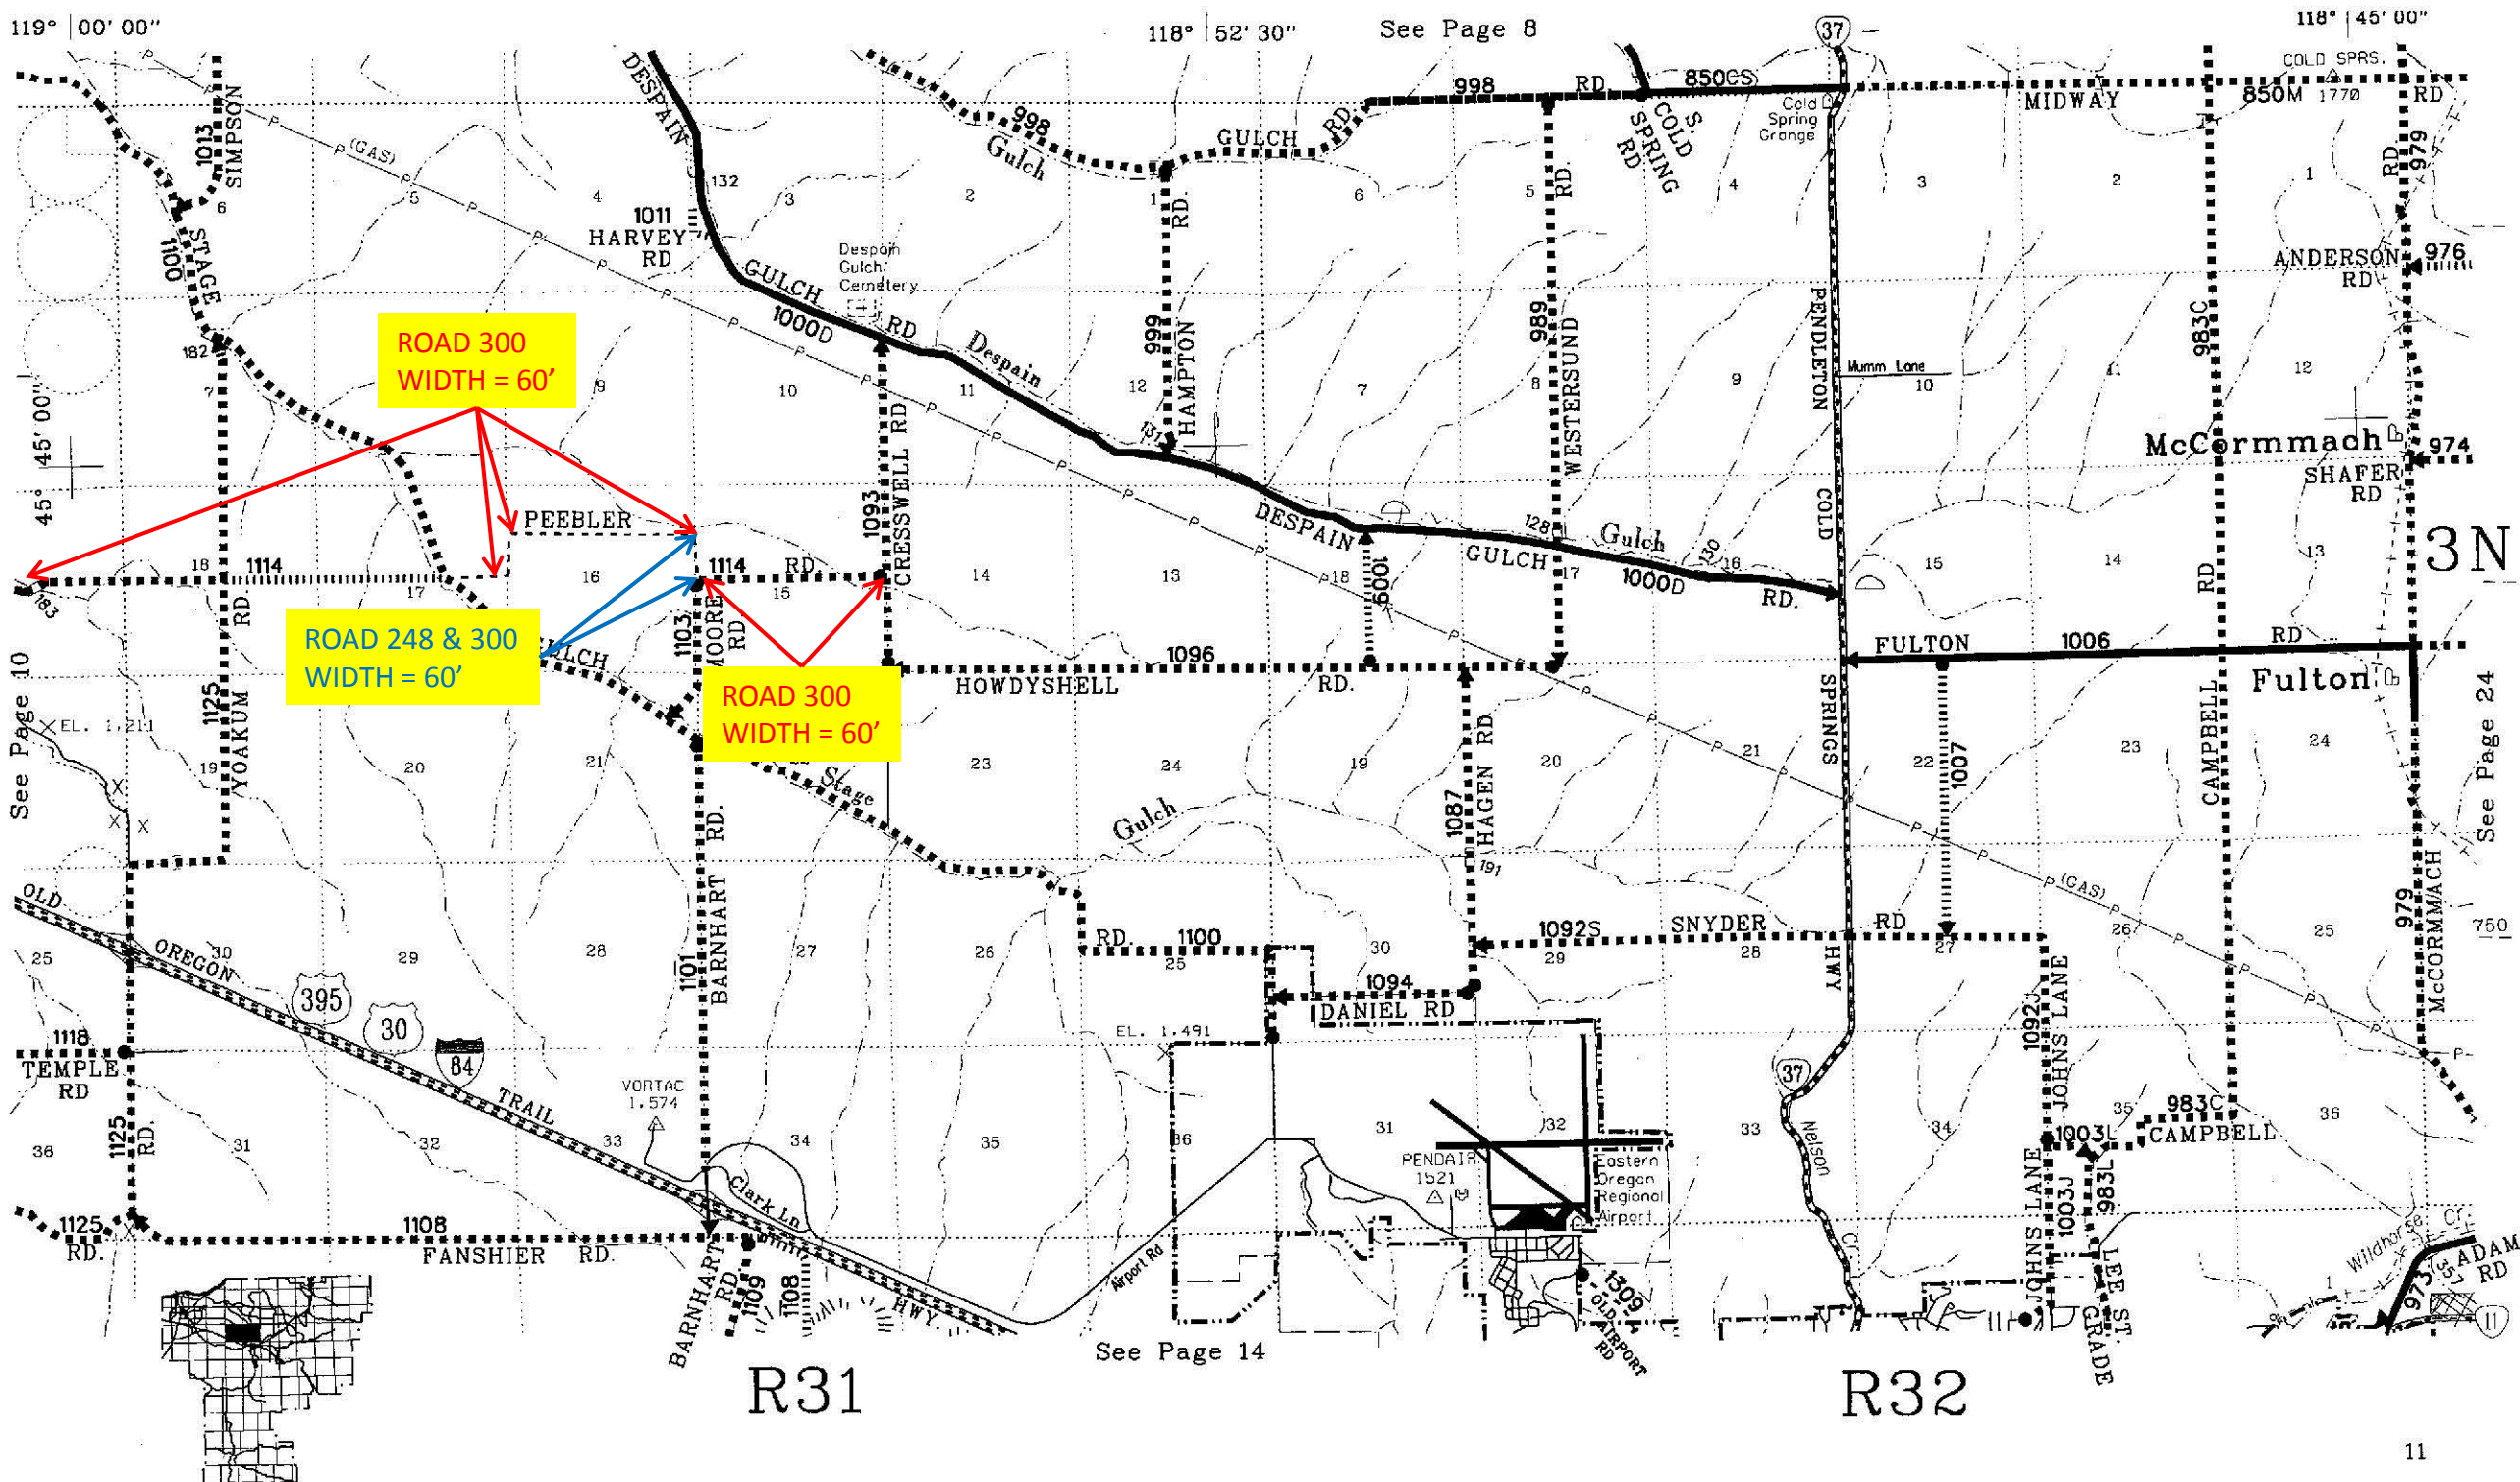

See Page 10

See Page 8

See Page 14

See Page 24



R31

R32