


PLAT OF COUNTY ROAD No. 730
INT. 4 N. R. 28 E. W. M.

SURVEYED OCT. 26 1911
Scale 25 Chs. = 1 In.

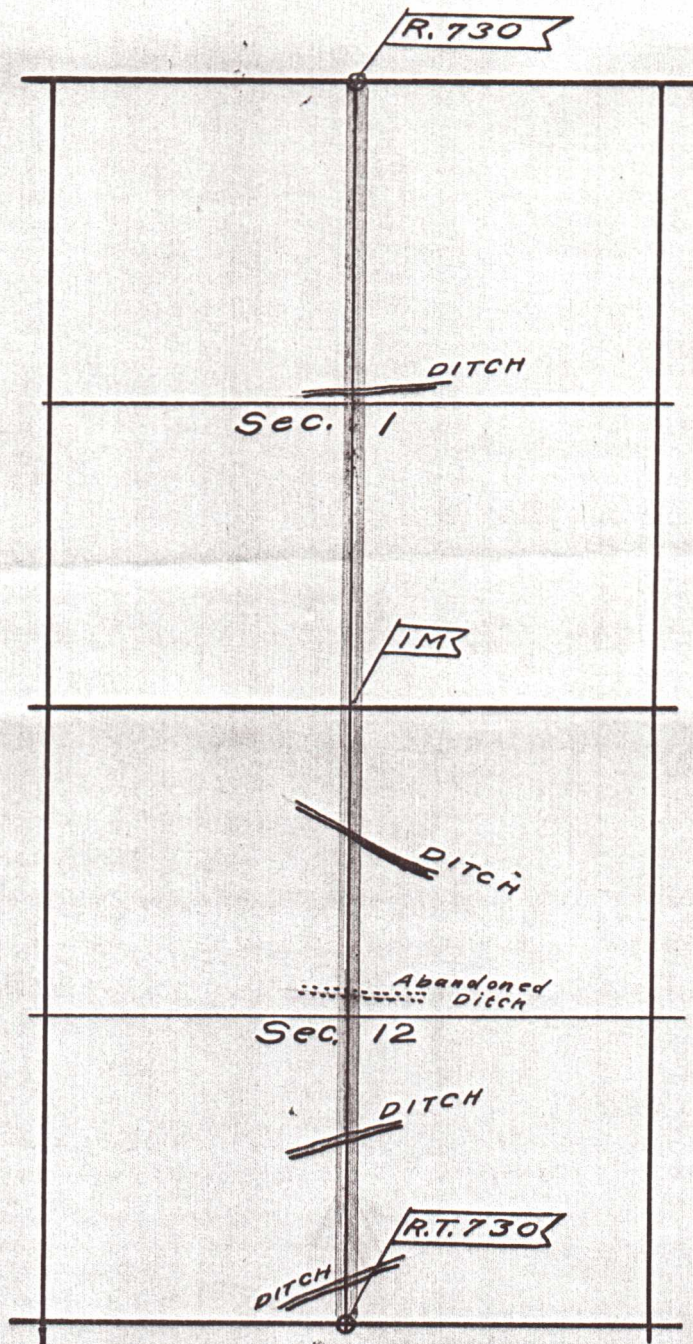

Geary Kimbrell
County Surveyor