


PLAT OF COUNTY ROAD NO. 754

INT. 5 N. R. 28 E. W. M.

SURVEYED July 29 1913

Scale 25 Chs. = 1 In.

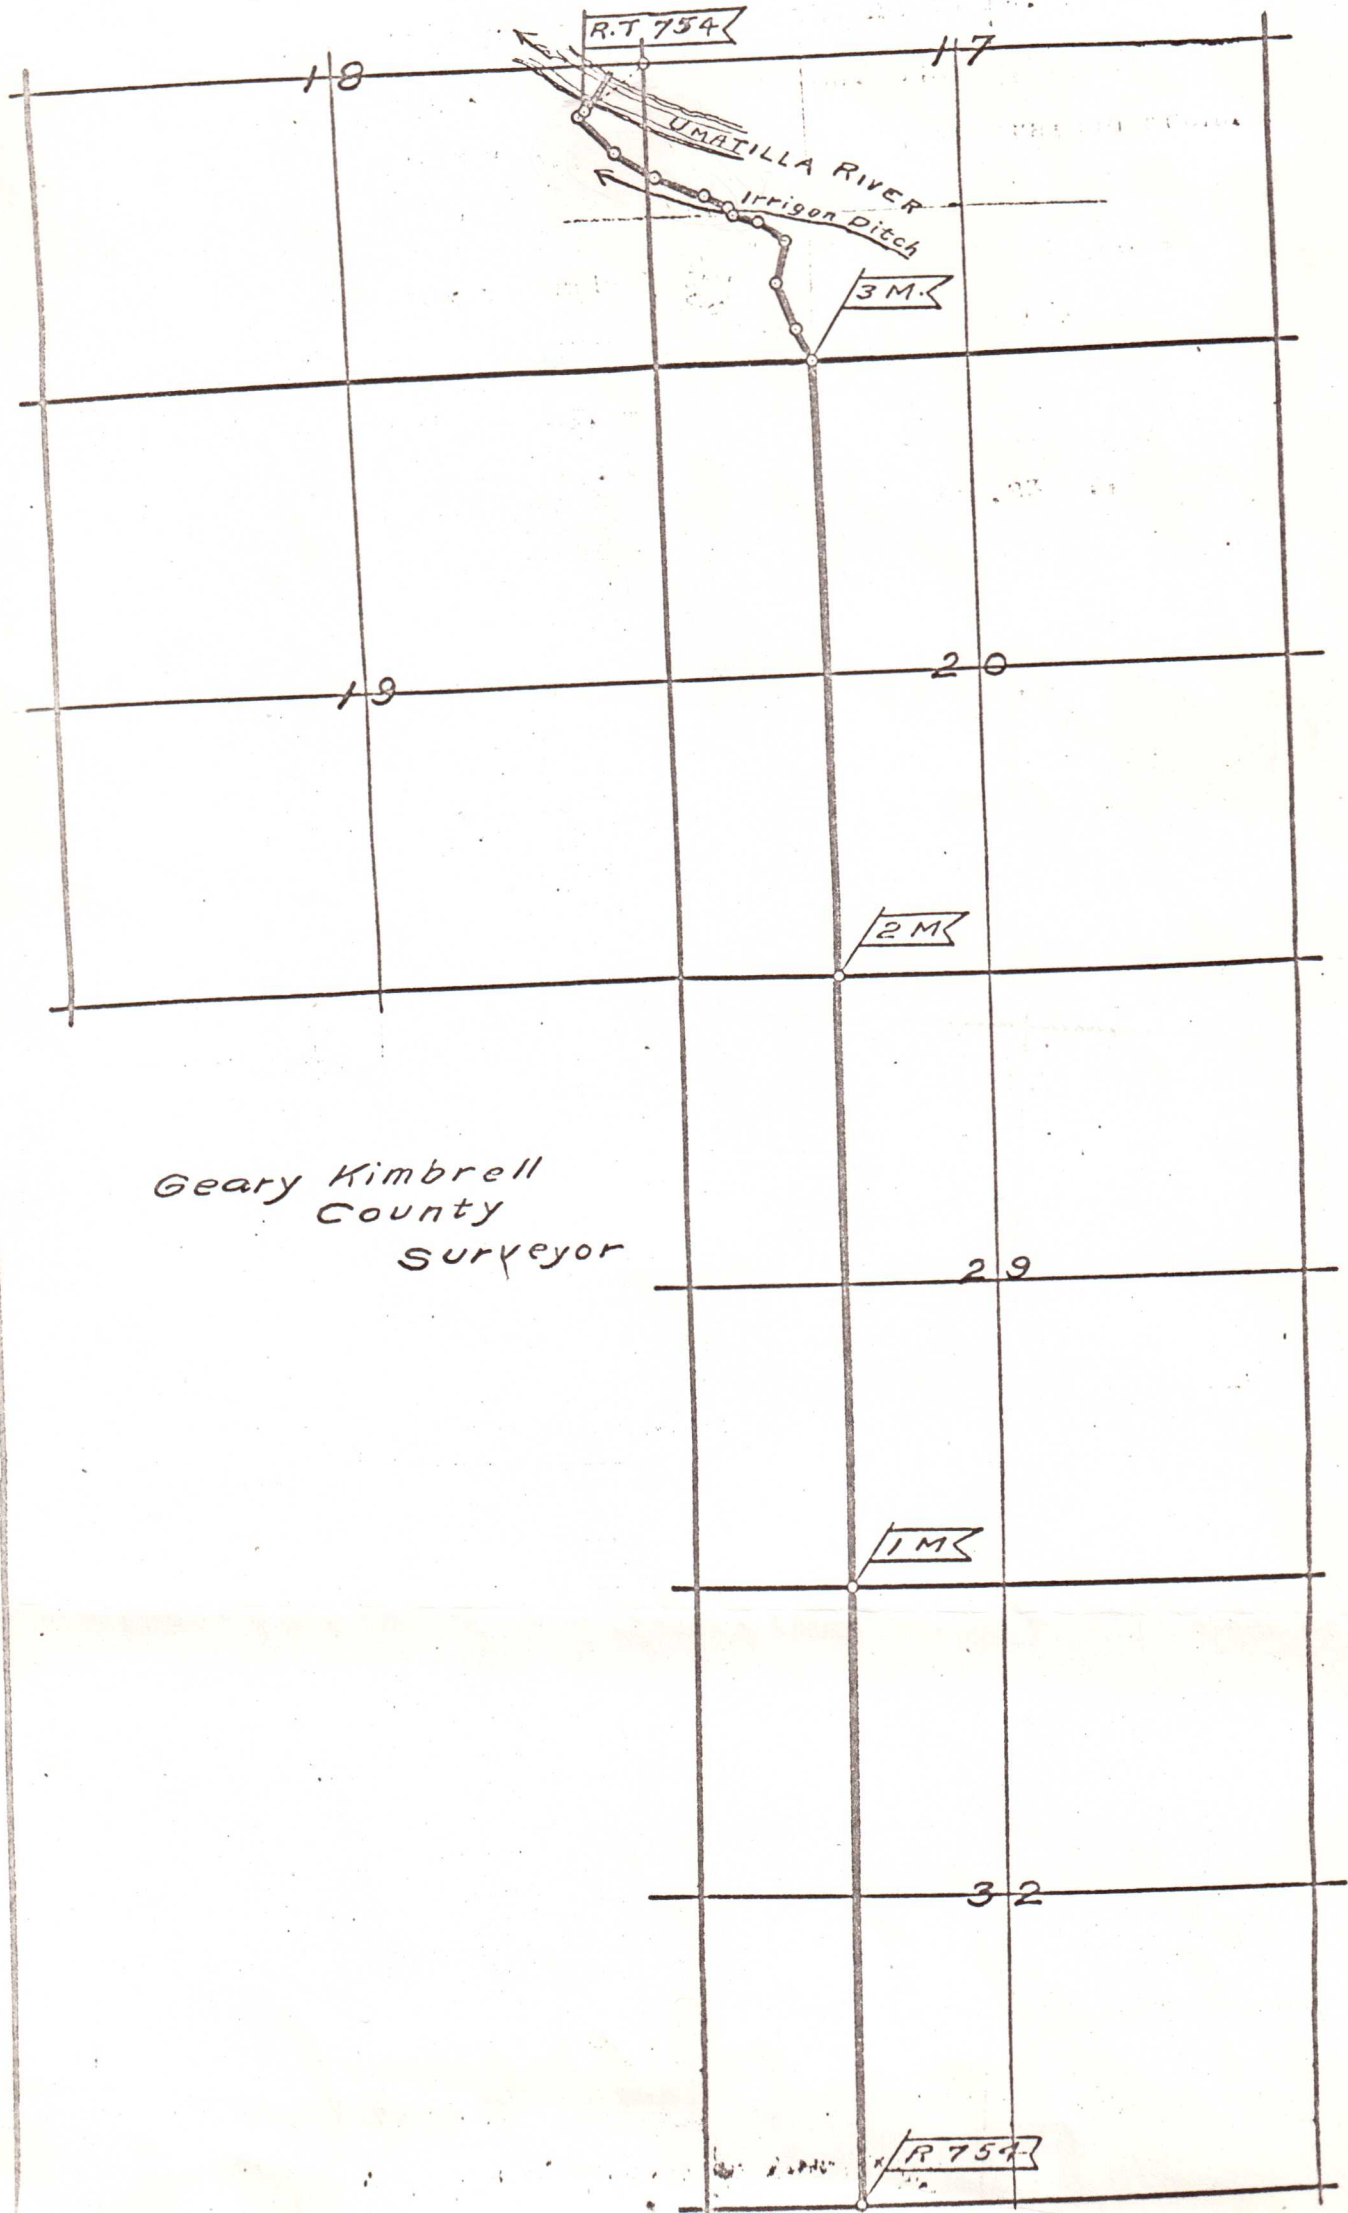

Geary Kimbrell  
County  
Surveyor

R 754