


598

Plat of Road No. 598

in Township

R.T. No. 598

4 North Range 28 E W M Oregon
1st Standard North

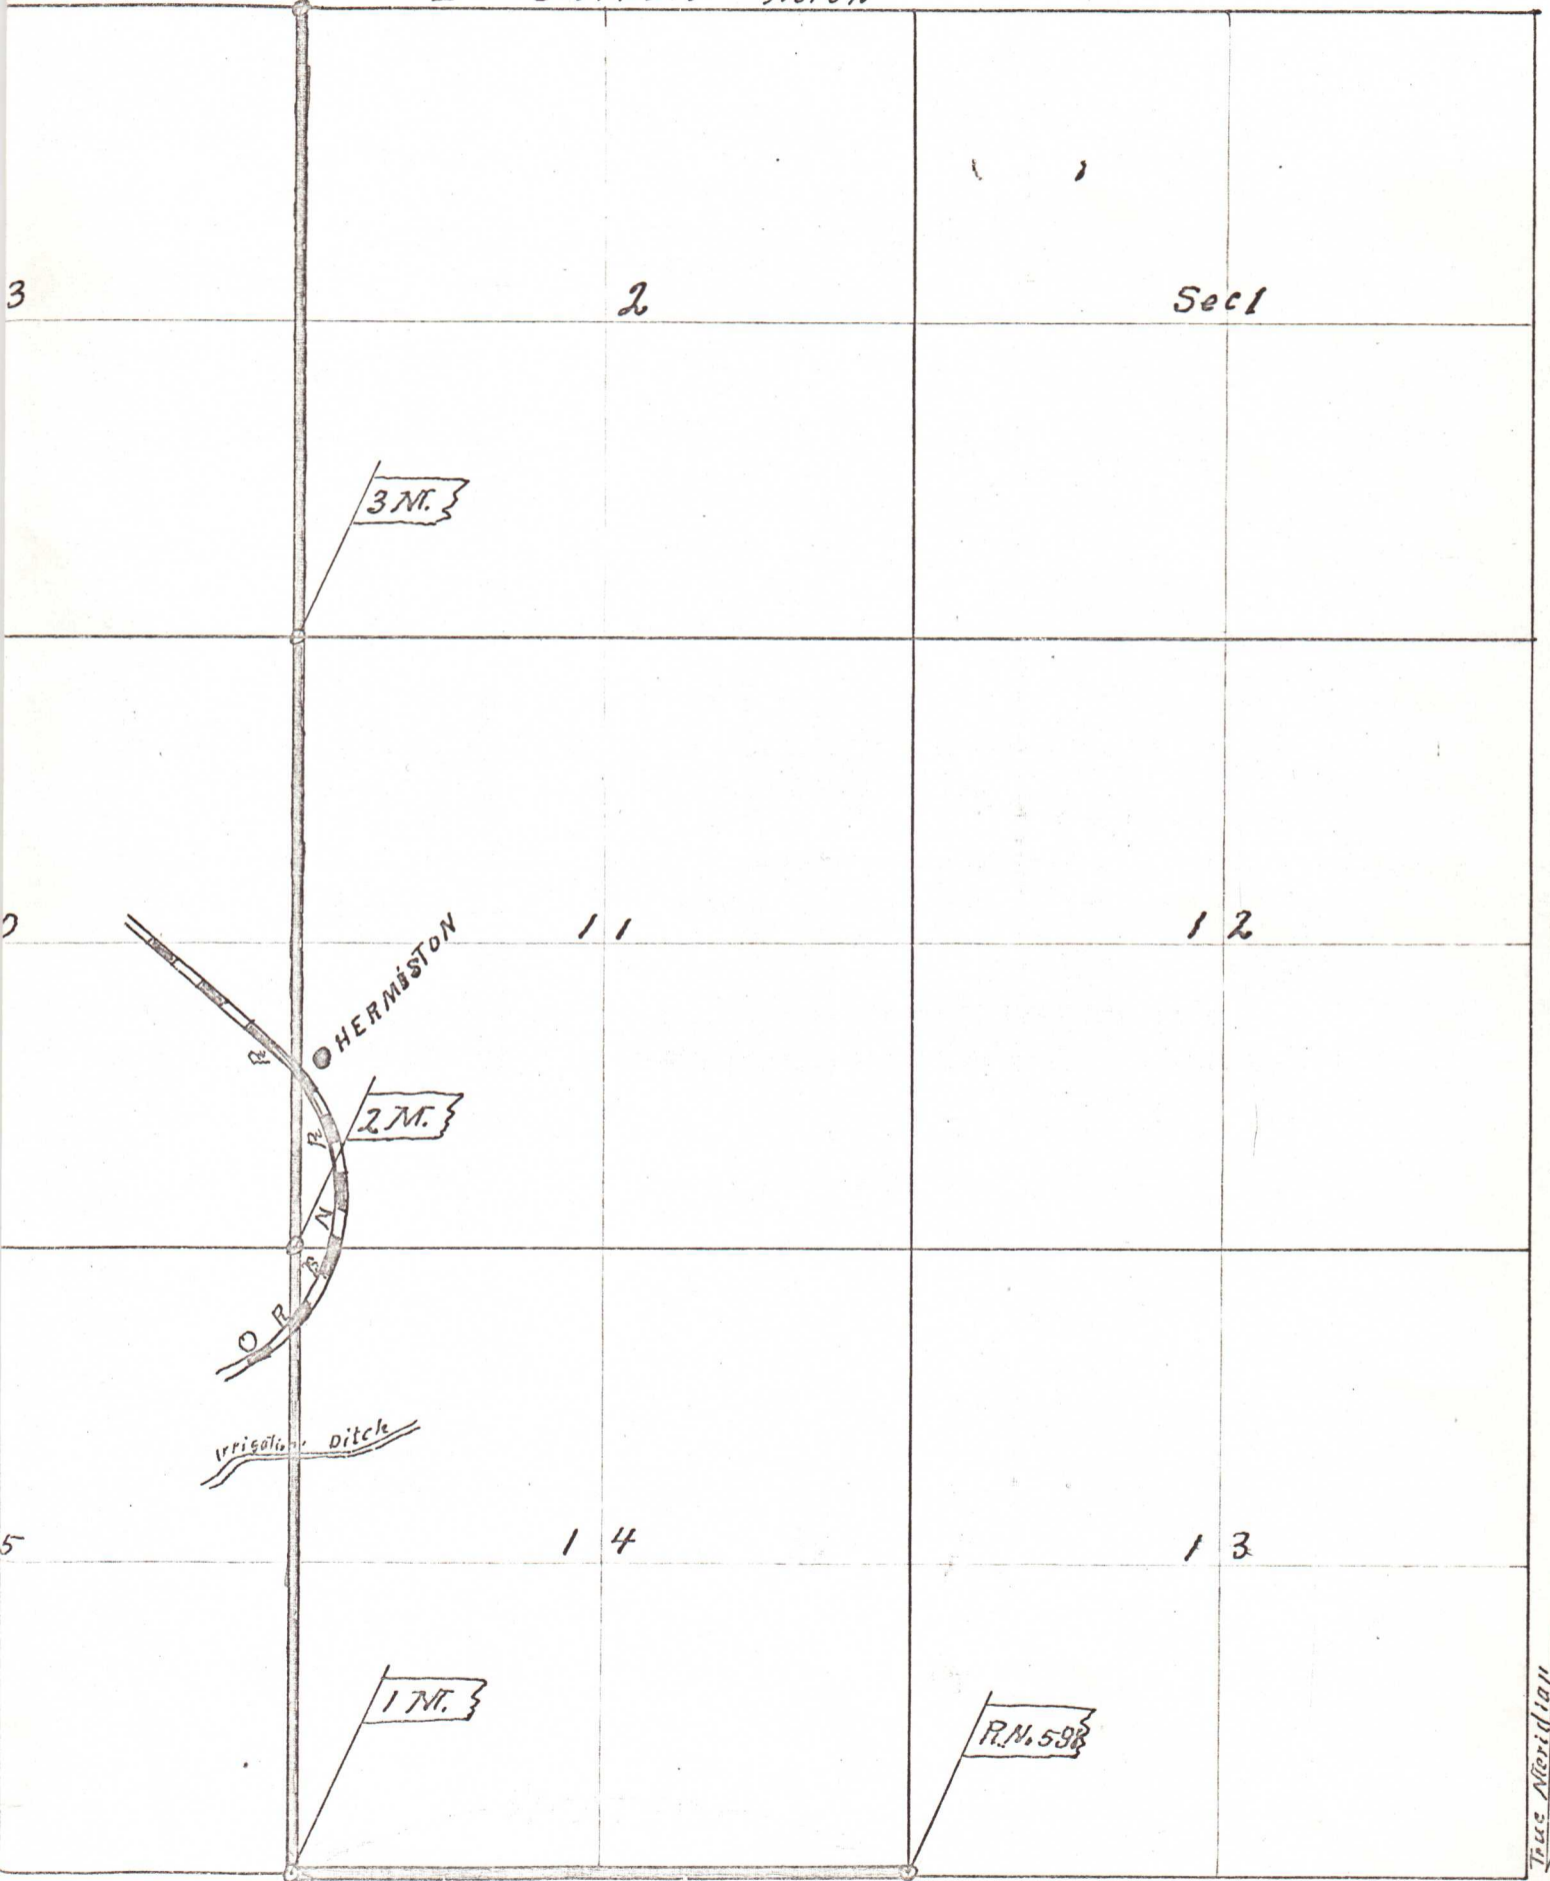

True Meridian
Mag. Var. 20
SC