DETAIL MAP AS CONSTRUCTED
OREGON STATE HIGHWAY DEPARTMENT

UMATILLA OIL DEPOT
ACCESS ROAD PROJECT

UMATILLA COUNTY


4F 22-6
SH. 1

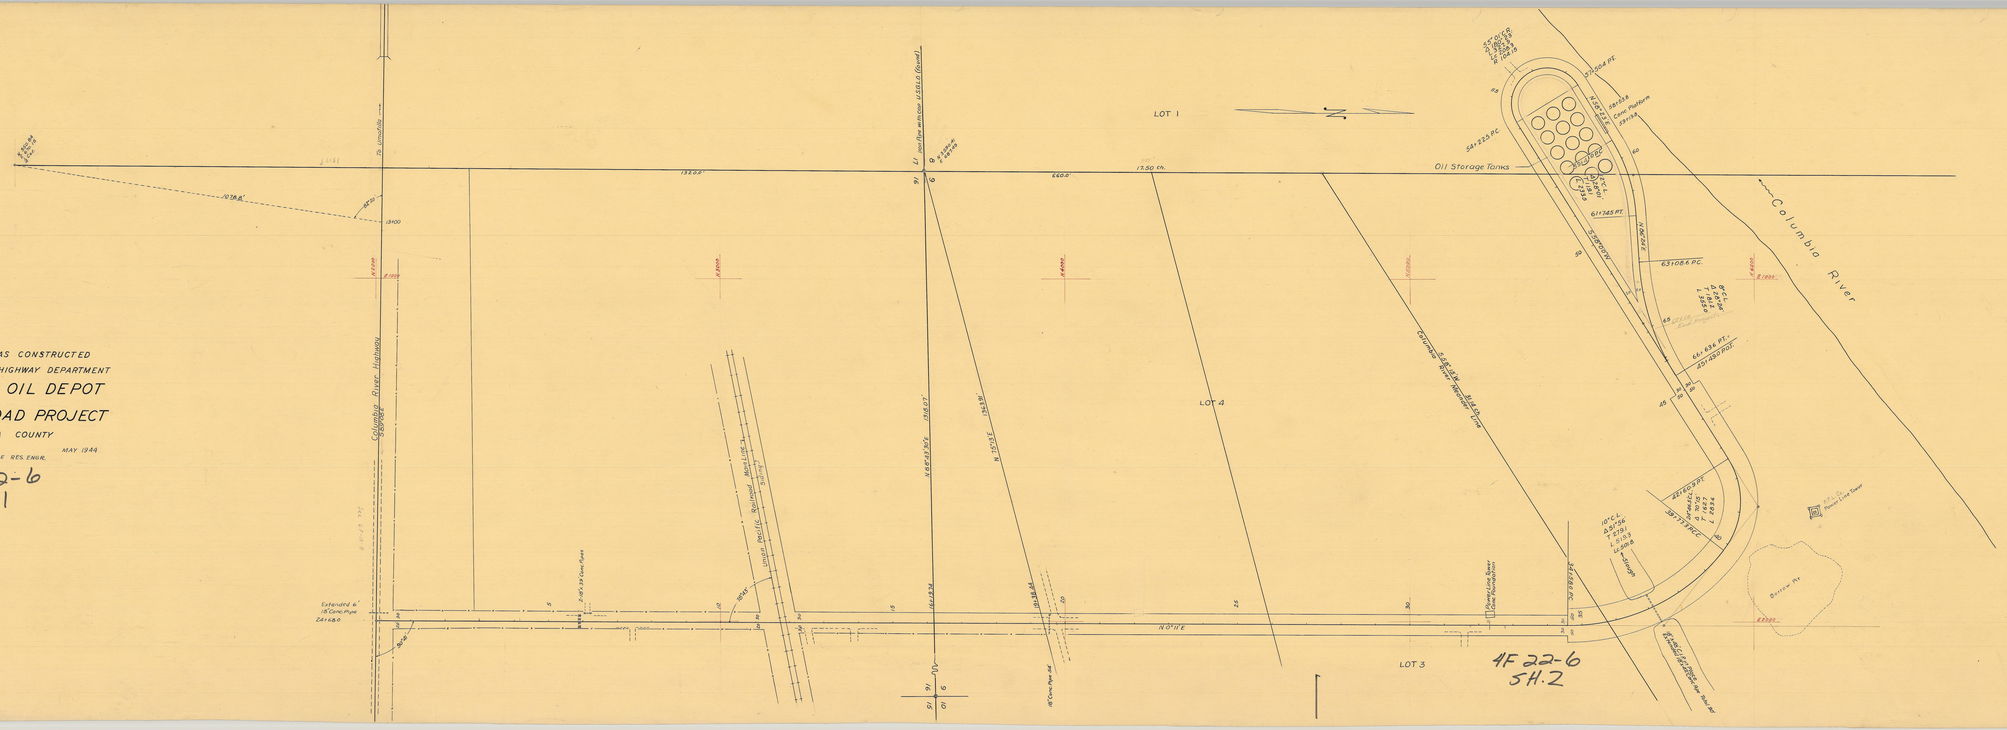
LOT 1
LOT 4
LOT 3
Oil Storage Tanks
Columbia River
Columbia River Highway
Union Pacific Railroad
Main Line
Columbia River Highway
Extended 6" 15 Conc. Pipe
Cement Pipe Culvert
Pump Line Sewer
Concrete Foundation
