


WASHINGTON

STATE

TRANSFERRED TO CITY OF UMATILLA
2015

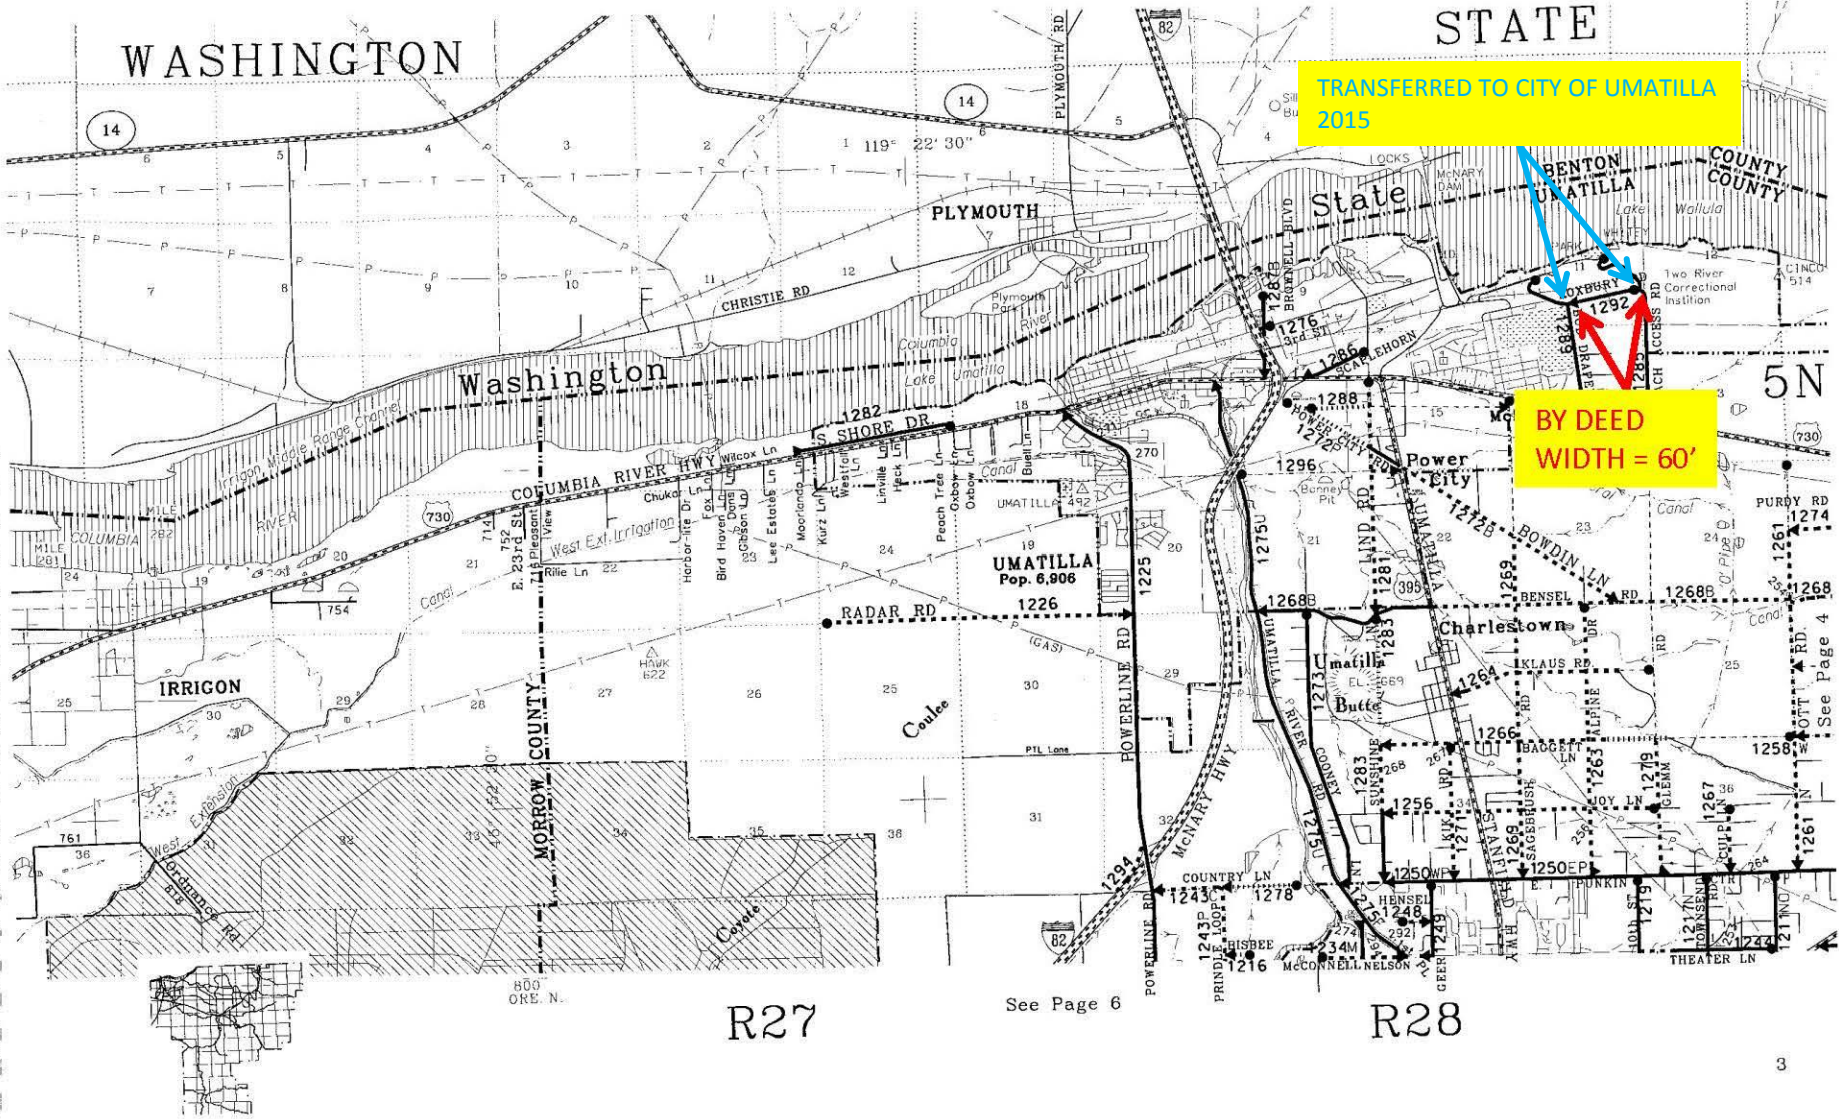

BY DEED
WIDTH = 60'

R27

See Page 6

R28