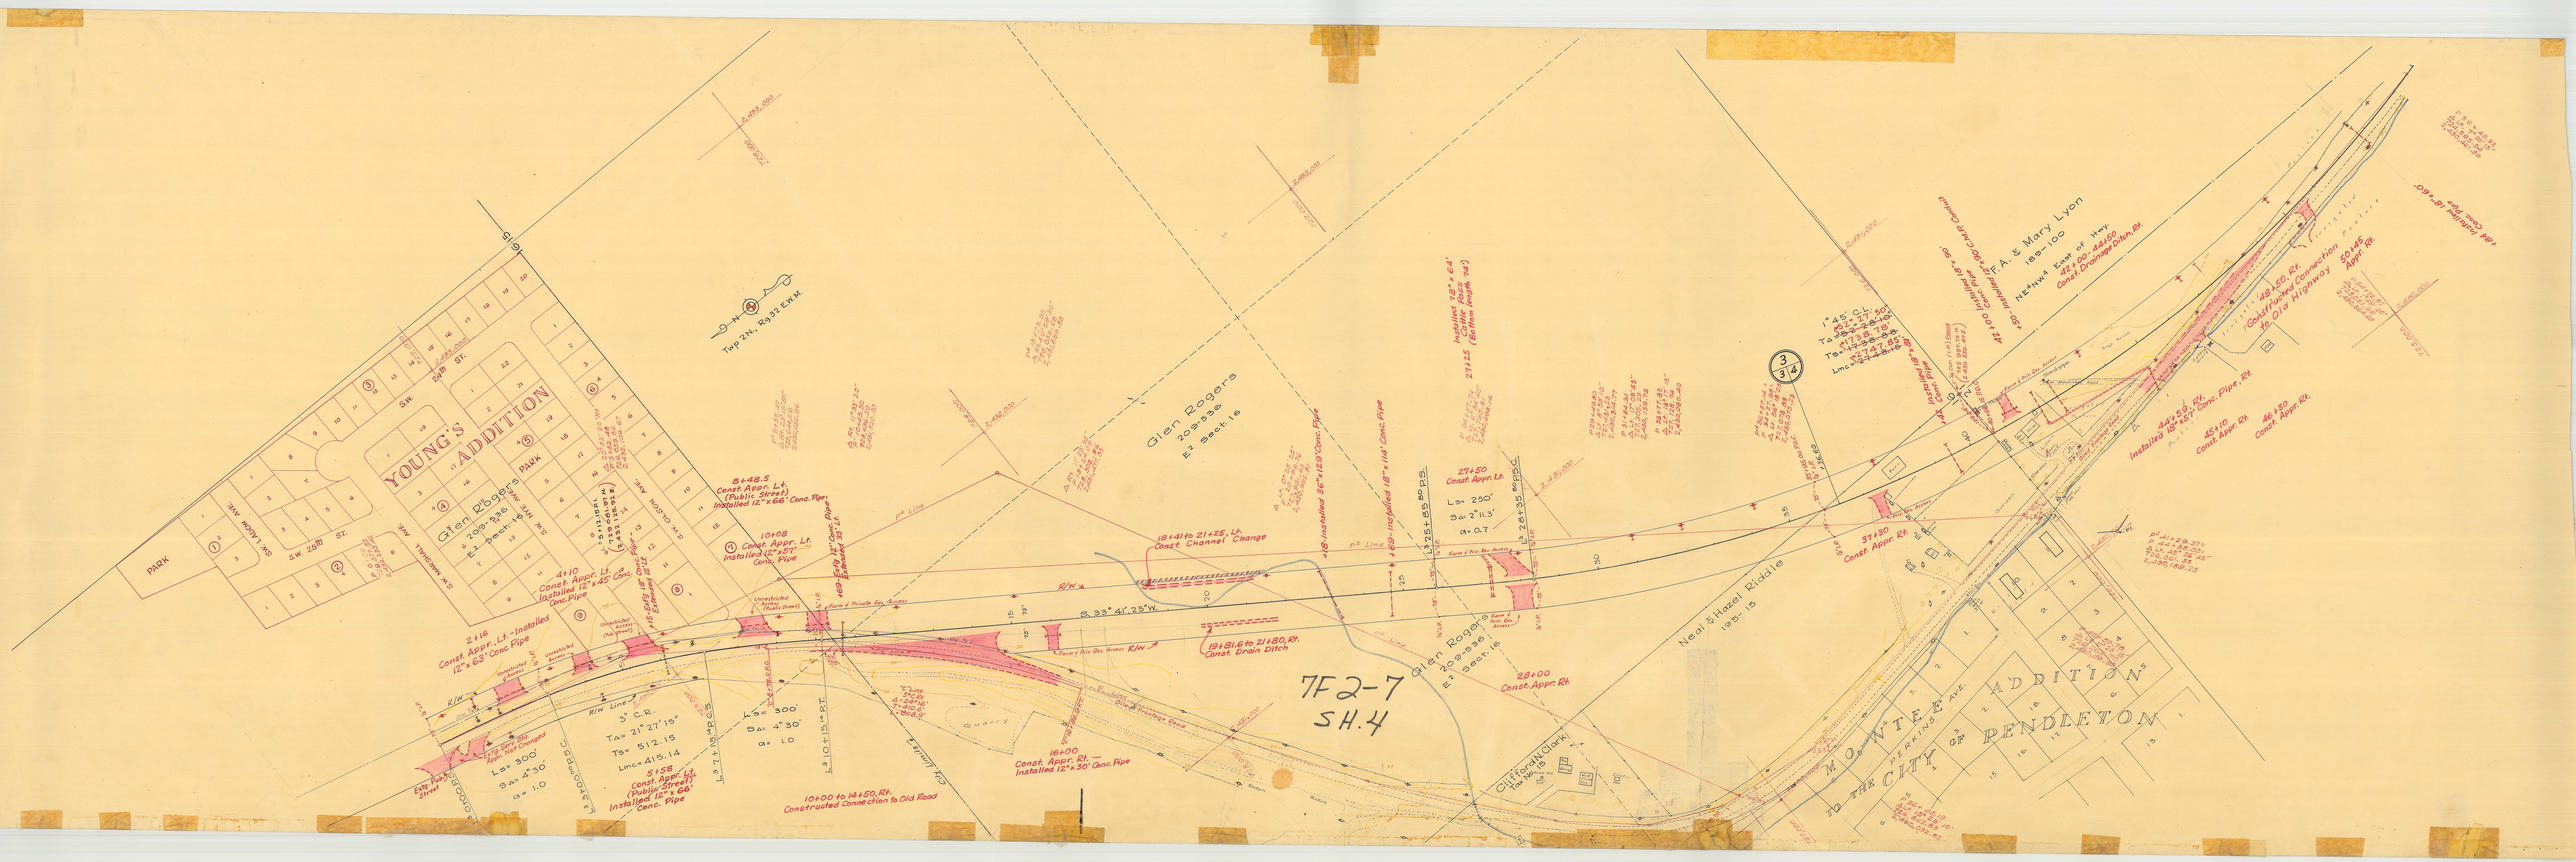
YOUNG'S ADDITION
Glen Rogers
209-236
E2 Sect. 16
PARK
S.W. 23RD ST.
S.W. MAXWELL AVE.
S.W. LAGOON AVE.
S.W. OLSON AVE.
S.W. 24TH ST.
Twp 2 N., R 32 E.W.M.
Glen Rogers
209-236
E2 Sect. 16
Neal & Hazel Riddle
195-15
F. A. E Mary Lyon
195-100
N2 NW4 East of Hwy
Cliff Ford & Clark
Tax No. 13
MONTE E ADDITION
TO THE CITY OF PENDLETON
PERKINS AVE.
Quarry
Old Cemetery Road
City Limits
7F2-7
SH. 4
8+48.5 Const. Appr. Lt. (Public Street) Installed 12"x66' Conc. Pipe
10+08 Const. Appr. Lt. Installed 12"x57' Conc. Pipe
4+10 Const. Appr. Lt. Installed 12"x45' Conc. Pipe
2+16 Const. Appr. Lt. - Installed 12"x63' Conc. Pipe
5+58 Const. Appr. Lt. (Public Street) Installed 12"x66' Conc. Pipe
16+00 Const. Appr. Rt. Installed 12"x30' Conc. Pipe
10+00 to 14+50 Rt. Constructed Connection to Old Road
18+41 to 21+25 Lt. Const. Channel Change
18+81.6 to 21+80 Rt. Const. Drain Ditch
18+ Installed 36"x129' Conc. Pipe
18+ Installed 18"x141' Conc. Pipe
27+50 Const. Appr. Lt.
28+00 Const. Appr. Rt.
37+30 Const. Appr. Rt.
44+50 Rt. Construct Connection to Old Highway
44+55.2 Rt. Installed 18"x82' Conc. Pipe
45+10 Const. Appr. Rt.
46+30 Const. Appr. Rt.
50+45 Appr. Rt.
