Plat of Road No. 506 — in T. 2 N. R. 32 E. W. M.

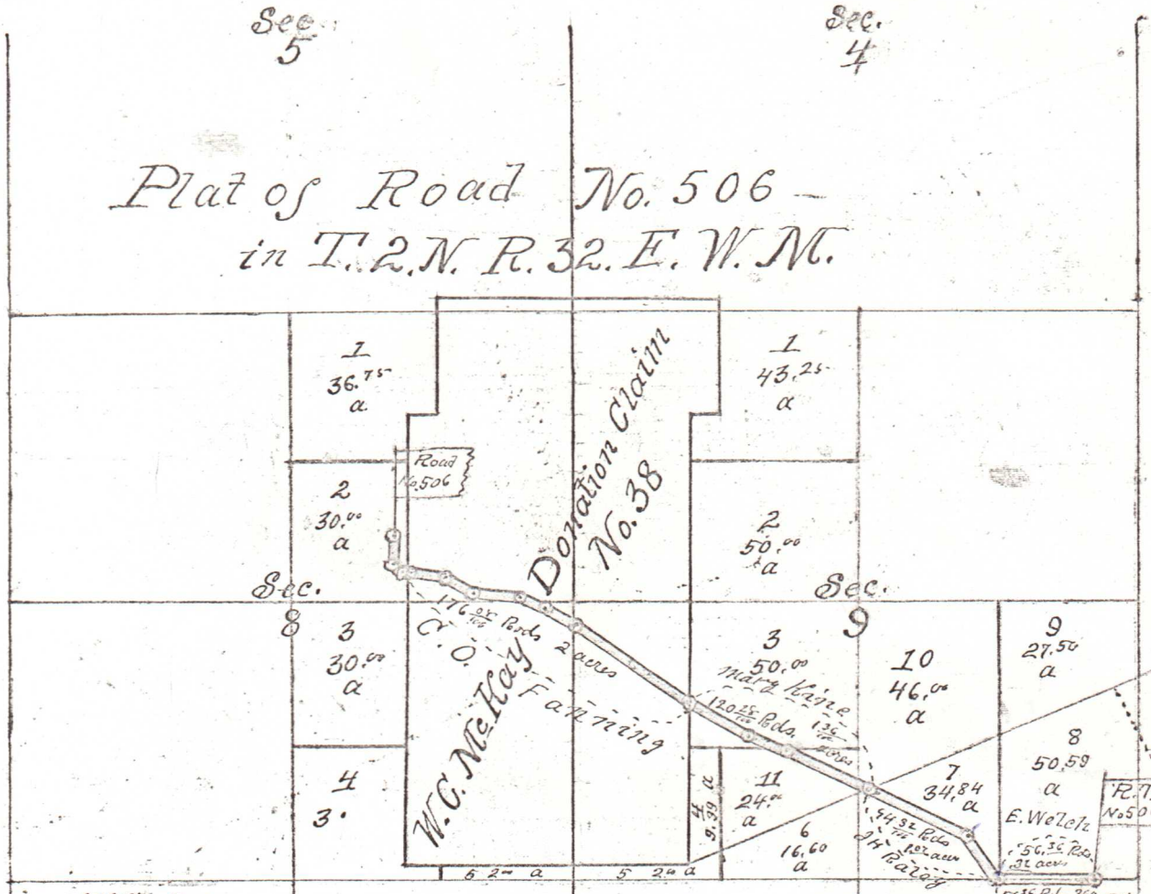

176 05/100 Rods across C. O. Fannings Land

120 25/100 Rods across Mrs Mary Klines Land

94 32/100 Rods across J. H. Raleys Land

56 36/100 Rods between Welch and Walker

I hereby certify that the above is a correct Plat of Road No. 506 as Surveyed by me on the 22nd day of March 1899

John W. Kimsrell Surveyor
In Umatilla County Oregon