


439

ad no. 439

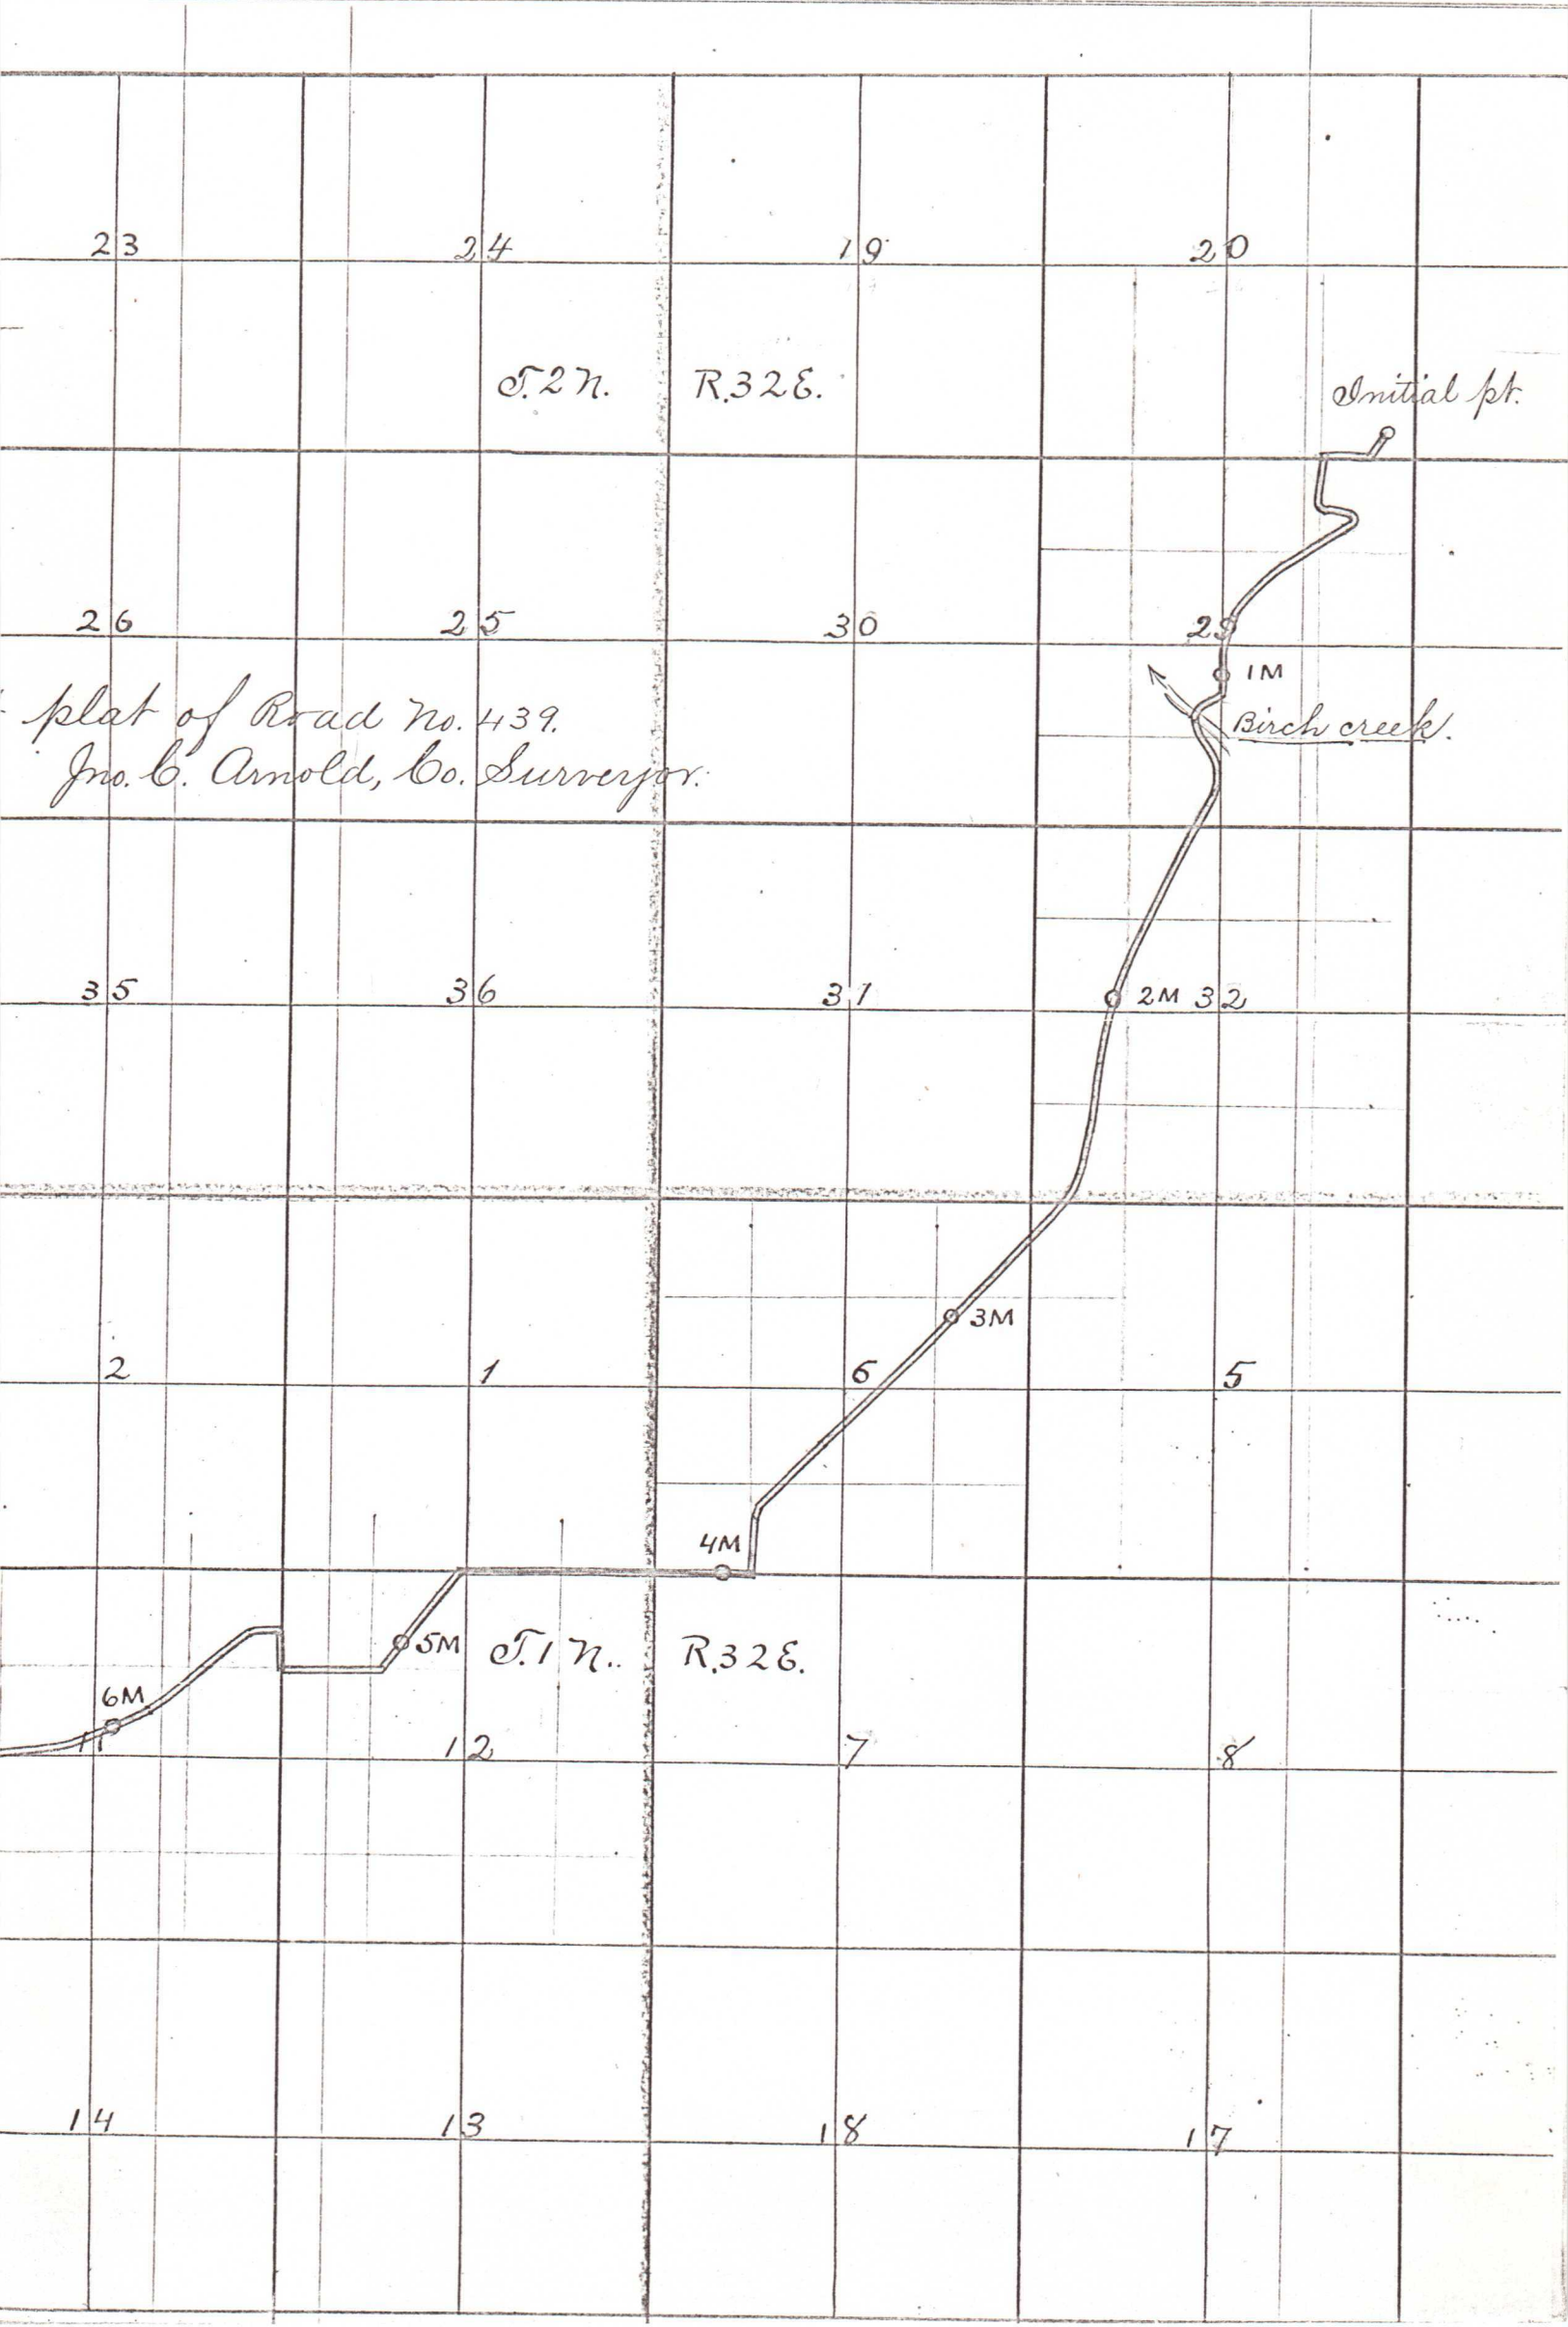


Initial pt.

plat of Road No. 439.
Jno. C. Arnold, Co. Surveyor.

Birch creek.


Plat of County R

19

20

21

22

T. 27. R. 31 E.

30

29

28

27

I hereby certify the following to be a correct

31

32

33

34

6

5

4

3

T. 17. R. 31 E.

7

8

9

10

Terminus

10M

9M

8M

7M

18

17.

16

15