

- Walker Rd 1231
- Westland Rd 1215WE
- 1st Pl (N) 1275-1
- 1st St (S) 1245-1
- 2nd St (NE) 1227
- 4th St (SE) 1193
- 9th St (SE) 1197
- 10th St (NE & SE) 1219
- 10th St (SW) 1297
- 11th St (NW) 1247
- 17th St (SW) 1189
- 23rd St (SW) 1238-23

R27

ROAD 171
WIDTH = 60'

ROAD 653
WIDTH = 40'


ROAD 171
WIDTH = 60'

OSHD TO COUNTY
WIDTH = 60'

OSHD TO COUNTY
WIDTH VARIES

ROAD 322
WIDTH = 60'

See detail Map of City of Hermiston (Page 58 & 59)

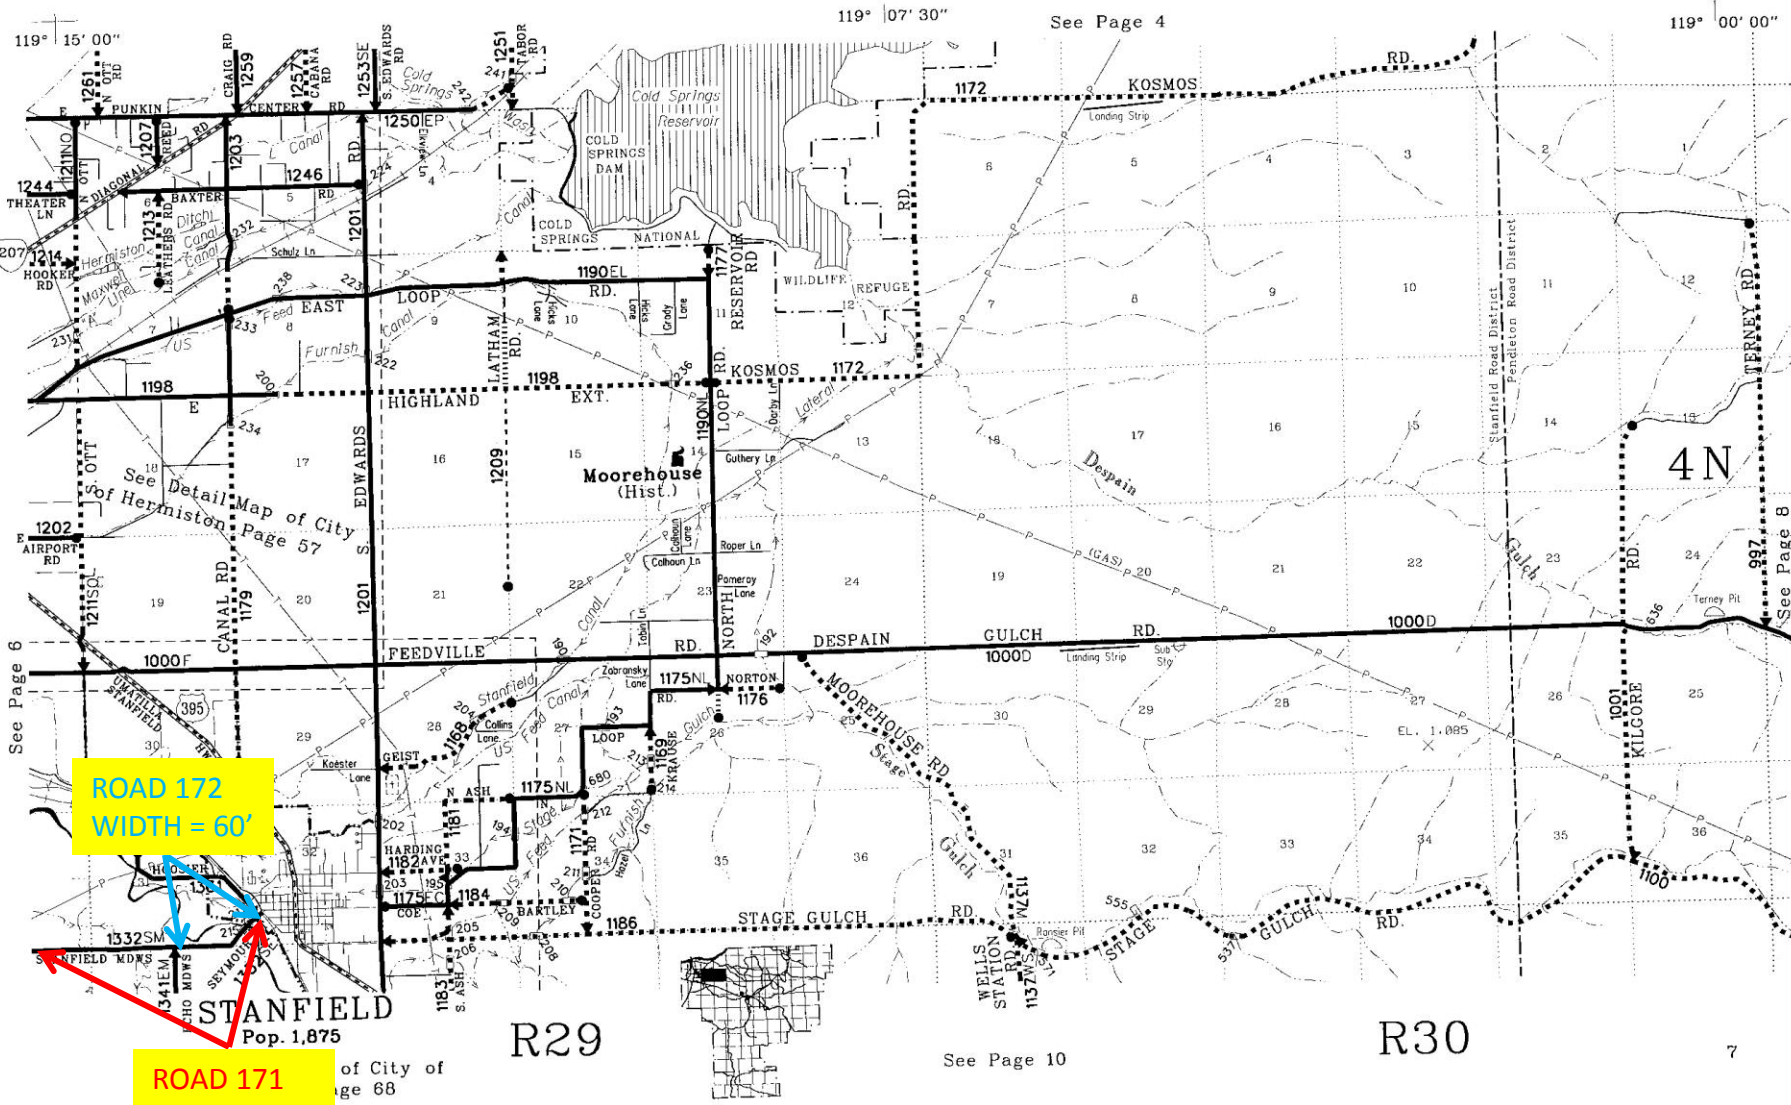

119° 15' 00"

119° 07' 30"

See Page 4

119° 00' 00"

See Page 6

See Page 8

ROAD 172
WIDTH = 60'

ROAD 171
WIDTH = 60'

See Detail Map of City of Hermiston Page 57

STANFIELD
Pop. 1,875

of City of
ge 68

R29

See Page 10

R30