


in Township 3 North Range 28 East W. Mt.
and Township 2 North Ranges 27-28 and 29 East W. Mt.

True N
Scale 25 ch: 1"

T. 3. N. R. 28. E.
T. 2. N. R. 28. E.

T. 3. N. R. 29. E.
T. 2. N. R. 29. E.

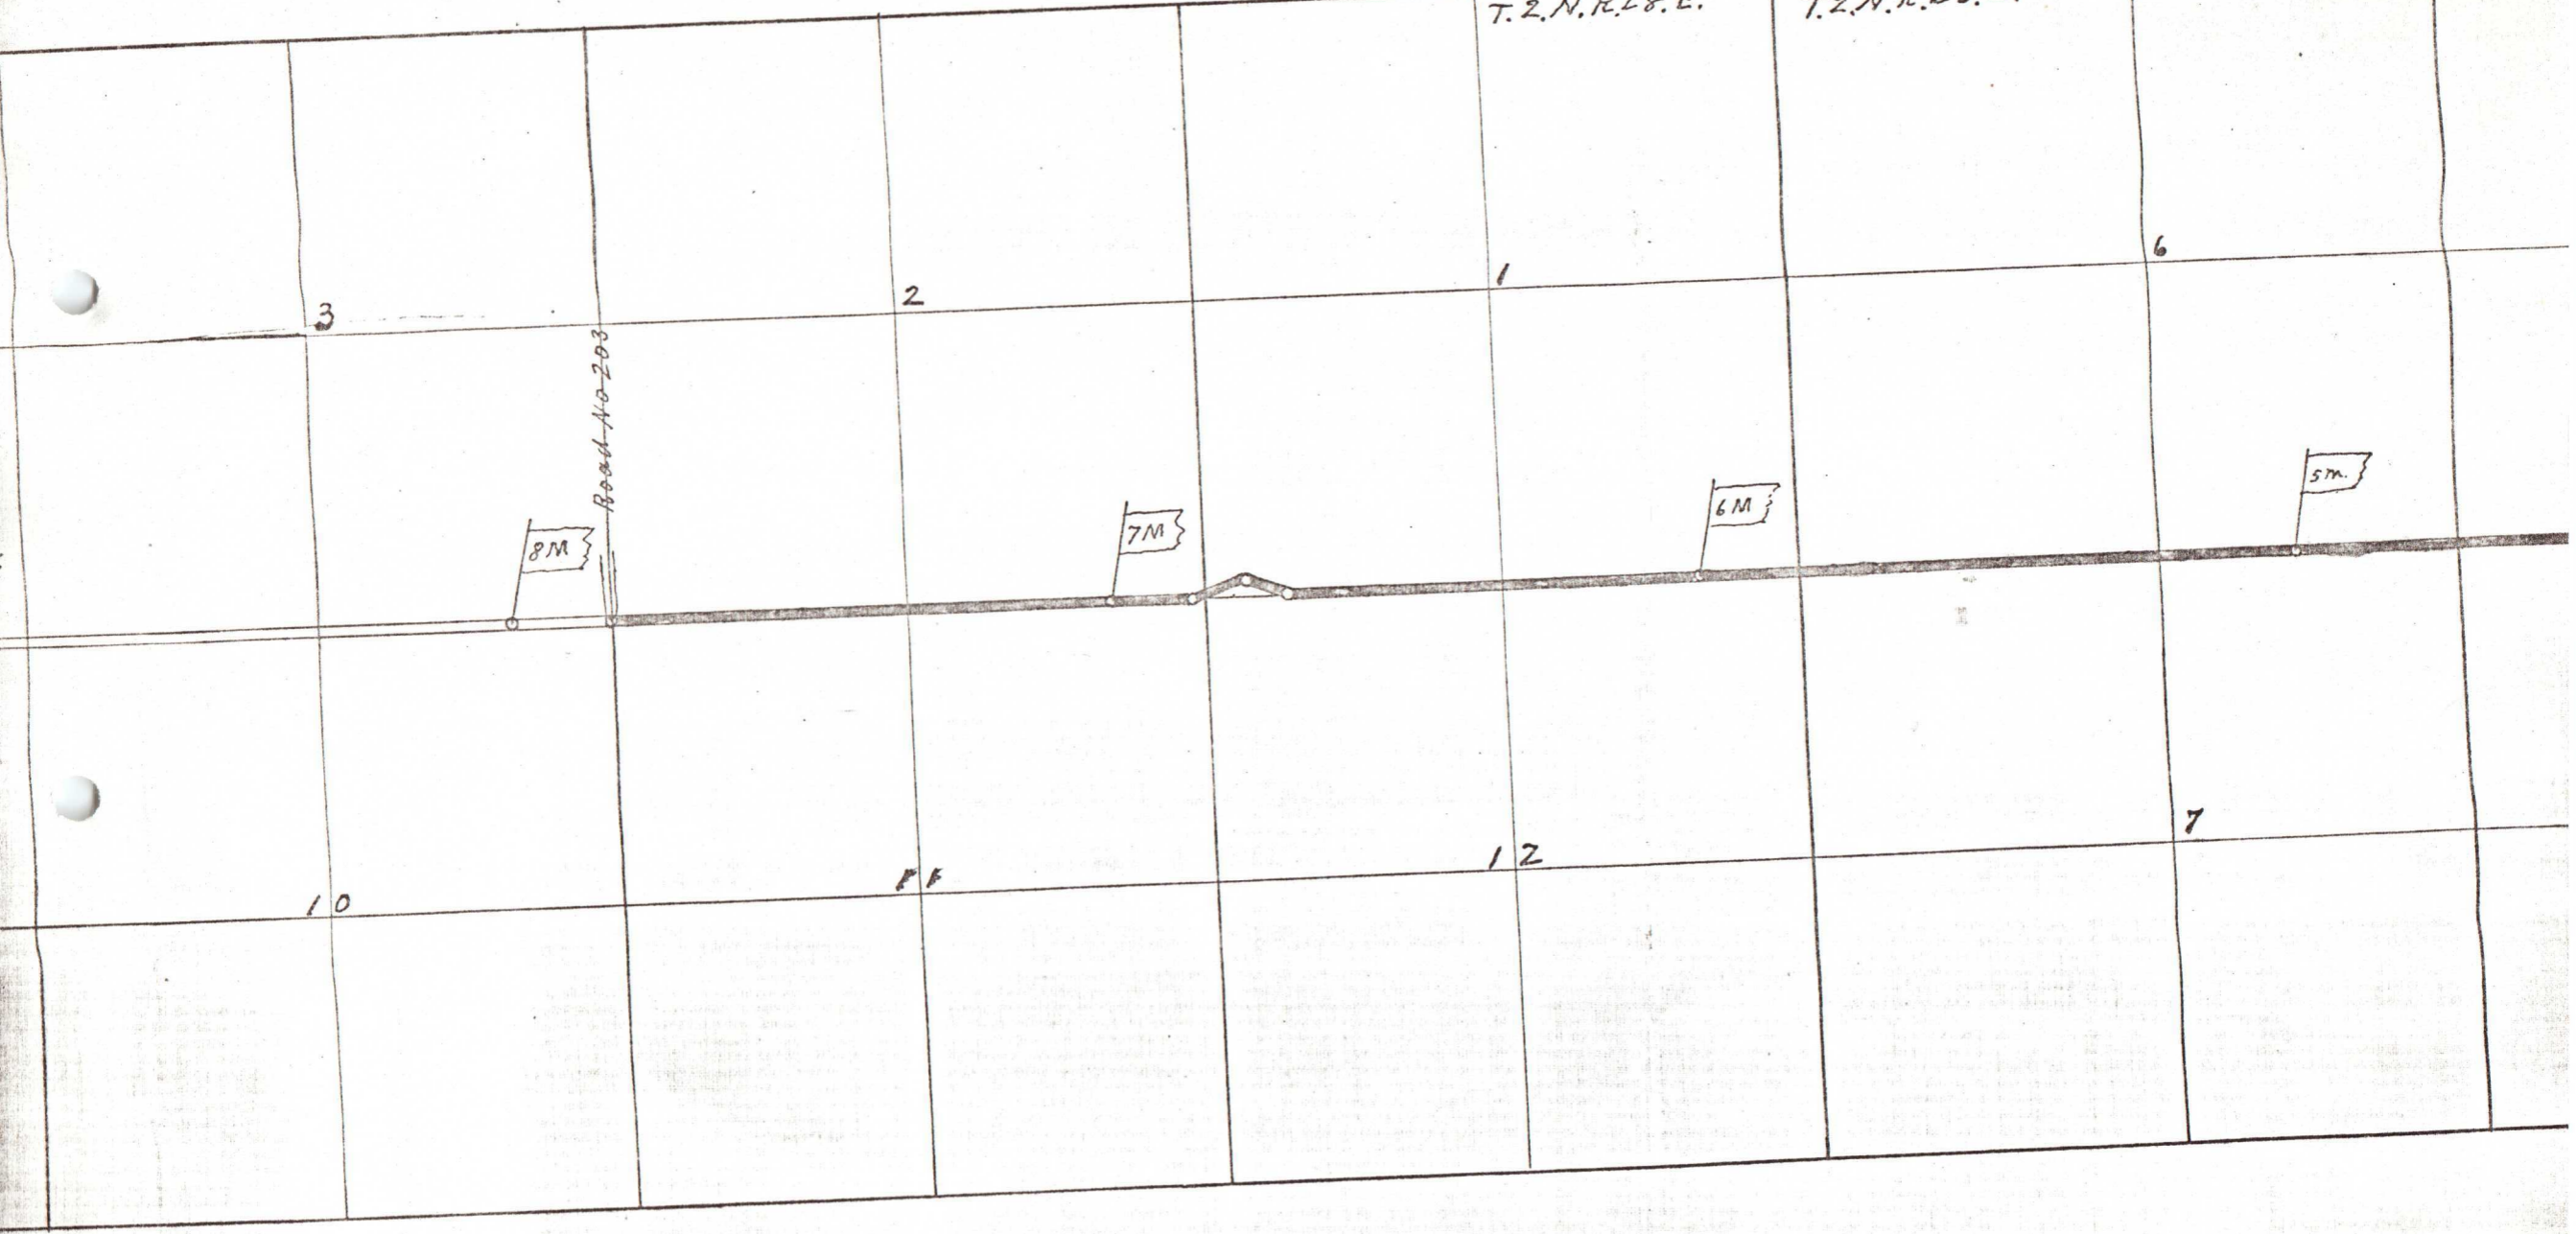

T. 2. N. R. 27. E.

1

6

5

4

RT
V. 665

12M

11M

10M

9M

road No. 203

road No. 203

12

7

8

9

ch: 1"

T.3.N.R.28.E.
T.2.N.R.28.E.

Found
Fence
Marked
T.3.N.R.29.E.
T.2.N.R.29.E.

6M

set 1/2" I.P.
set stone

5M

Found Old Post

4M

1/2" I.P.
set stone

3M

1/2" I.P.
set stone

set 1/2" I.P.
set stone

2M

1/2" I.P.
set stone

Fence Co
set 1/2" I.P.
set stone

29

Found Stone
set 1/2" I.P.

20

1M


19


30

31

6

5

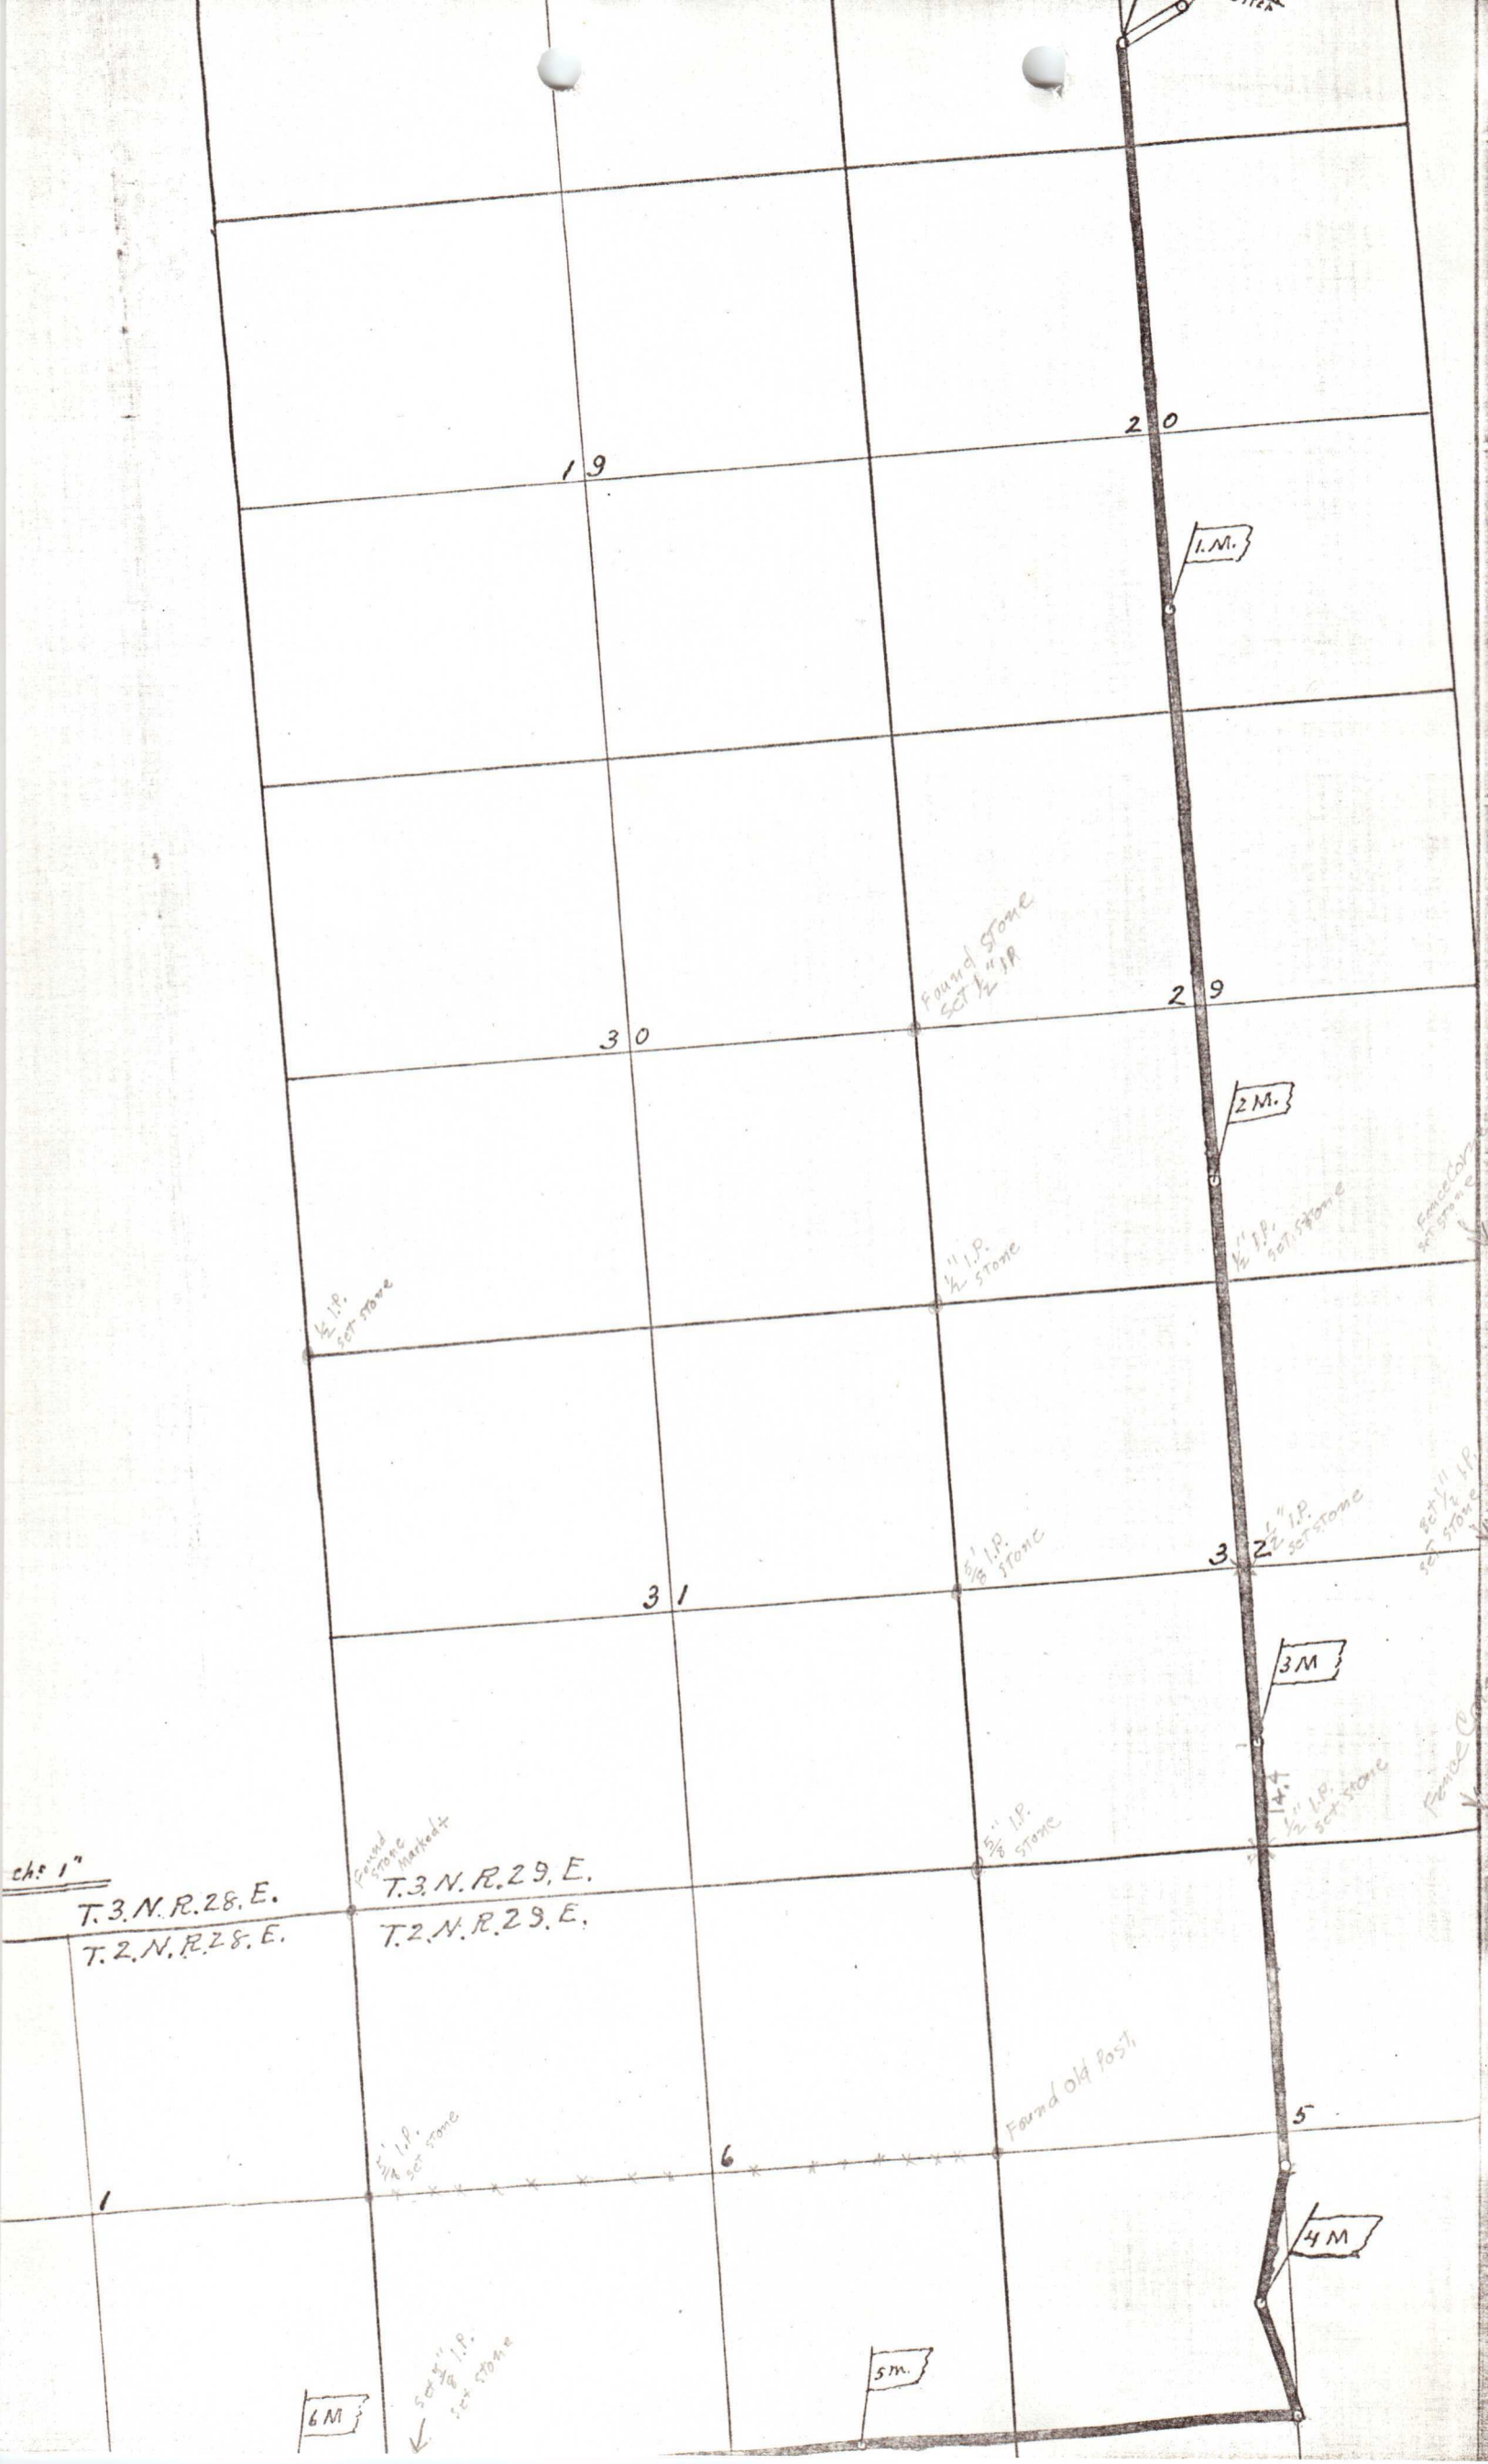

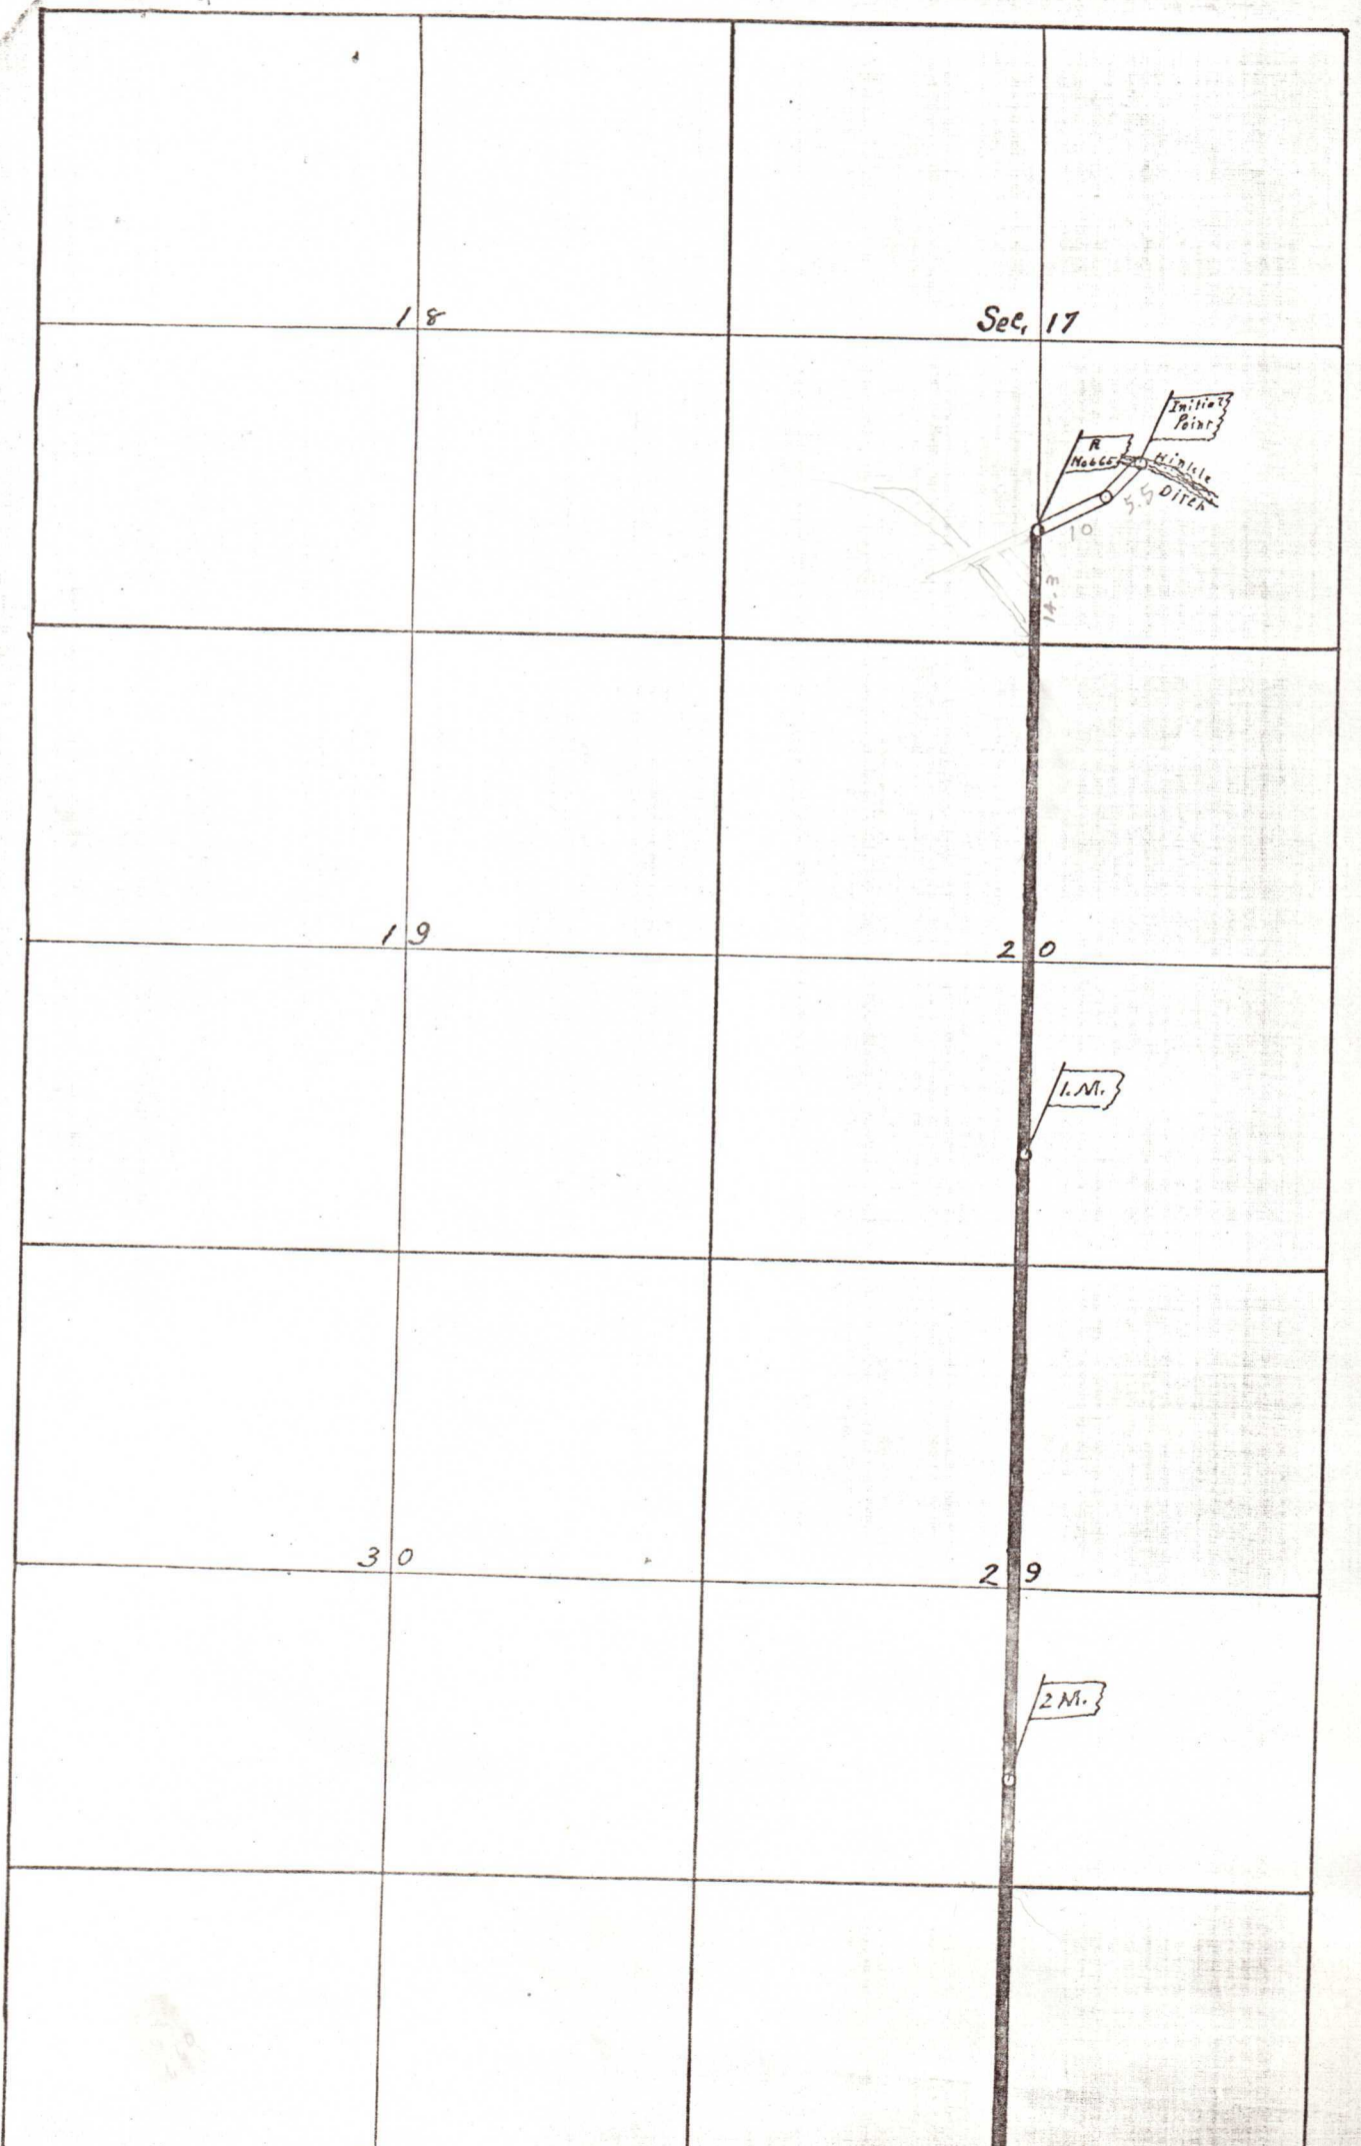

18

Sec. 17

Initial Point
R. No. 6
10
1 N. 3
1. N.
2 N.

19

20

1. N.

30

29

2 N.