


See Page 9

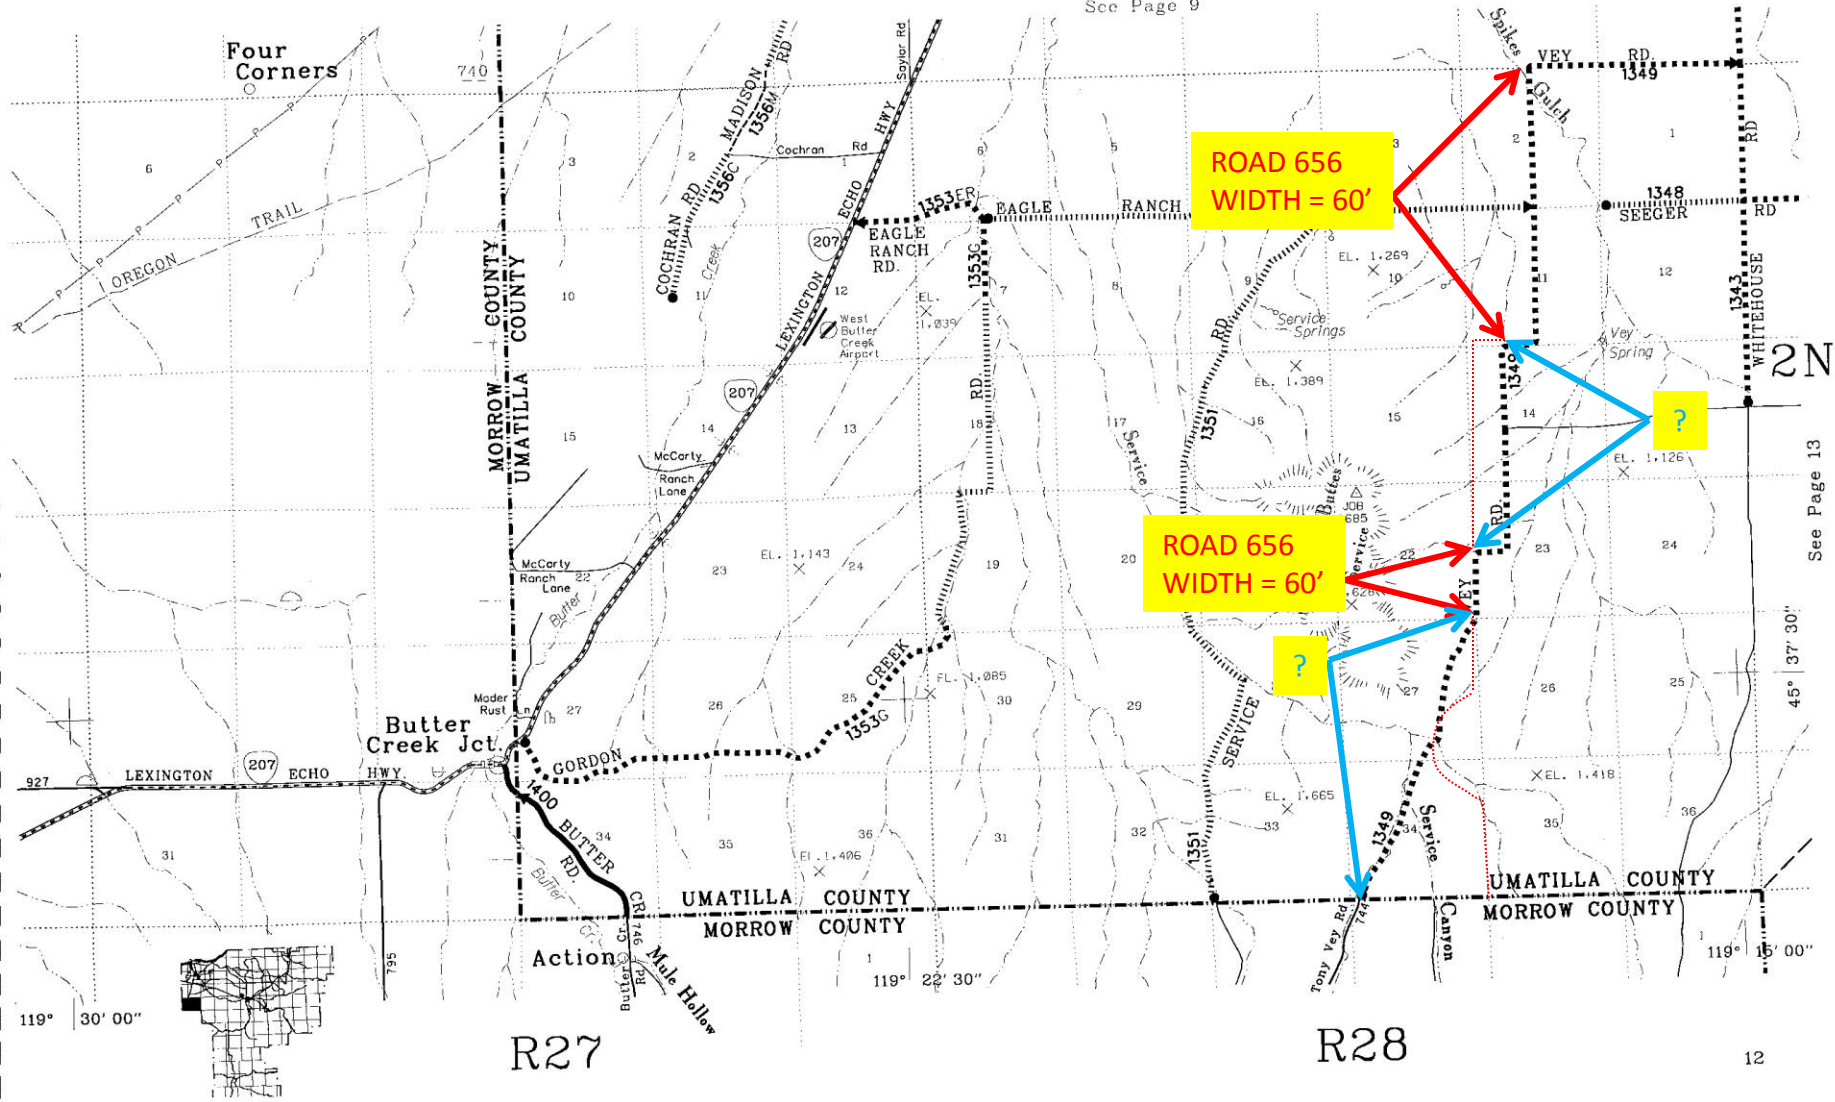

2N

See Page 13

45° 37' 30"

119° 15' 00"

12



R27

R28