

ROAD 27-A
WIDTH = 60'

ROAD 842.5
WIDTH = 60'

ROAD 499
WIDTH = 60'


EAST BIRCH CREEK SECTION
WIDTH VARIES

See Page 40

See Page 41

R31

R32

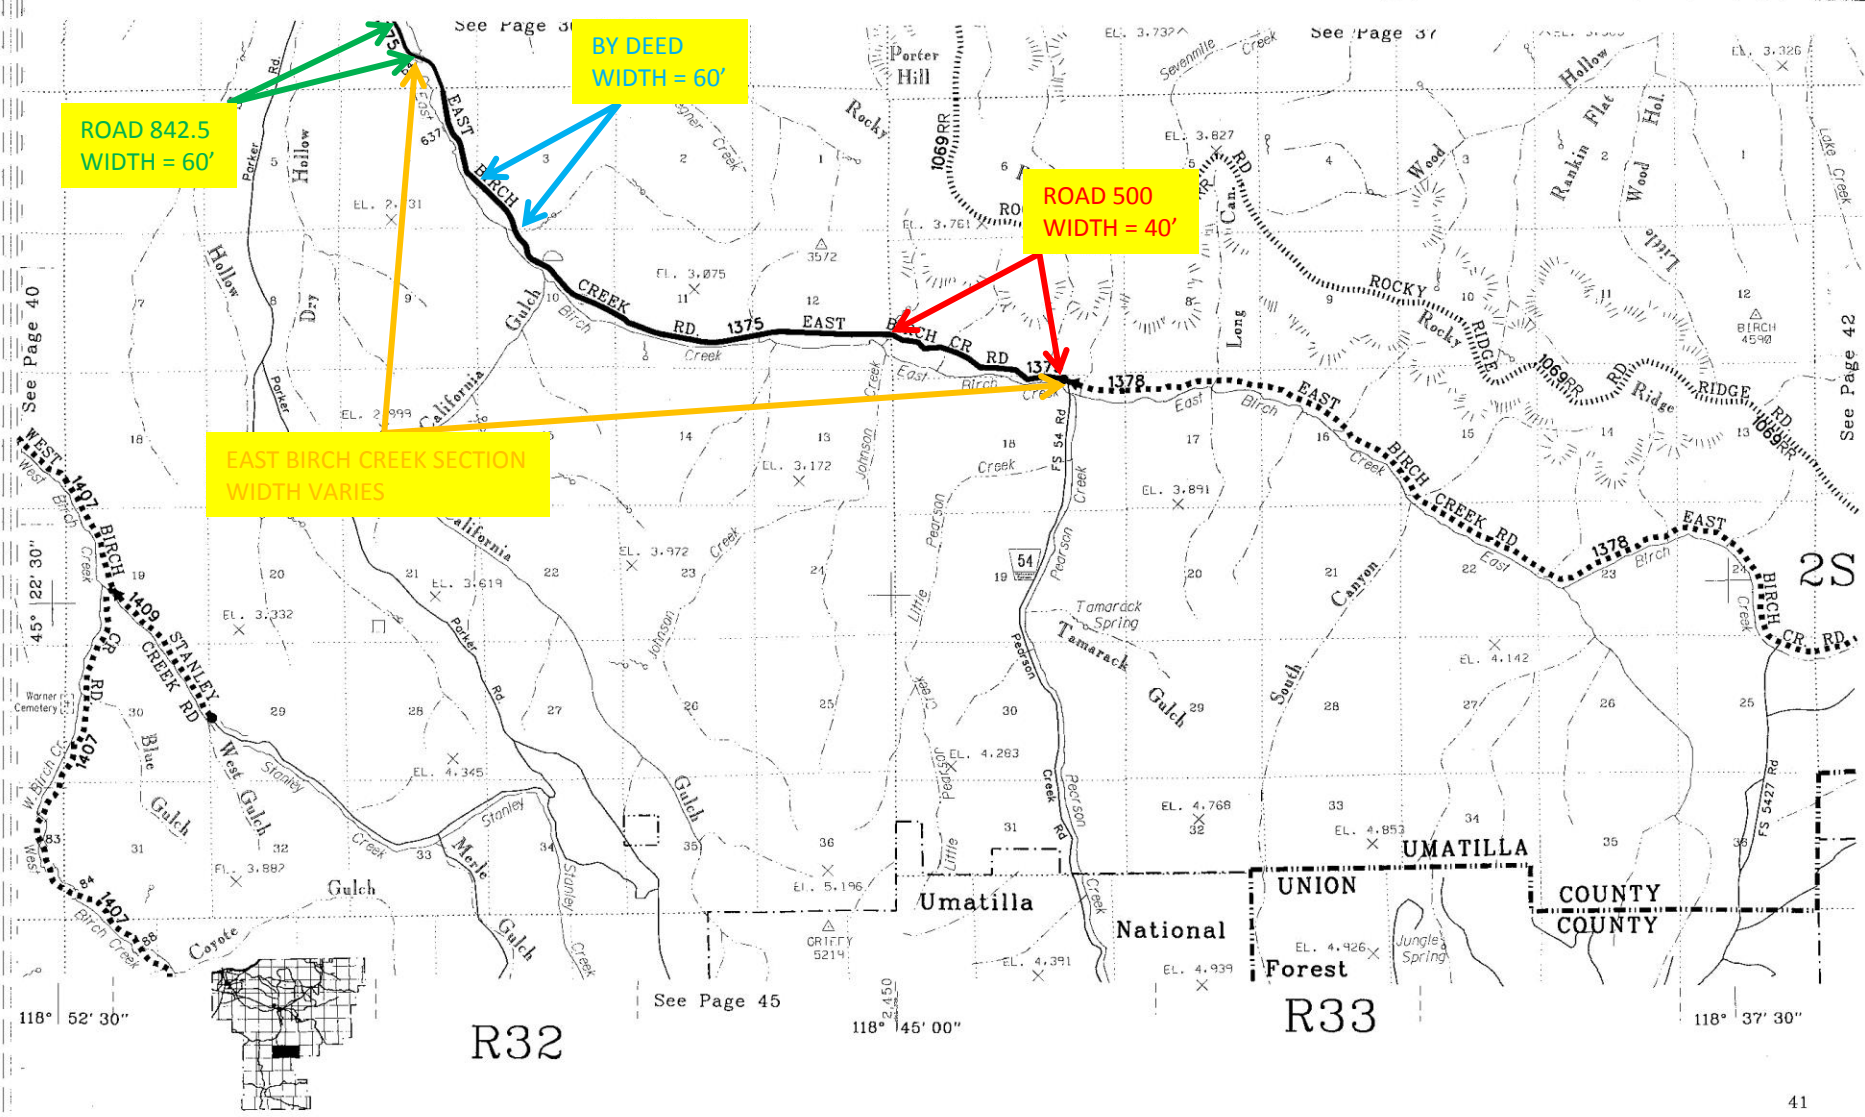

See Page 40

See Page 31

See Page 37

See Page 42

118° 52' 30"

R32

See Page 45

118° 45' 00"

R33

118° 37' 30"