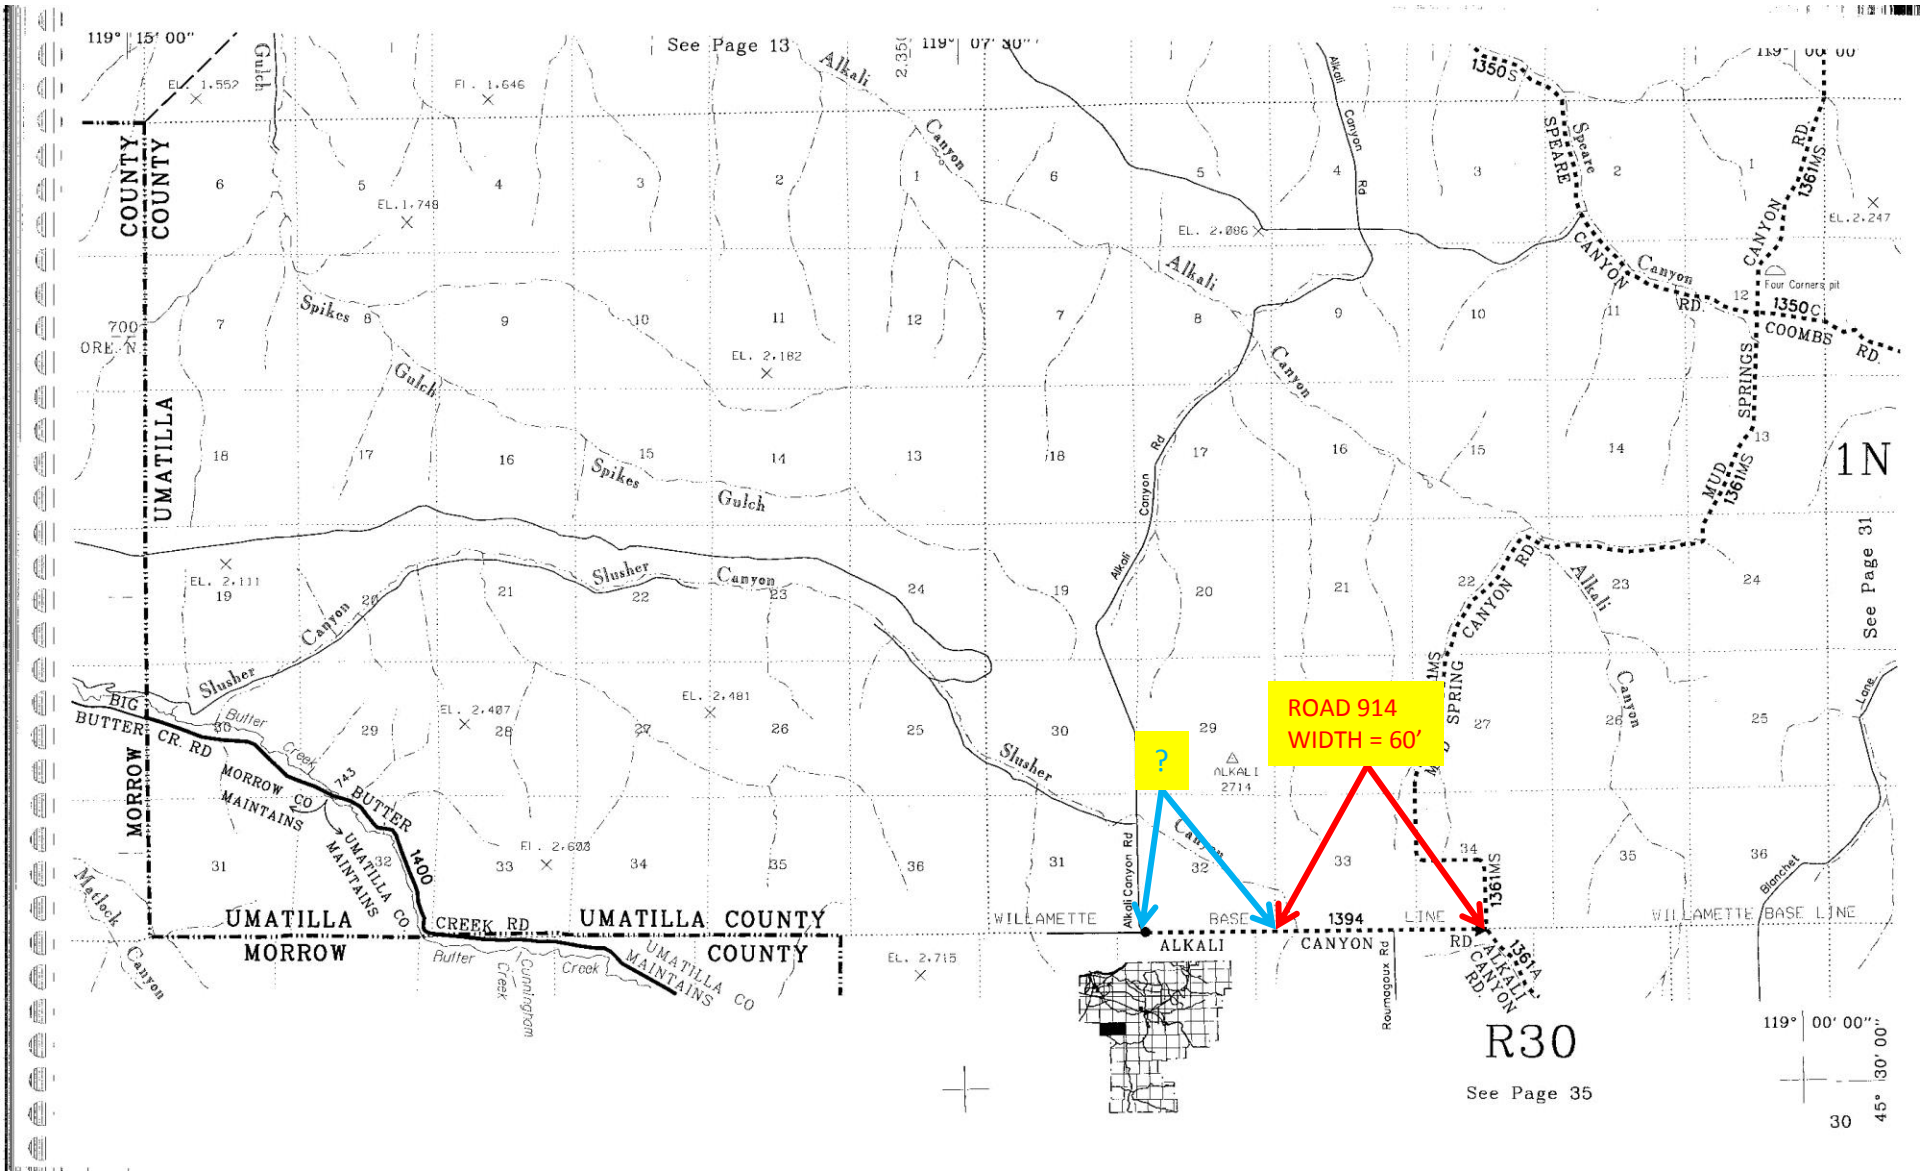
ROAD 914
WIDTH = 60'
?
See Page 13
See Page 31
See Page 35
1N
R30
UMATILLA COUNTY
MORROW COUNTY
ALKALI CANYON RD.
WILLAMETTE BASE LINE
BIG BUTTER CR. RD
Alkali Canyon
Slusher Canyon
Spikes Gulch
Butter Creek
Cunningham Creek
Matlock Canyon
Blanchet Lone
Four Corners pit
ALKALI 2714
MORROW CO MAINTAINS
UMATILLA CO MAINTAINS
1350S
1350C
1361MS
1400
1394
1361A