


96

T. 3. S. R. 31. E. W. M.

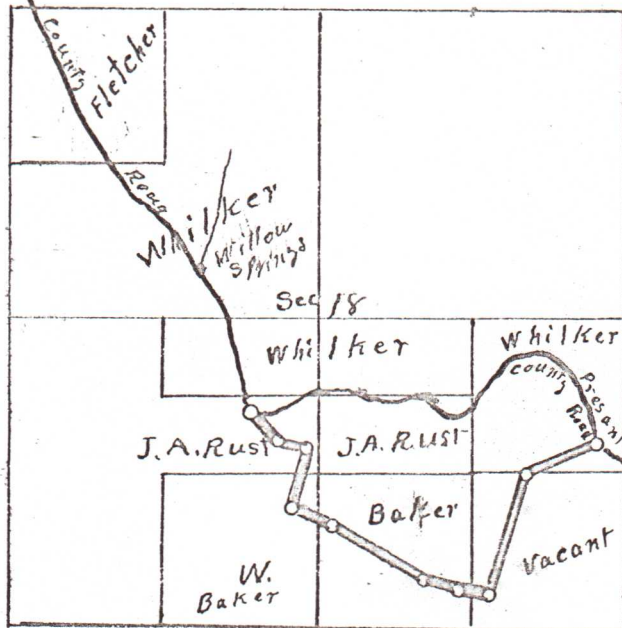

N

Scale 25. chs 1"