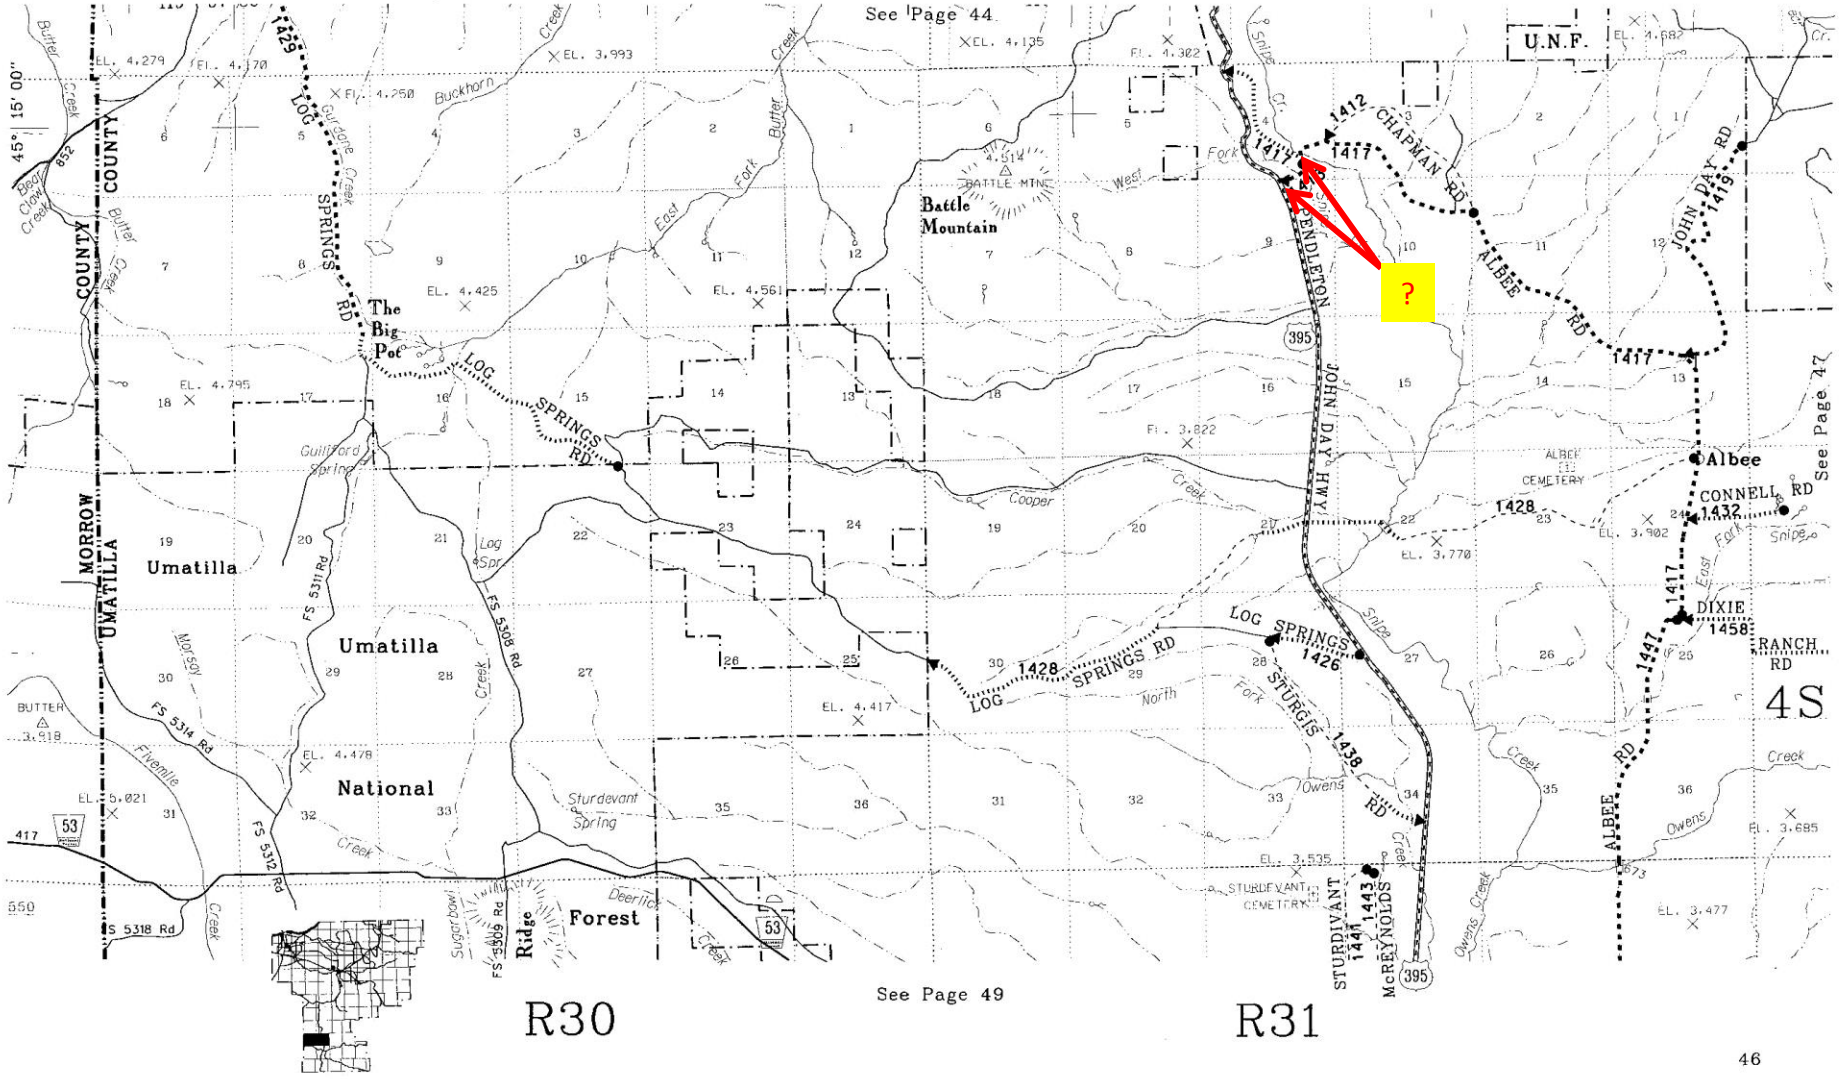
See Page 44
U.N.F.
45° 15' 00"
MORROW COUNTY
UMATILLA COUNTY
LOG SPRINGS RD
The Big Pot
Battle Mountain
BATTLE MTN
PENDLETON
JOHN DAY HWY
CHAPMAN RD
ALBEE RD
JOHN DAY RD
Albee
CONNELL RD
DIXIE
RANCH RD
ALBEE CEMETERY
STURGIS RD
STURDIVANT
McREYNOLDS
STURDEVANT CEMETERY
Umatilla
Umatilla National Forest
Ridge
Guilford Spring
Sturdevant Spring
Log Spr
Cooper Creek
Snipe Creek
Owens Creek
Buckhorn Creek
Butter Creek
Gurdane Creek
Bear Creek
Morsay Creek
Fivemile Creek
Sugarbowl Creek
Deerlick Creek
North Fork
West Fork
East Fork
FS 5311 Rd
FS 5308 Rd
FS 5314 Rd
FS 5312 Rd
FS 5318 Rd
FS 5309 Rd
BUTTER
?
4S
See Page 47
See Page 49
R30
R31