


520 E

Road Plat 520

40' R/W

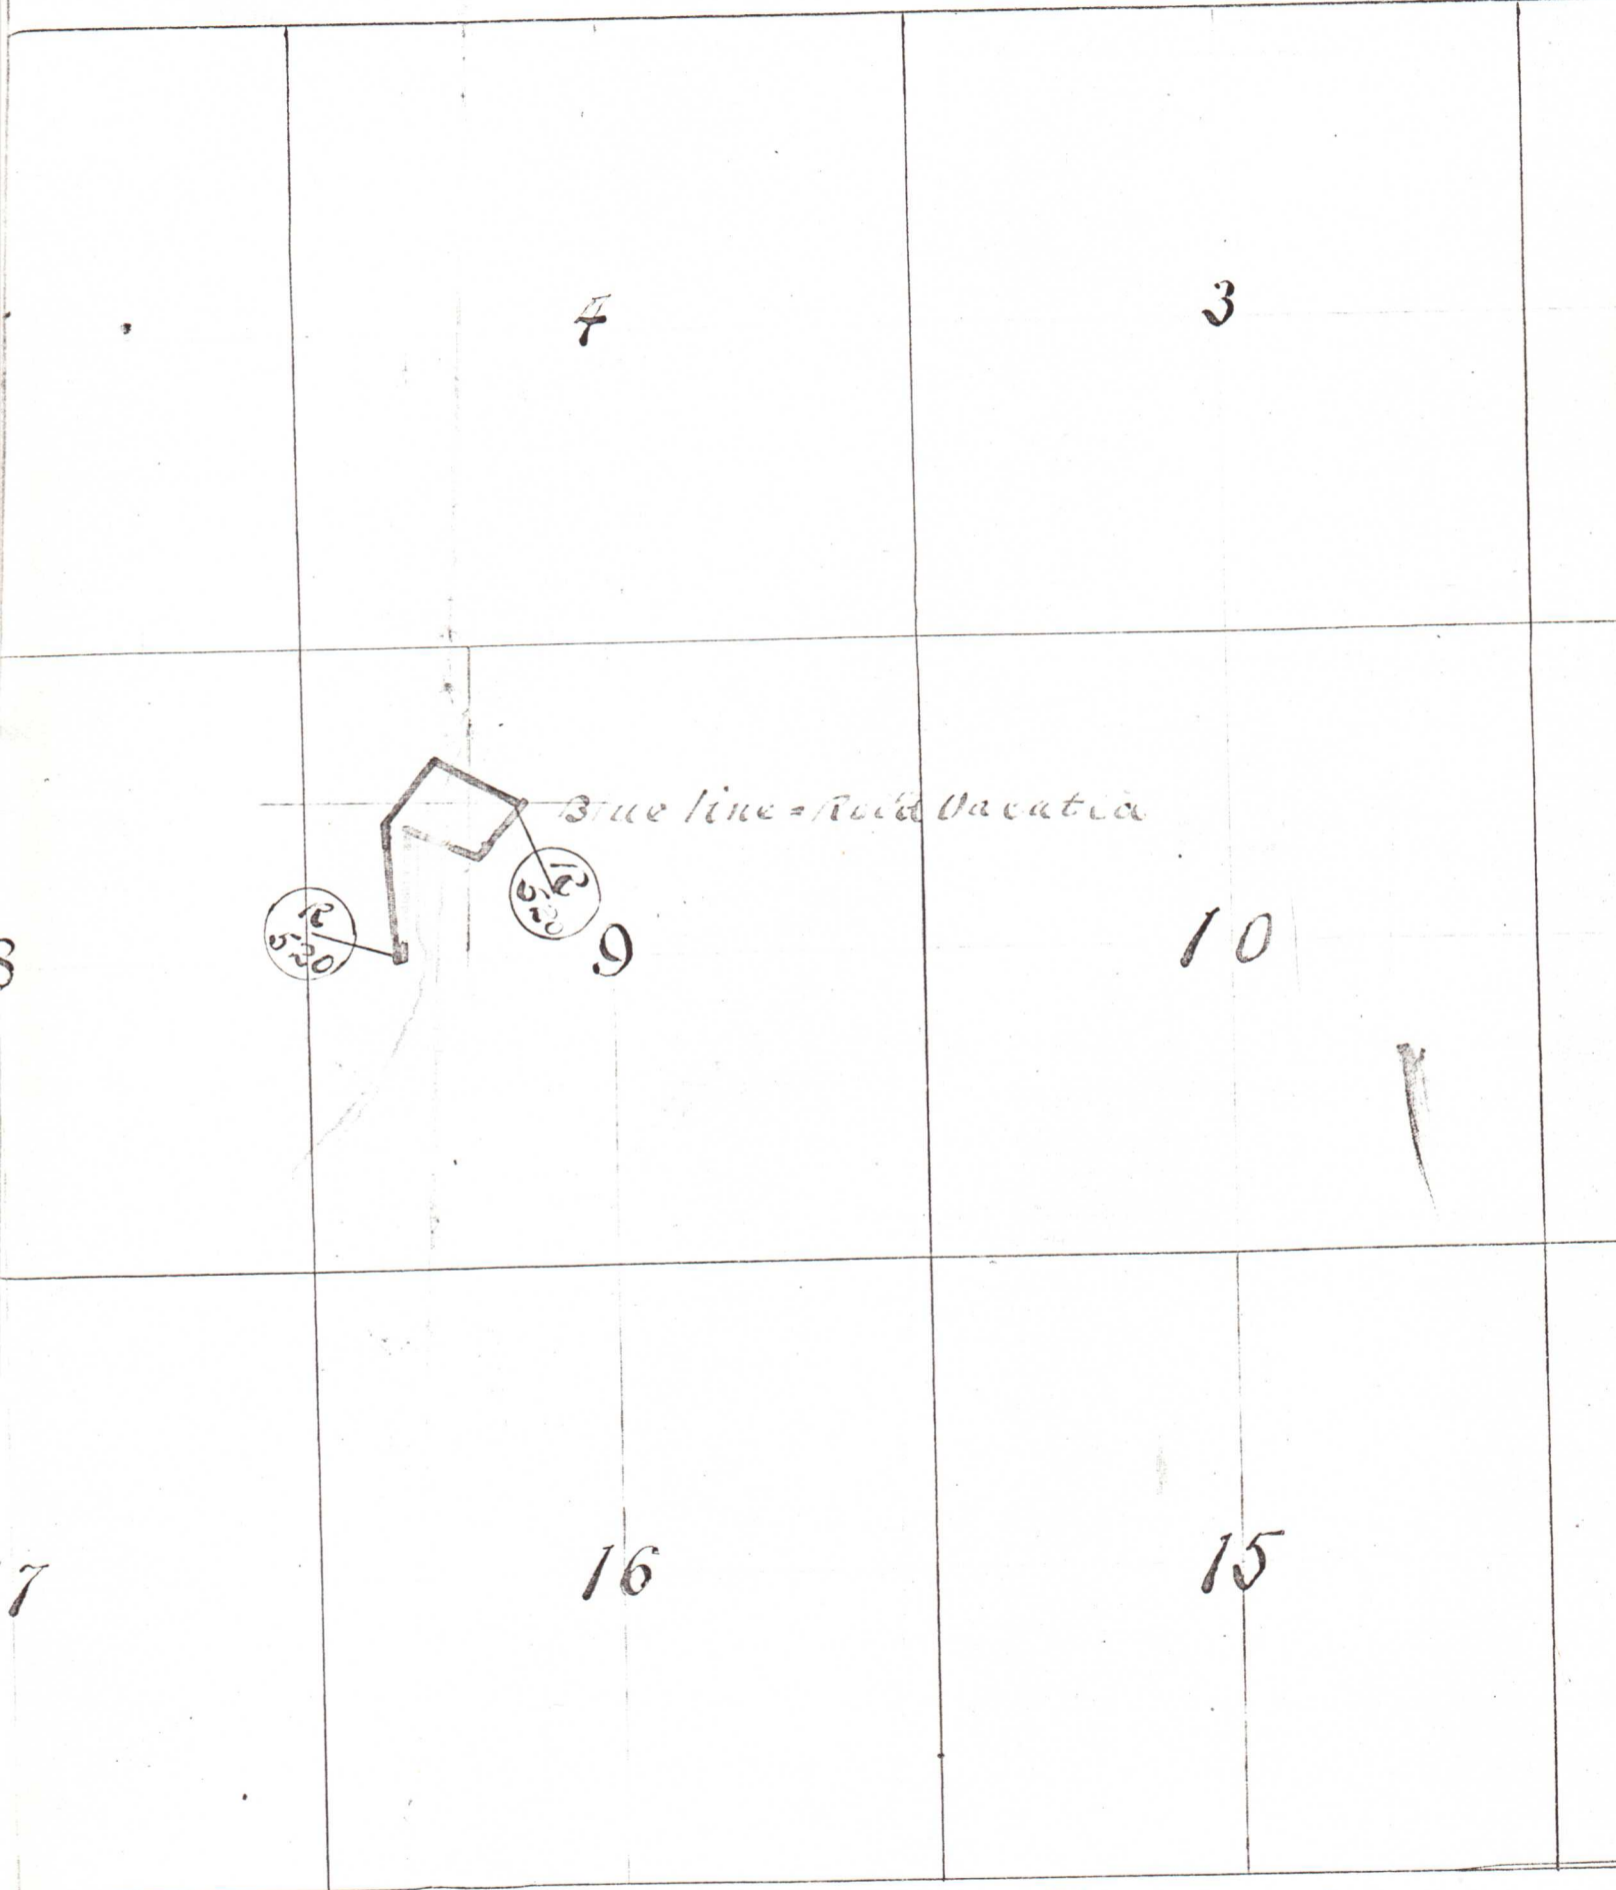

Township 2 South

Range 30 East.