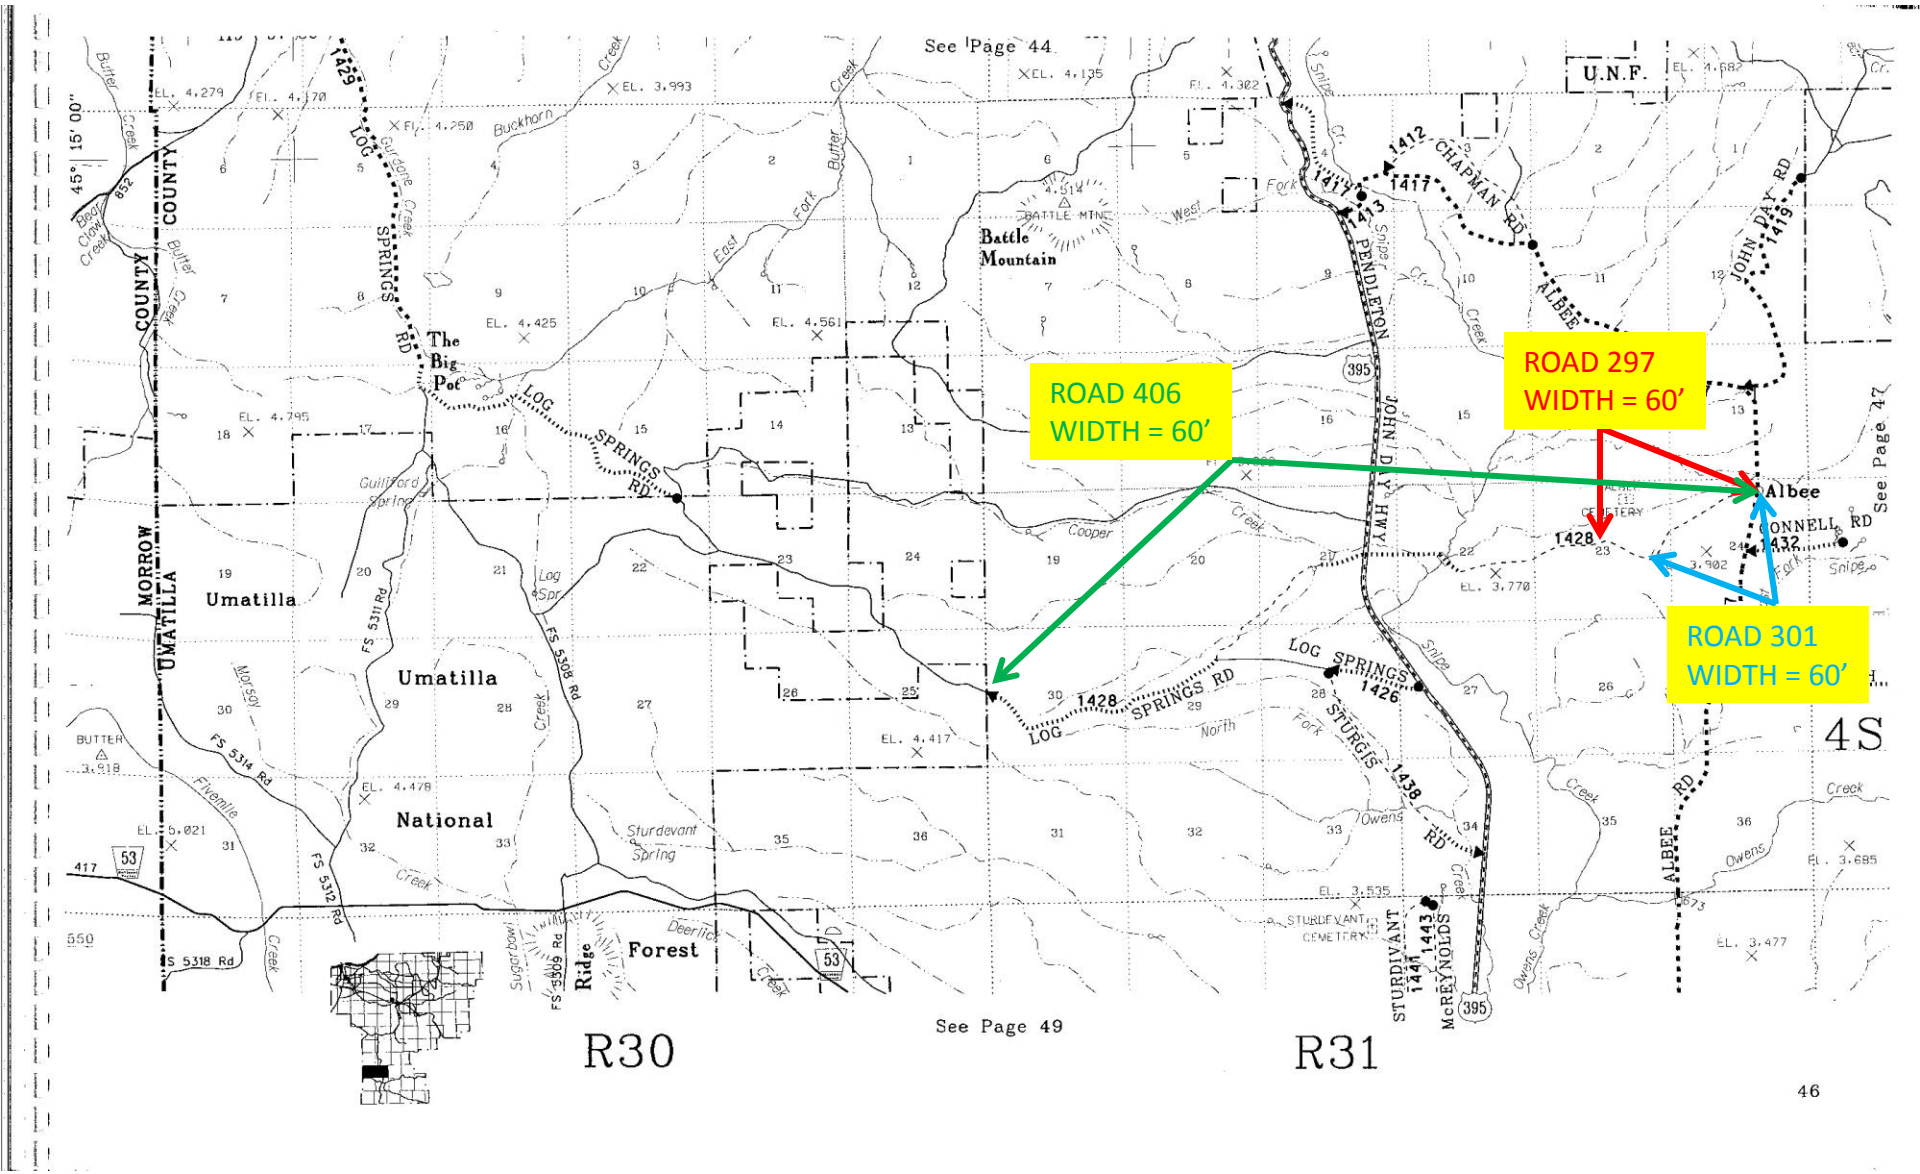
ROAD 406
WIDTH = 60’
ROAD 297
WIDTH = 60’
ROAD 301
WIDTH = 60’
See Page 44
See Page 47
See Page 49
R30
R31
4S
Umatilla
National
Forest
Battle Mountain
The Big Pot
Albee
U.N.F.
LOG SPRINGS RD
PENDLETON
CHAPMAN RD
ALBEE
JOHN DAY HWY
SPRINGS RD
STURGIS
STURDEVANT CEMETERY
McREYNOLDS
MORROW
UMATILLA
COUNTY
Guilford Spring
Sturdevant Spring
Deerlick Ridge
Sugarbowl
Owens Creek
Cooper Creek
Snipe Creek
Buckhorn Creek
Butler Creek
Log Spr
Log Springs Creek
Gurdane Creek
Fivemile Creek
Morgan Creek
Owens Creek
Creek
Fork
North Fork
West Fork
East Fork
FS 5311 Rd
FS 5308 Rd
FS 5314 Rd
FS 5312 Rd
FS 5318 Rd
FS 5309 Rd
1428
1426
1438
1443
1441
1412
1417
1419
1432
395
53
417
550
852
EL. 4,279
EL. 4,170
EL. 4,260
EL. 3,993
EL. 4,135
EL. 4,302
EL. 4,425
EL. 4,561
EL. 4,795
EL. 4,417
EL. 4,478
EL. 5,021
EL. 3,770
EL. 3,902
EL. 3,535
EL. 3,685
EL. 3,477
BATTLE MTN. 4,514
BUTTER 3,918
45° 15' 00"
46