


512


Plat of

Township 5 South Range 31 East

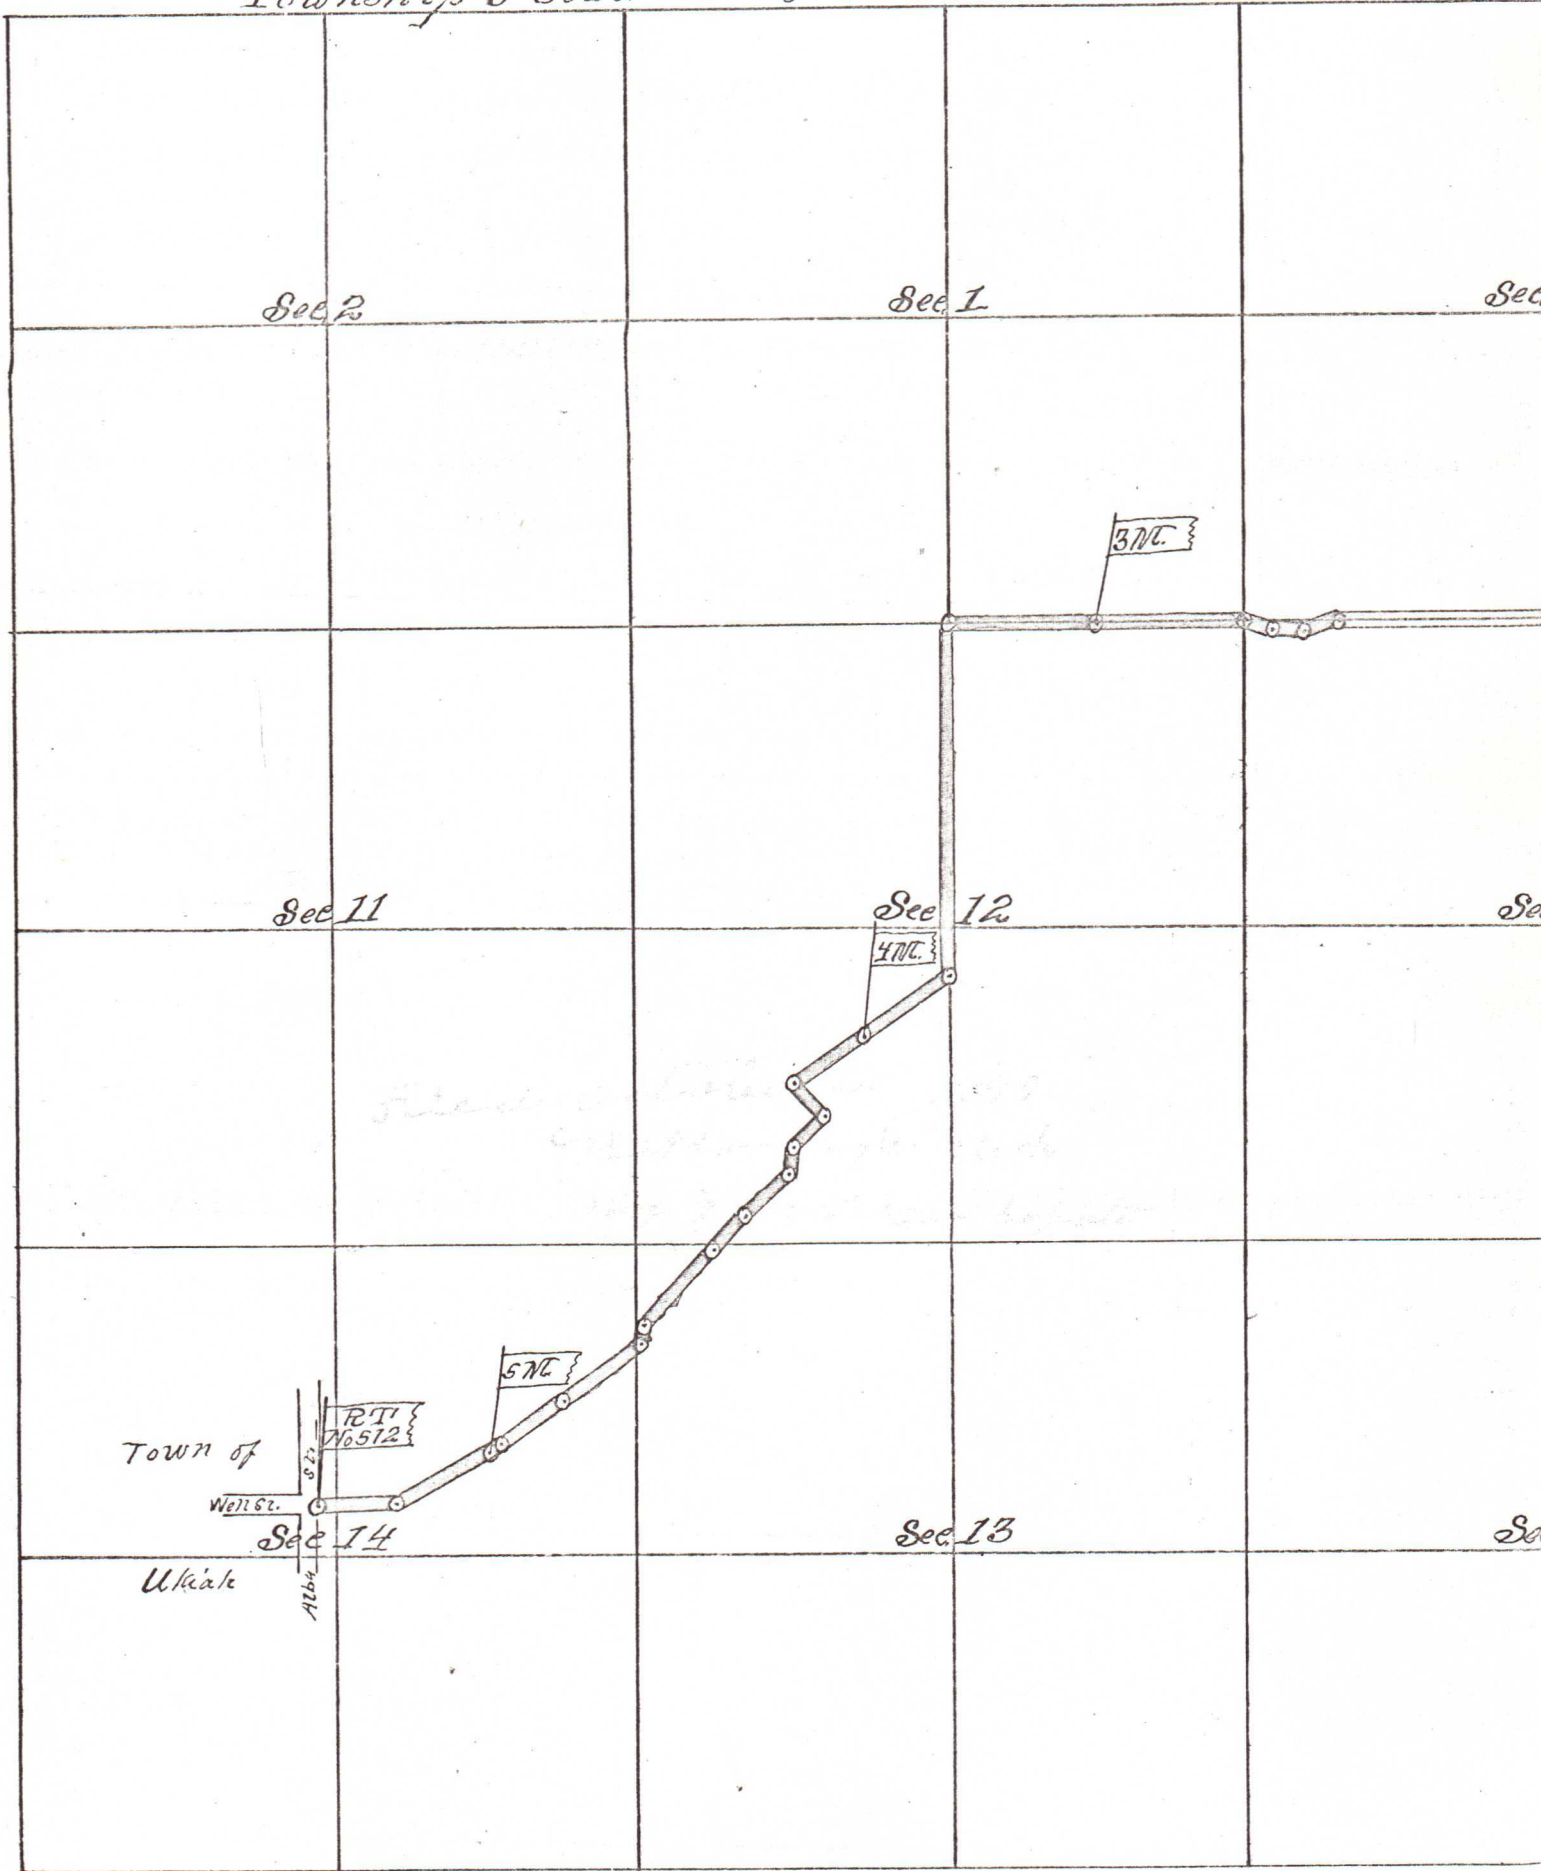

Road No. 512

Township 5 South Range 32 East

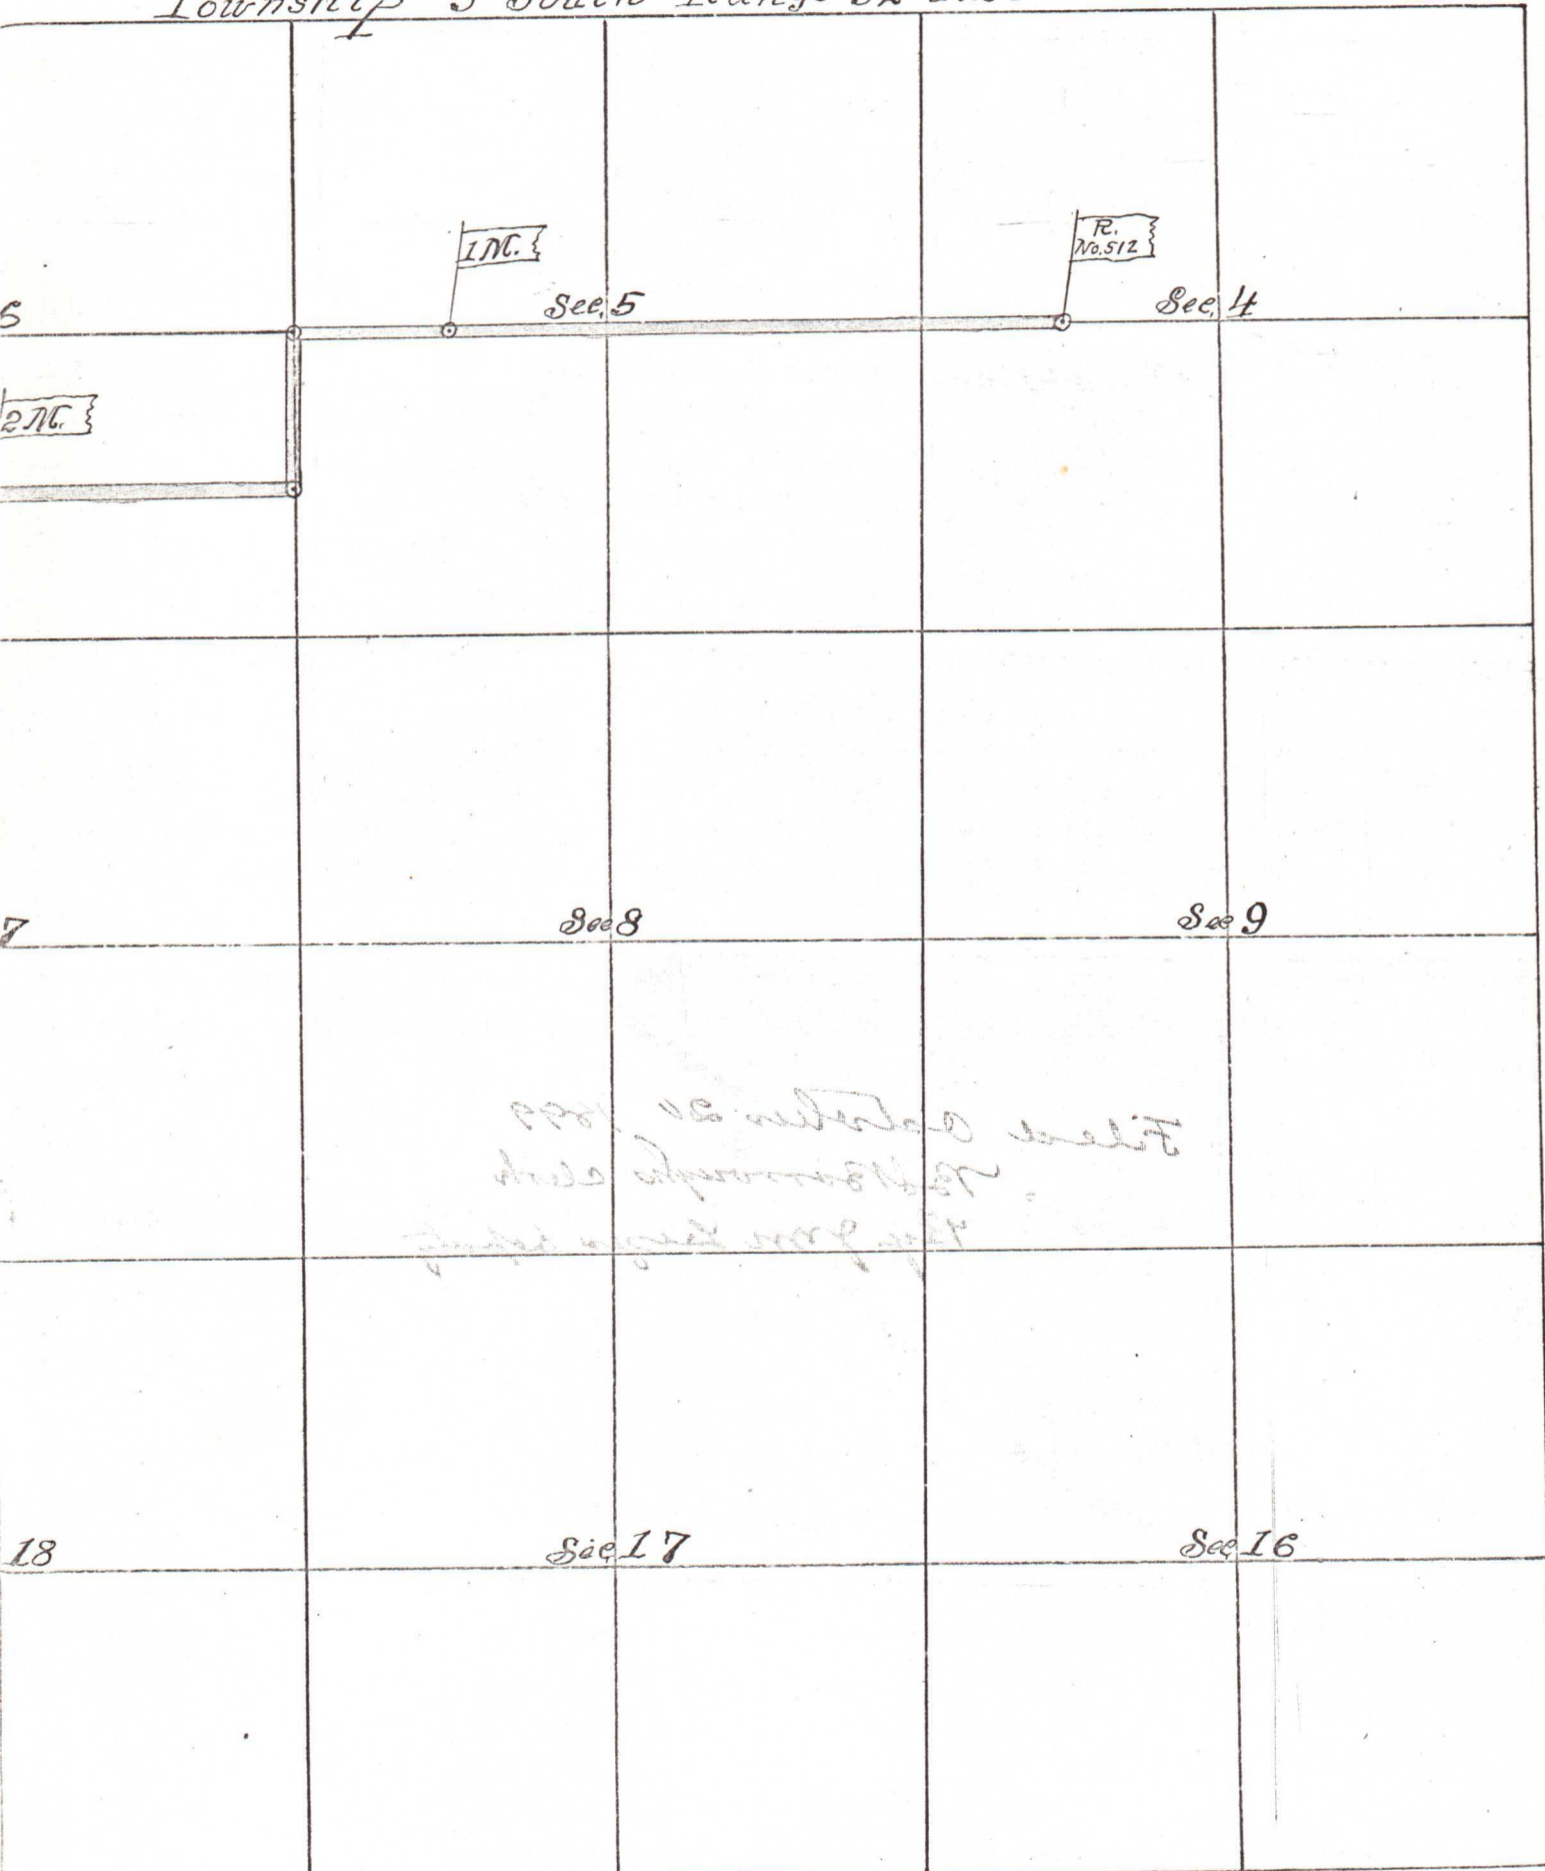

I hereby certify that the above is a correct Plat of Road No. 512
as surveyed by me on the 10th day of October 1899
John W. Simons County Surveyor

The Meridian
1899