


See Page 46

See Detail Map of Ukiah Page 7

R30

See Page 52

R31

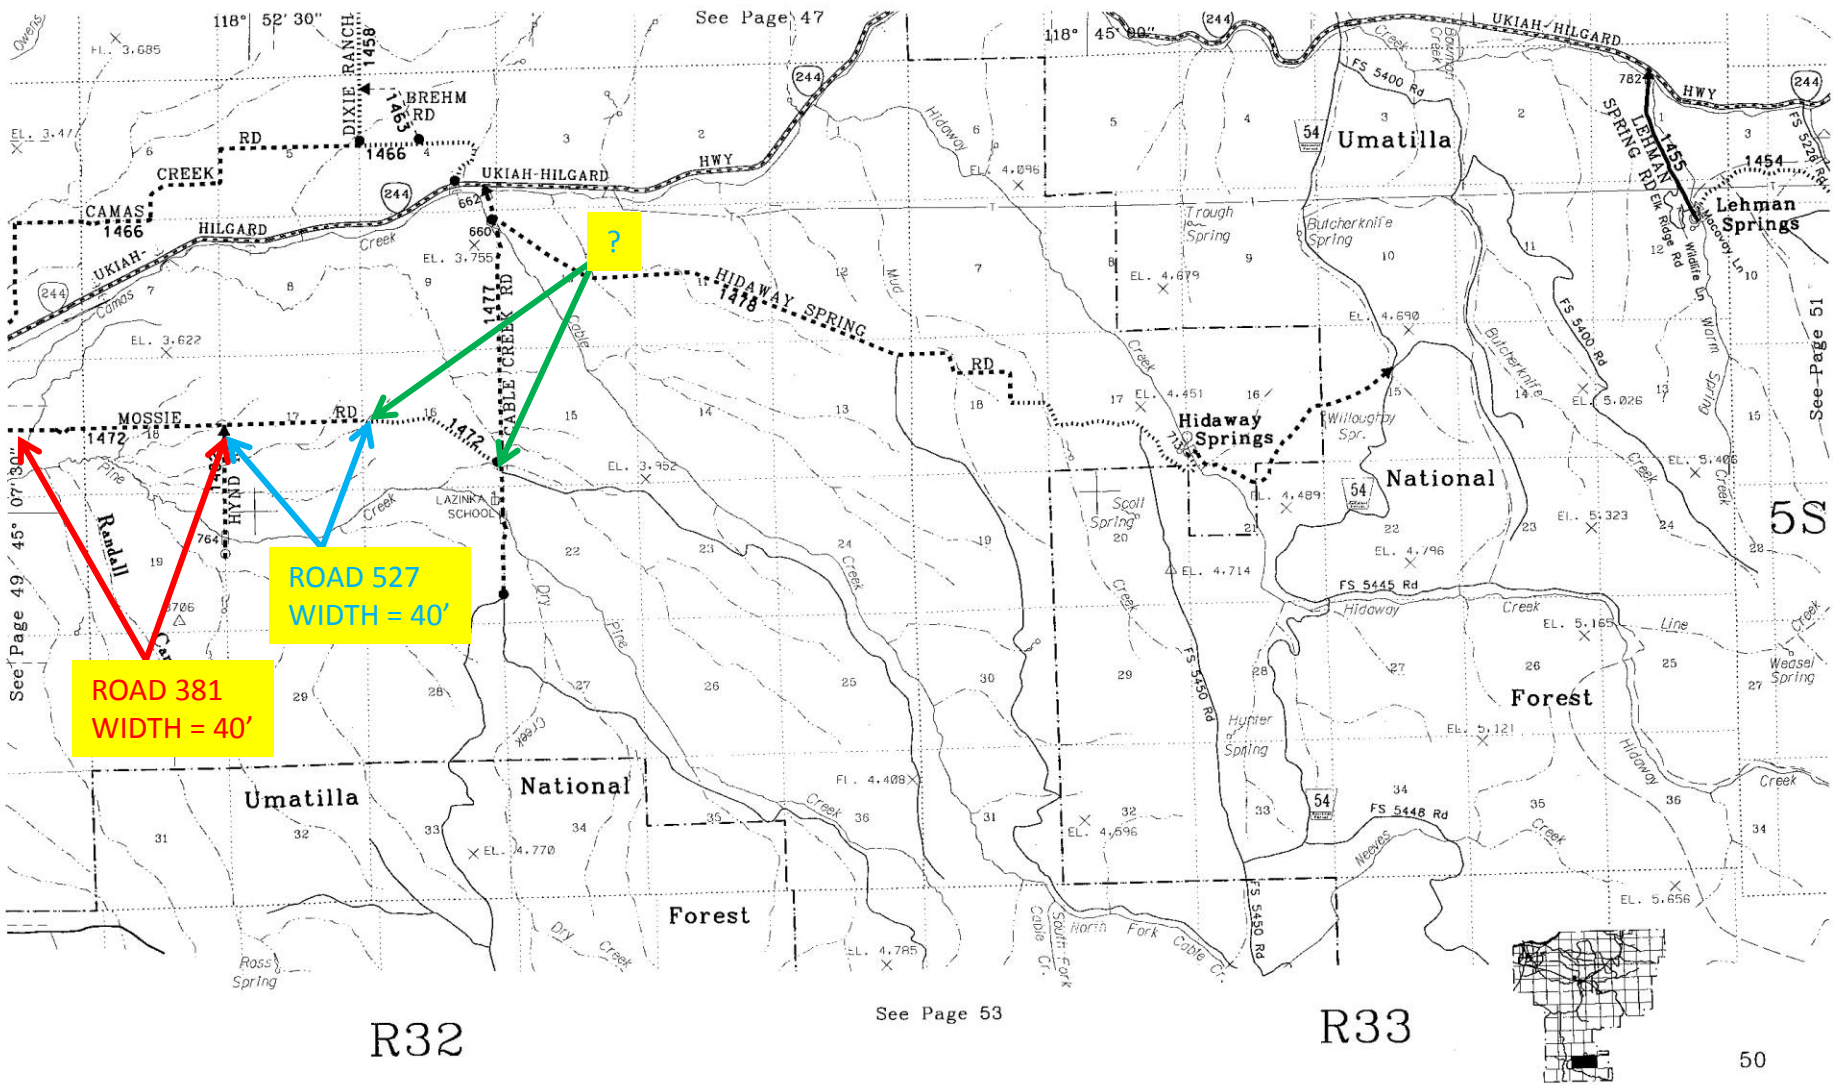

See Page 49 45° 07' 30"

See Page 47

See Page 51

See Page 53