


Bearing Base  
 N 89° 35' 33" E 5324.24 Krumbein Survey Mar 79 Sec. Cor. to Sec. Cor.  
 5324.28 Steebler measure

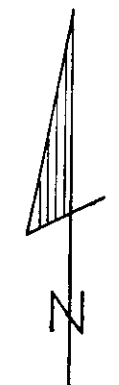

SCALE: 1" = 100'  
 DATE: 9-24-87

**NARRATIVE**

The purpose of this survey is to monument the corners of the lands of the Echo Cemetery Maintenance District. Reference used for the survey are two maps on file in the Co. Surveyor's records No. Q-1056 B and No. S-158. The north line of sec. 16 has a bearing of N 89° 35' 33" E shown on these references and used as a bearing base. I found a brass cap at each of the 2 section corners as shown and a plain unstamped brass cap at the North 1/4 corner of the sec. The north line of the sec. and the brass caps were used for control. Deeds used are as follows:

Book 117	Page 142
" 138	" 148
" 343	" 62
Roll 85	Page 1559
" 85	" 1563
" 85	" 1566

There is an undescribed access easement 20' wide between the 2 canals in Book 343 Page 62-63.

**LEGEND**

- - - - - 5/8" x 30" or larger Iron Pin set and marked R.L.S. 1333
- ⊙ - - - - Brass Cap Found and Used

**REGISTERED PROFESSIONAL LAND SURVEYOR**

*Donald L. Staebler*

OREGON  
 SEPT 23 1977  
**DONALD L. STAEBLER**  
 #1333

T 3 N, R 53 E SEC. 16

**SURVEY FOR**  
 ECHO CEMETERY MAINTENANCE DIST  
 IN THE N. 1/2 OF SECTION 16  
 TOWNSHIP 3 N, RANGE 29 E. W.M.

Scale: 1" = 100' Date: 9-24-87

Donald L. Staebler  
 Engineer - Surveyor  
 1532 SW 41st  
 Pendleton, Oregon 97801

PH 276-7166

9-87  
 RA  
 87-54-A

87-54-A