


Survey for Bob & Judy Hall
 Lot 5, Block 2 of Hat Rock Tracts
 Hermiston, Oregon
 December 5, 1990

NW 1/4 NE 1/4 SECTION 15, T. 5N., R. 29E., W.M.

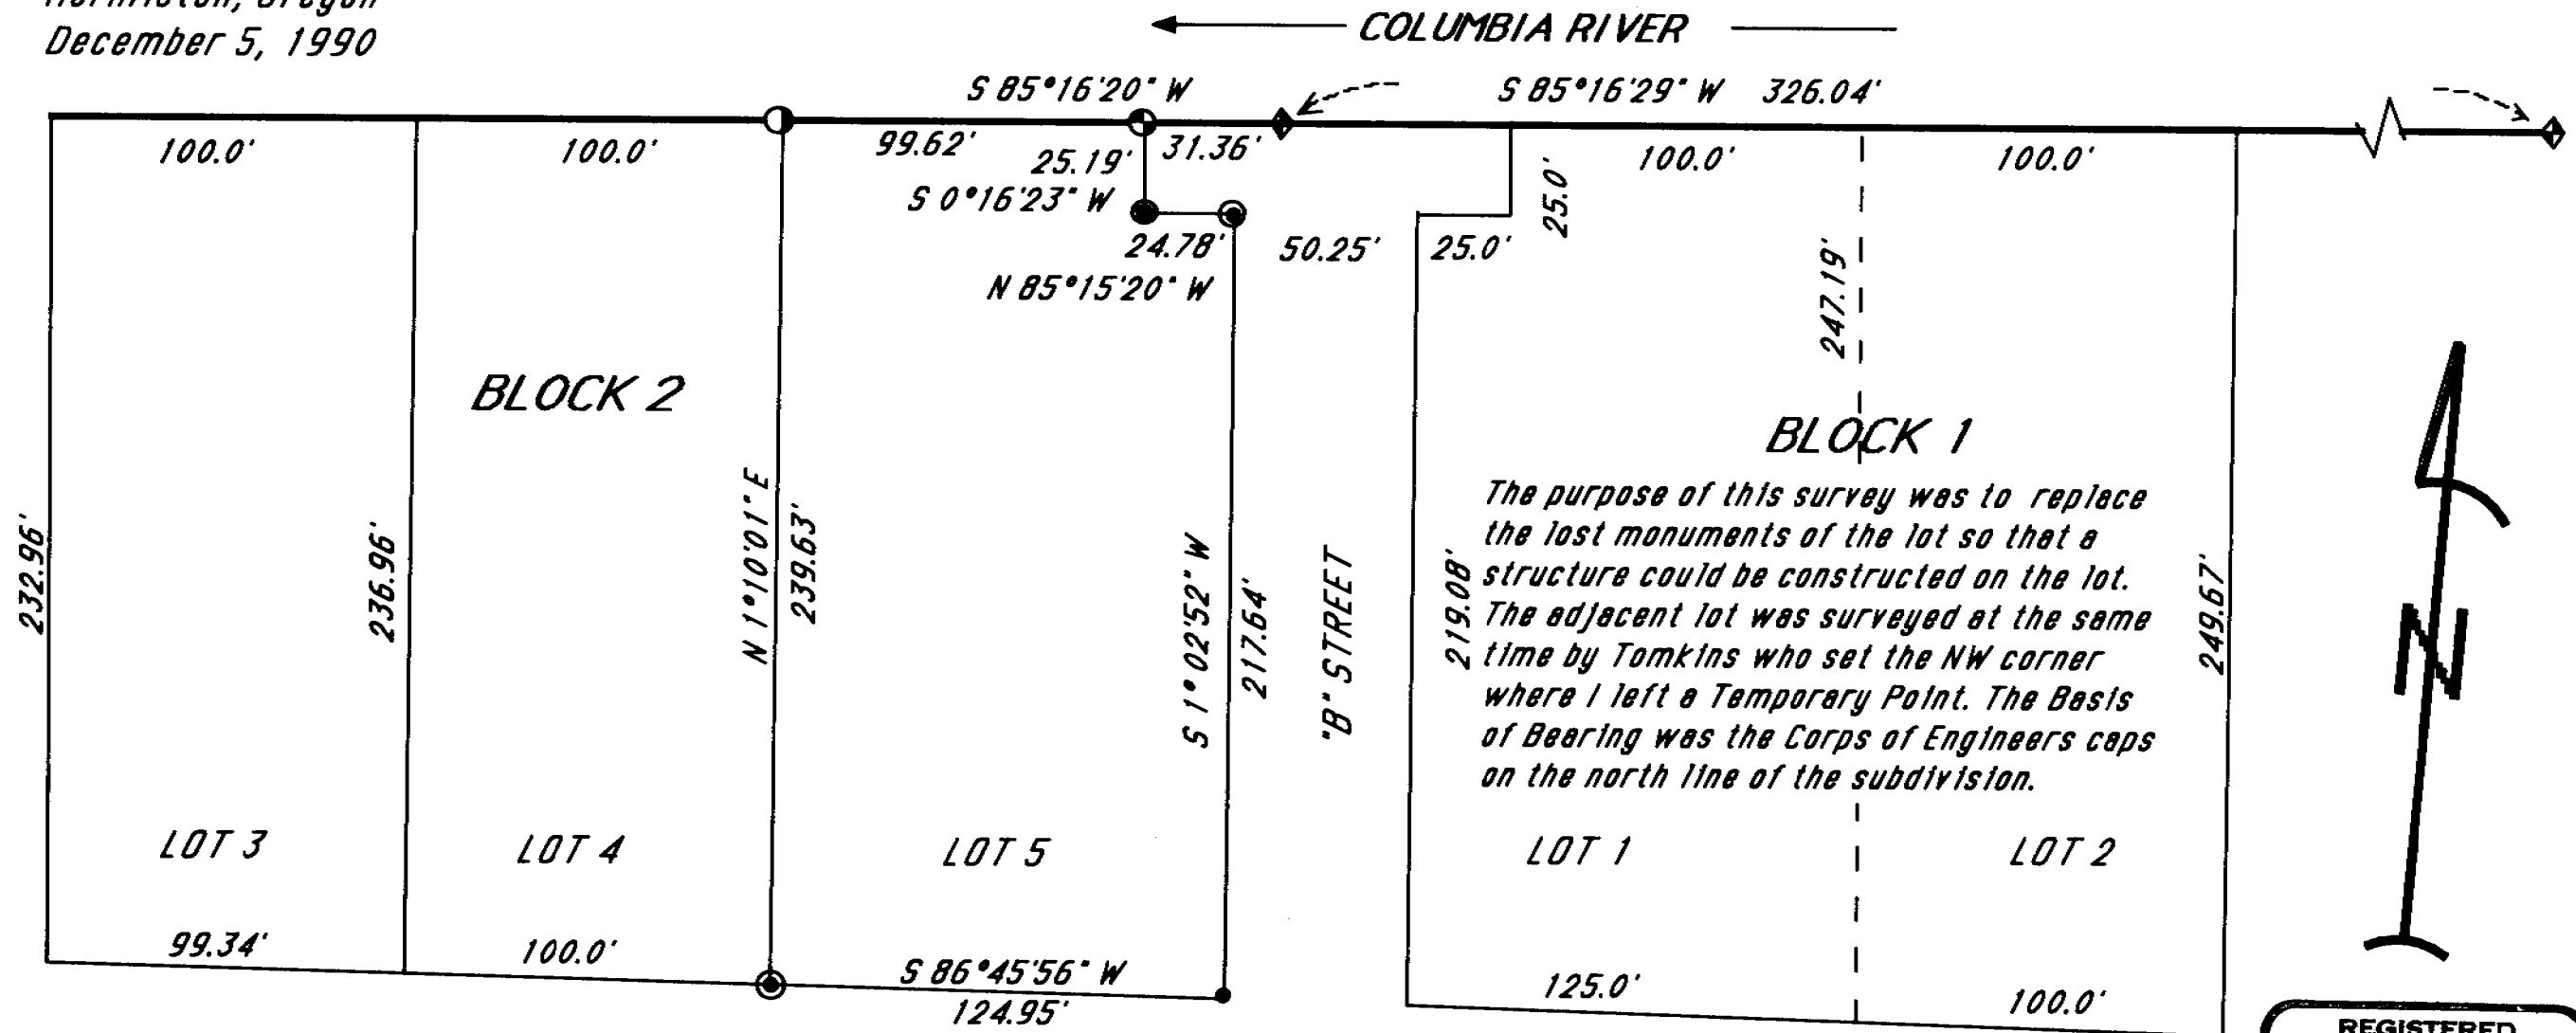

The purpose of this survey was to replace the lost monuments of the lot so that a structure could be constructed on the lot. The adjacent lot was surveyed at the same time by Tomkins who set the NW corner where I left a Temporary Point. The Basis of Bearing was the Corps of Engineers caps on the north line of the subdivision.

SCALE 1" = 50'

RIVER VIEW DRIVE

- ◆ FOUND ALUMINUM CAP - U.S. ARMY CORPS OF ENGINEERS
- FOUND 5/8" REBAR W/ PLASTICK CAP STAMPED - TOMKINS
- FOUND UNMARKED 1/2" IRON ROD
- FOUND UNMARKED 1" IRON PIPE
- SET 5/8" x 30" REBAR W/ PLASTIC CAP STAMPED L.S. #2431

REGISTERED
 PROFESSIONAL
 LAND SURVEYOR

Ronald V. McKinnis

OREGON
 RONALD V. MCKINNIS
 JAN. 23, 1980
 2431

RECEIVED BY
 Umatilla County Surveyor
 Date 5-91
 Rec'd By. KA
 No. 91-35-A

ENGINEERING - SURVEYING - WATER RIGHTS
R V McKinnis Engineering
 Rt 1 Box 1122 Hermiston, Oregon 97838
 (503) 567-2017

91-35-A