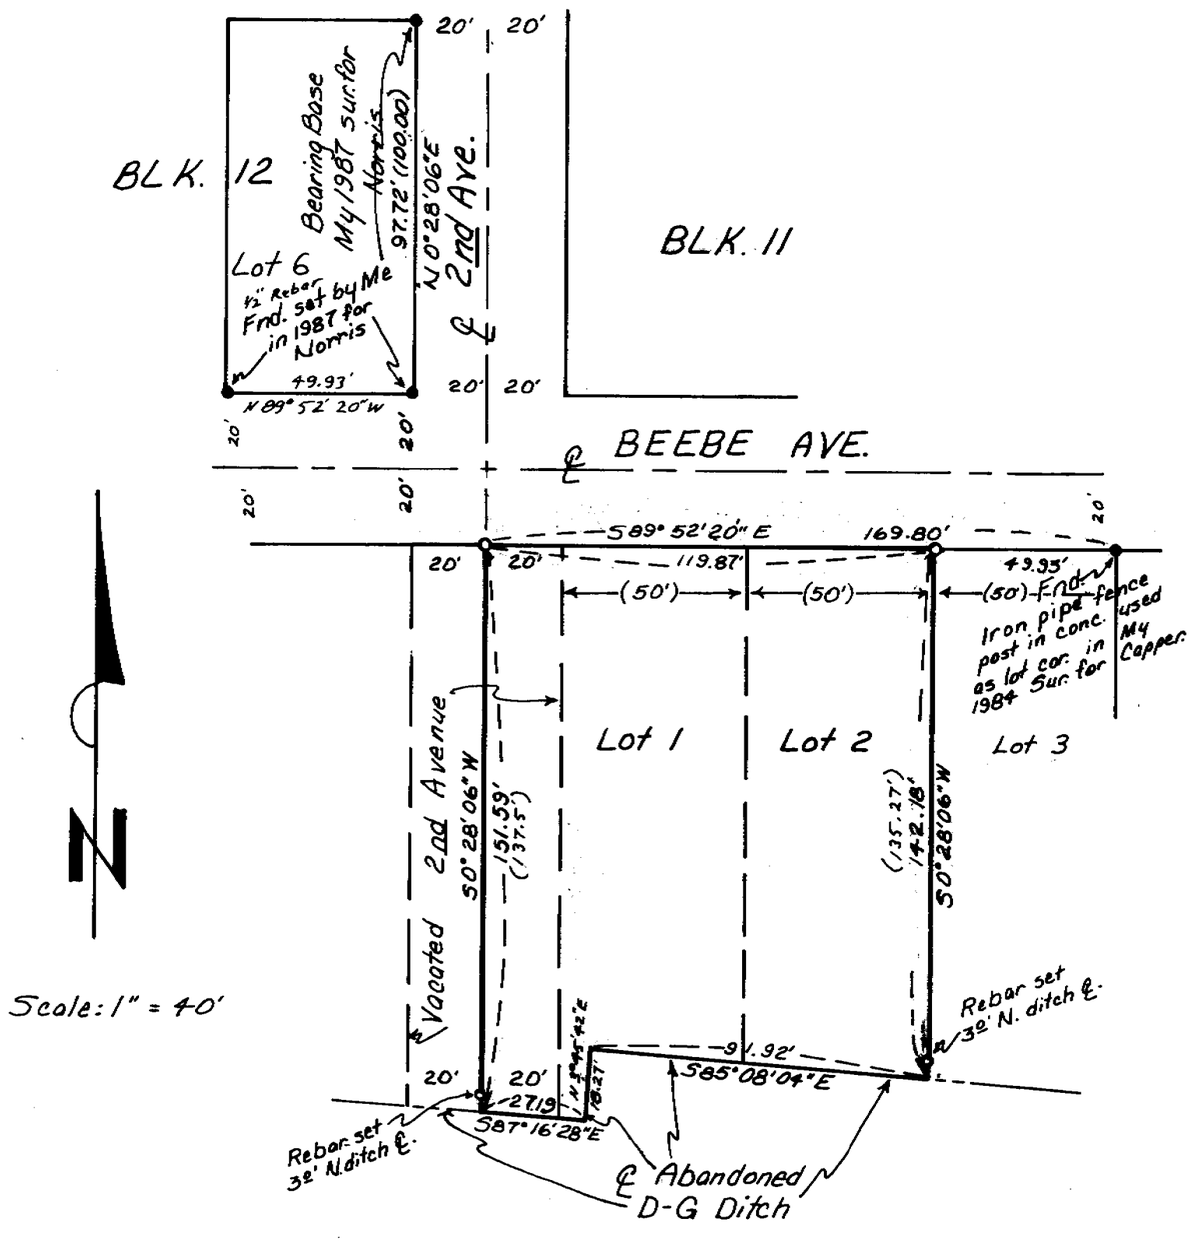

Scale: 1" = 40'

NARRATIVE:

The purpose of this survey is to stake the corners of the following: Lots 1 and 2, BLK. 14, "OSBURN TRACT HOMESITE" and the East half of vacated 2nd Avenue, so a fence can be built.

I have done other surveys in this subdivision and conclude that Criger in the original survey did very sloppy work and set no Iron monuments in 1942. I base my bearings and the survey on one I did for Norris in BLK. 12 in 1987. There is an old fence between Lots 2 and 3 which matches my monuments.

LEGEND:

- ● Monuments found
- o 5/8" x 30" rebar set with Alum. tag "951.
- (ooo) of Record Plat of "OSBURN TRACT HOMESITE"

REGISTERED PROFESSIONAL LAND SURVEYOR

G. Dennis Edwards

OREGON
JULY 16, 1971
G. DENNIS EDWARDS
951

RECEIVED BY
Umatilla County Surveyor
Date 2-91
Rec'd By KK
No. 91-5-1-A

SURVEY FOR DAVID NAHOL
In BLK. 14, "OSBURN TRACT HOMESITE"
City of Hermiston, In NE ¼ NE ¼
Sec. 10, T4N, R28E, W.M.
Umatilla County, Oregon
3/25/91 Job# 59103012
Edwards Surveying P.O. Box 763
567-3336 Hermiston, Oregon 97838

91-5-1-A