

- FOUND PK NAIL. STAEBLER 1977
- SET 5/8" X 30" REBAR WITH PLASTIC CAP # 951
- SET CARPENTERS NAIL IN R/R TIE

SURVEYORS NARRATIVE:

THE PURPOSE OF THIS SURVEY IS TO STAKE THE CORNERS OF LOT 1, BLOCK 3, "CONFORTH'S FIRST ADDITION" SO A HOME CAN BE SITED AND A FENCE BUILT.
 I COULD NOT FIND ANY OF THE ORIGINAL MONUMENTS WHICH WERE SET BY STAEBLER IN 1977.
 I DID FIND HIS CENTERLINE MONUMENTS AND USED THOSE TO RETRACE LOT 1.



REGISTERED
PROFESSIONAL
LAND SURVEYOR

G. Dennis Edwards


OREGON
JULY 16, 1971
G. DENNIS EDWARDS
951

RENEWS 12/31/95

	ARC LENGTH	CHORD LENGTH	CHORD BEARING	RADIUS	DELTA	TANGENT
A	15.71	14.14	S 30°22'28"W	10.00	90°	10.00
B	75.16	75.00	S 21°09'12"E	330.00	13°03'00"	37.74
C	241.31	236.82	S 33°49'49"E	360.00	38°24'22"	125.39

RECEIVED BY
Umatilla County Surveyor
Date 9-95
Rec'd by KK
No. 95-138-BA

SURVEY FOR:
WILLFORD HOOLEY
LOT 1, BLOCK 3 CONFORTH'S FIRST ADDITION TO THE CITY OF UMATILLA, AS LOCATED IN THE NW 1/4 OF SEC 20, T 5 N, R 28 E, WM., UMATILLA COUNTY, OREGON
EDWARDS SURVEYING JOB NO. S9508111
P.O. BOX 763 8/16/95
HERMISTON, OR. 97838 503-567-3336

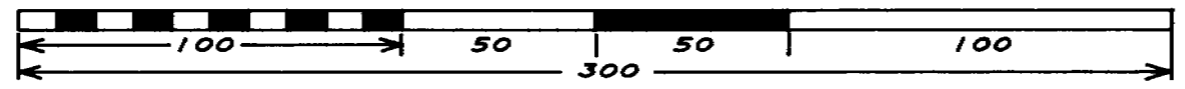

95-138-A